
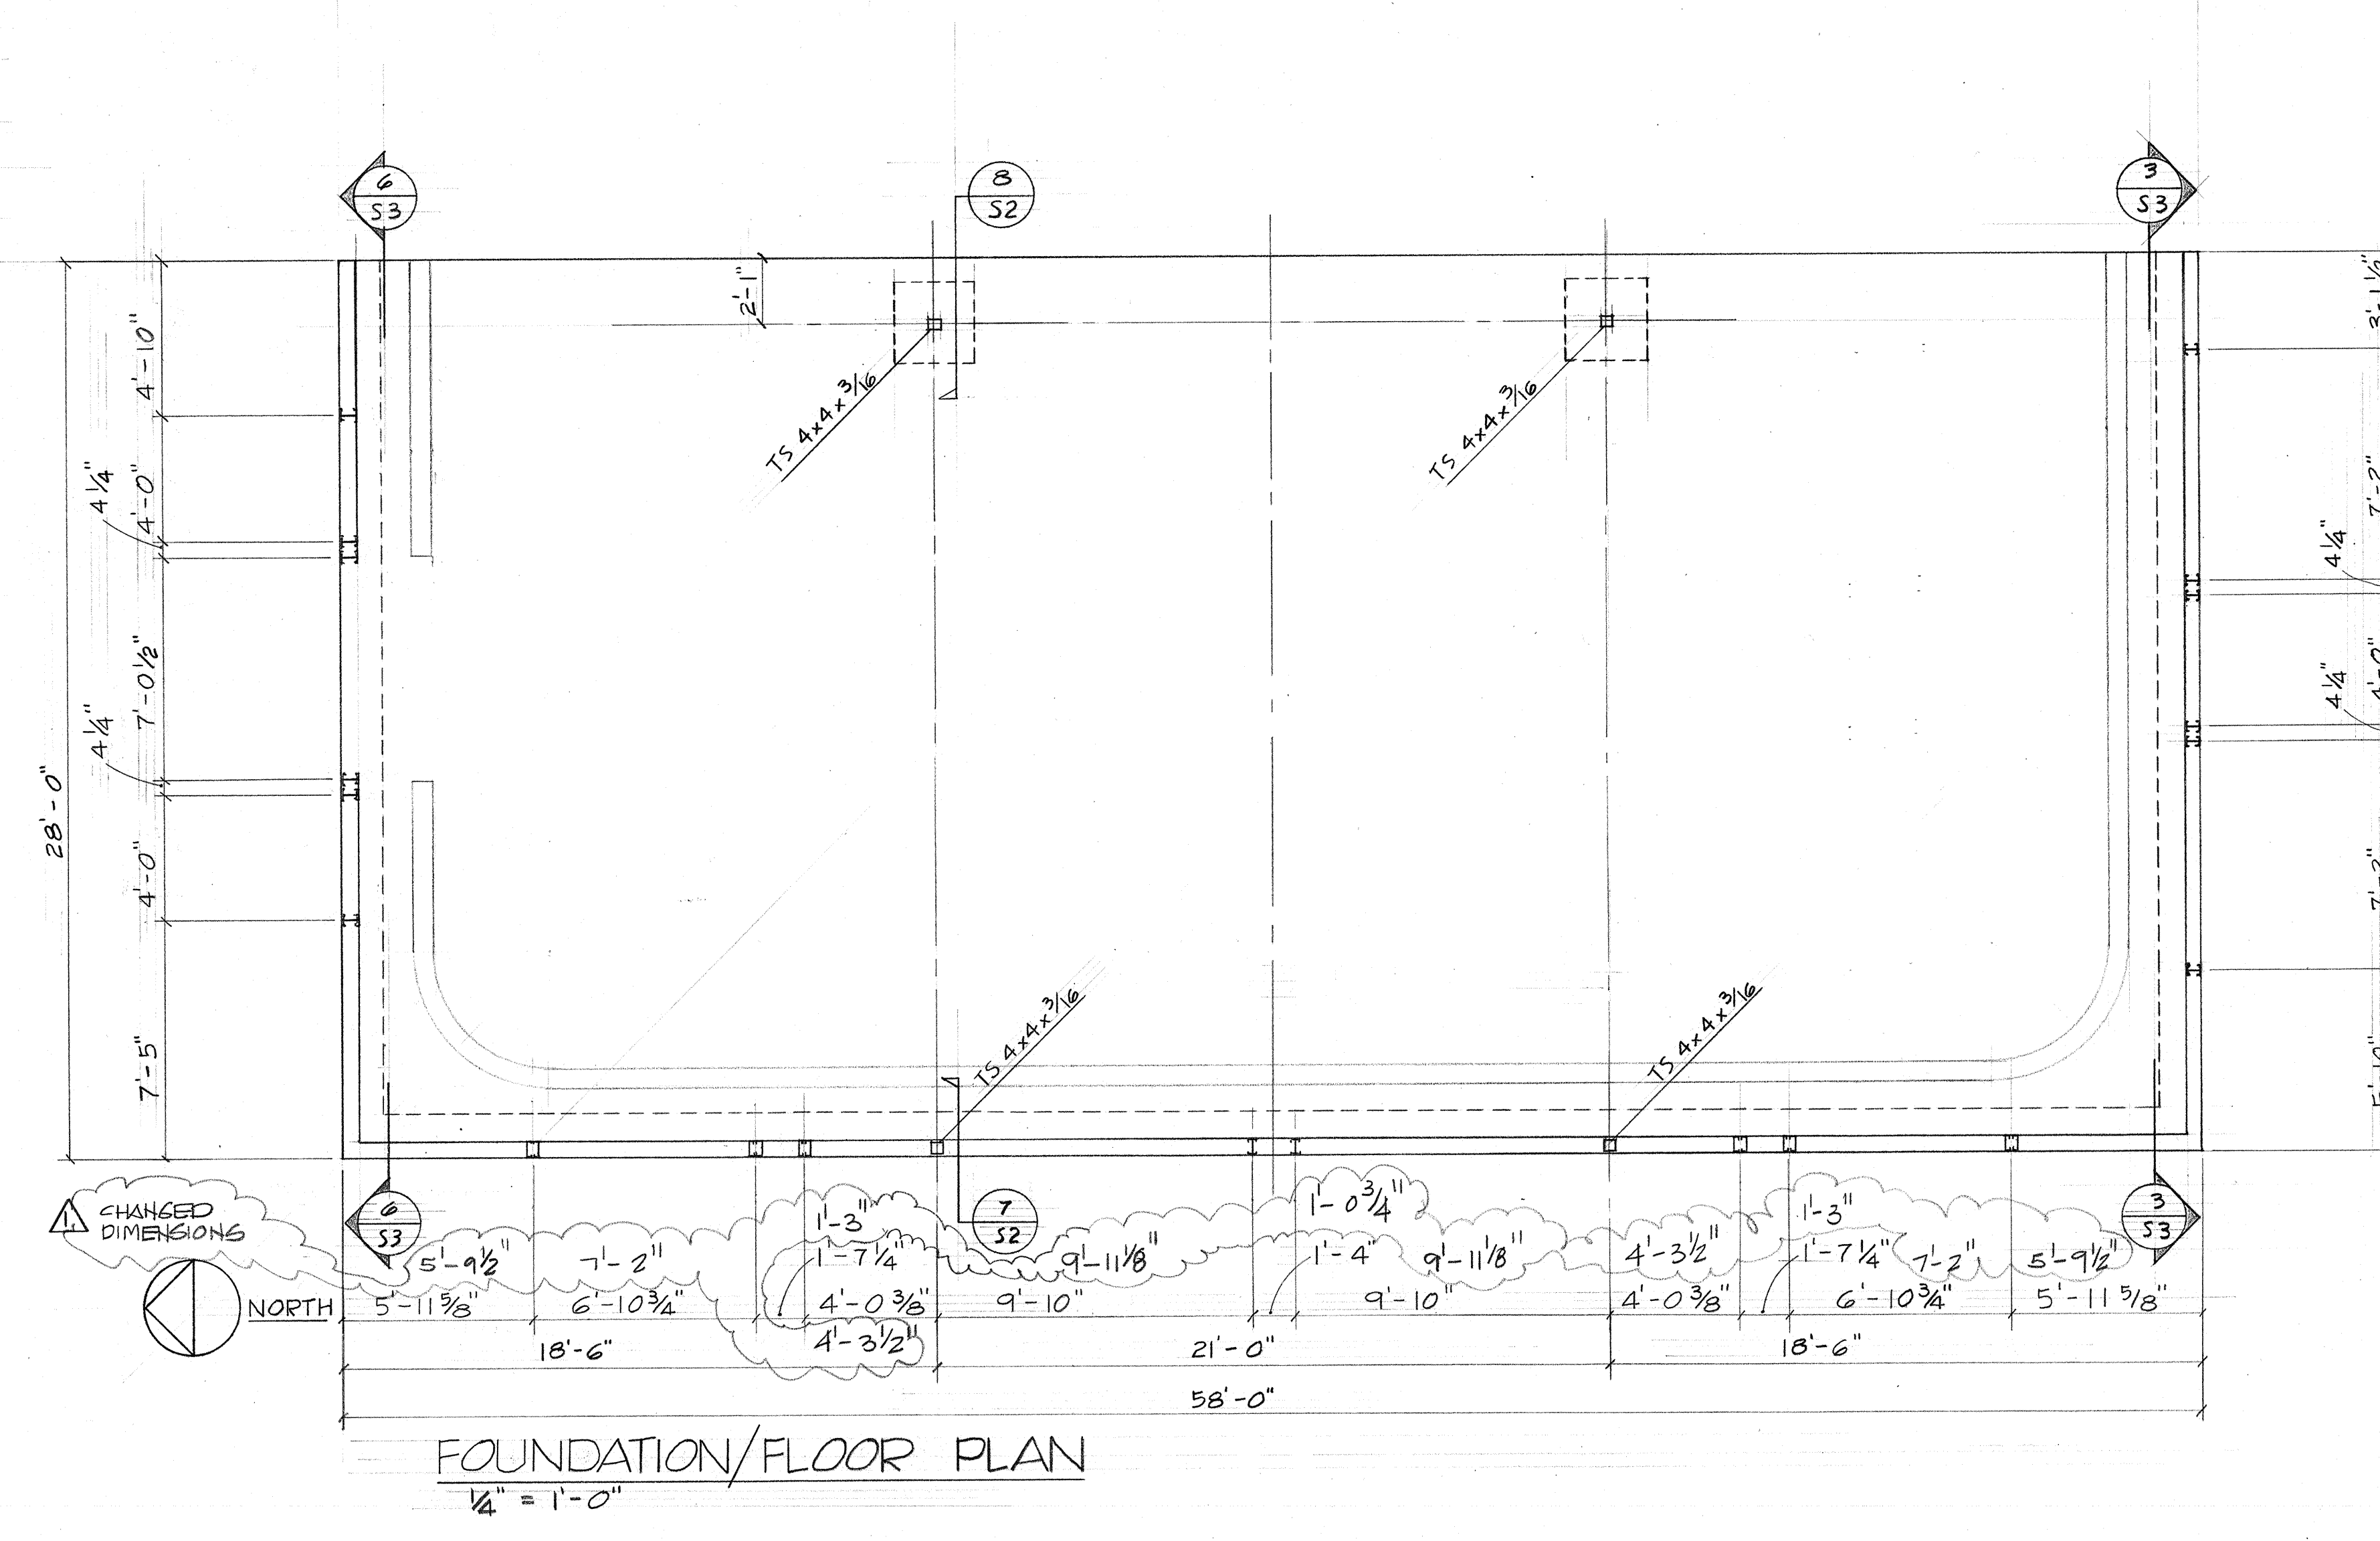
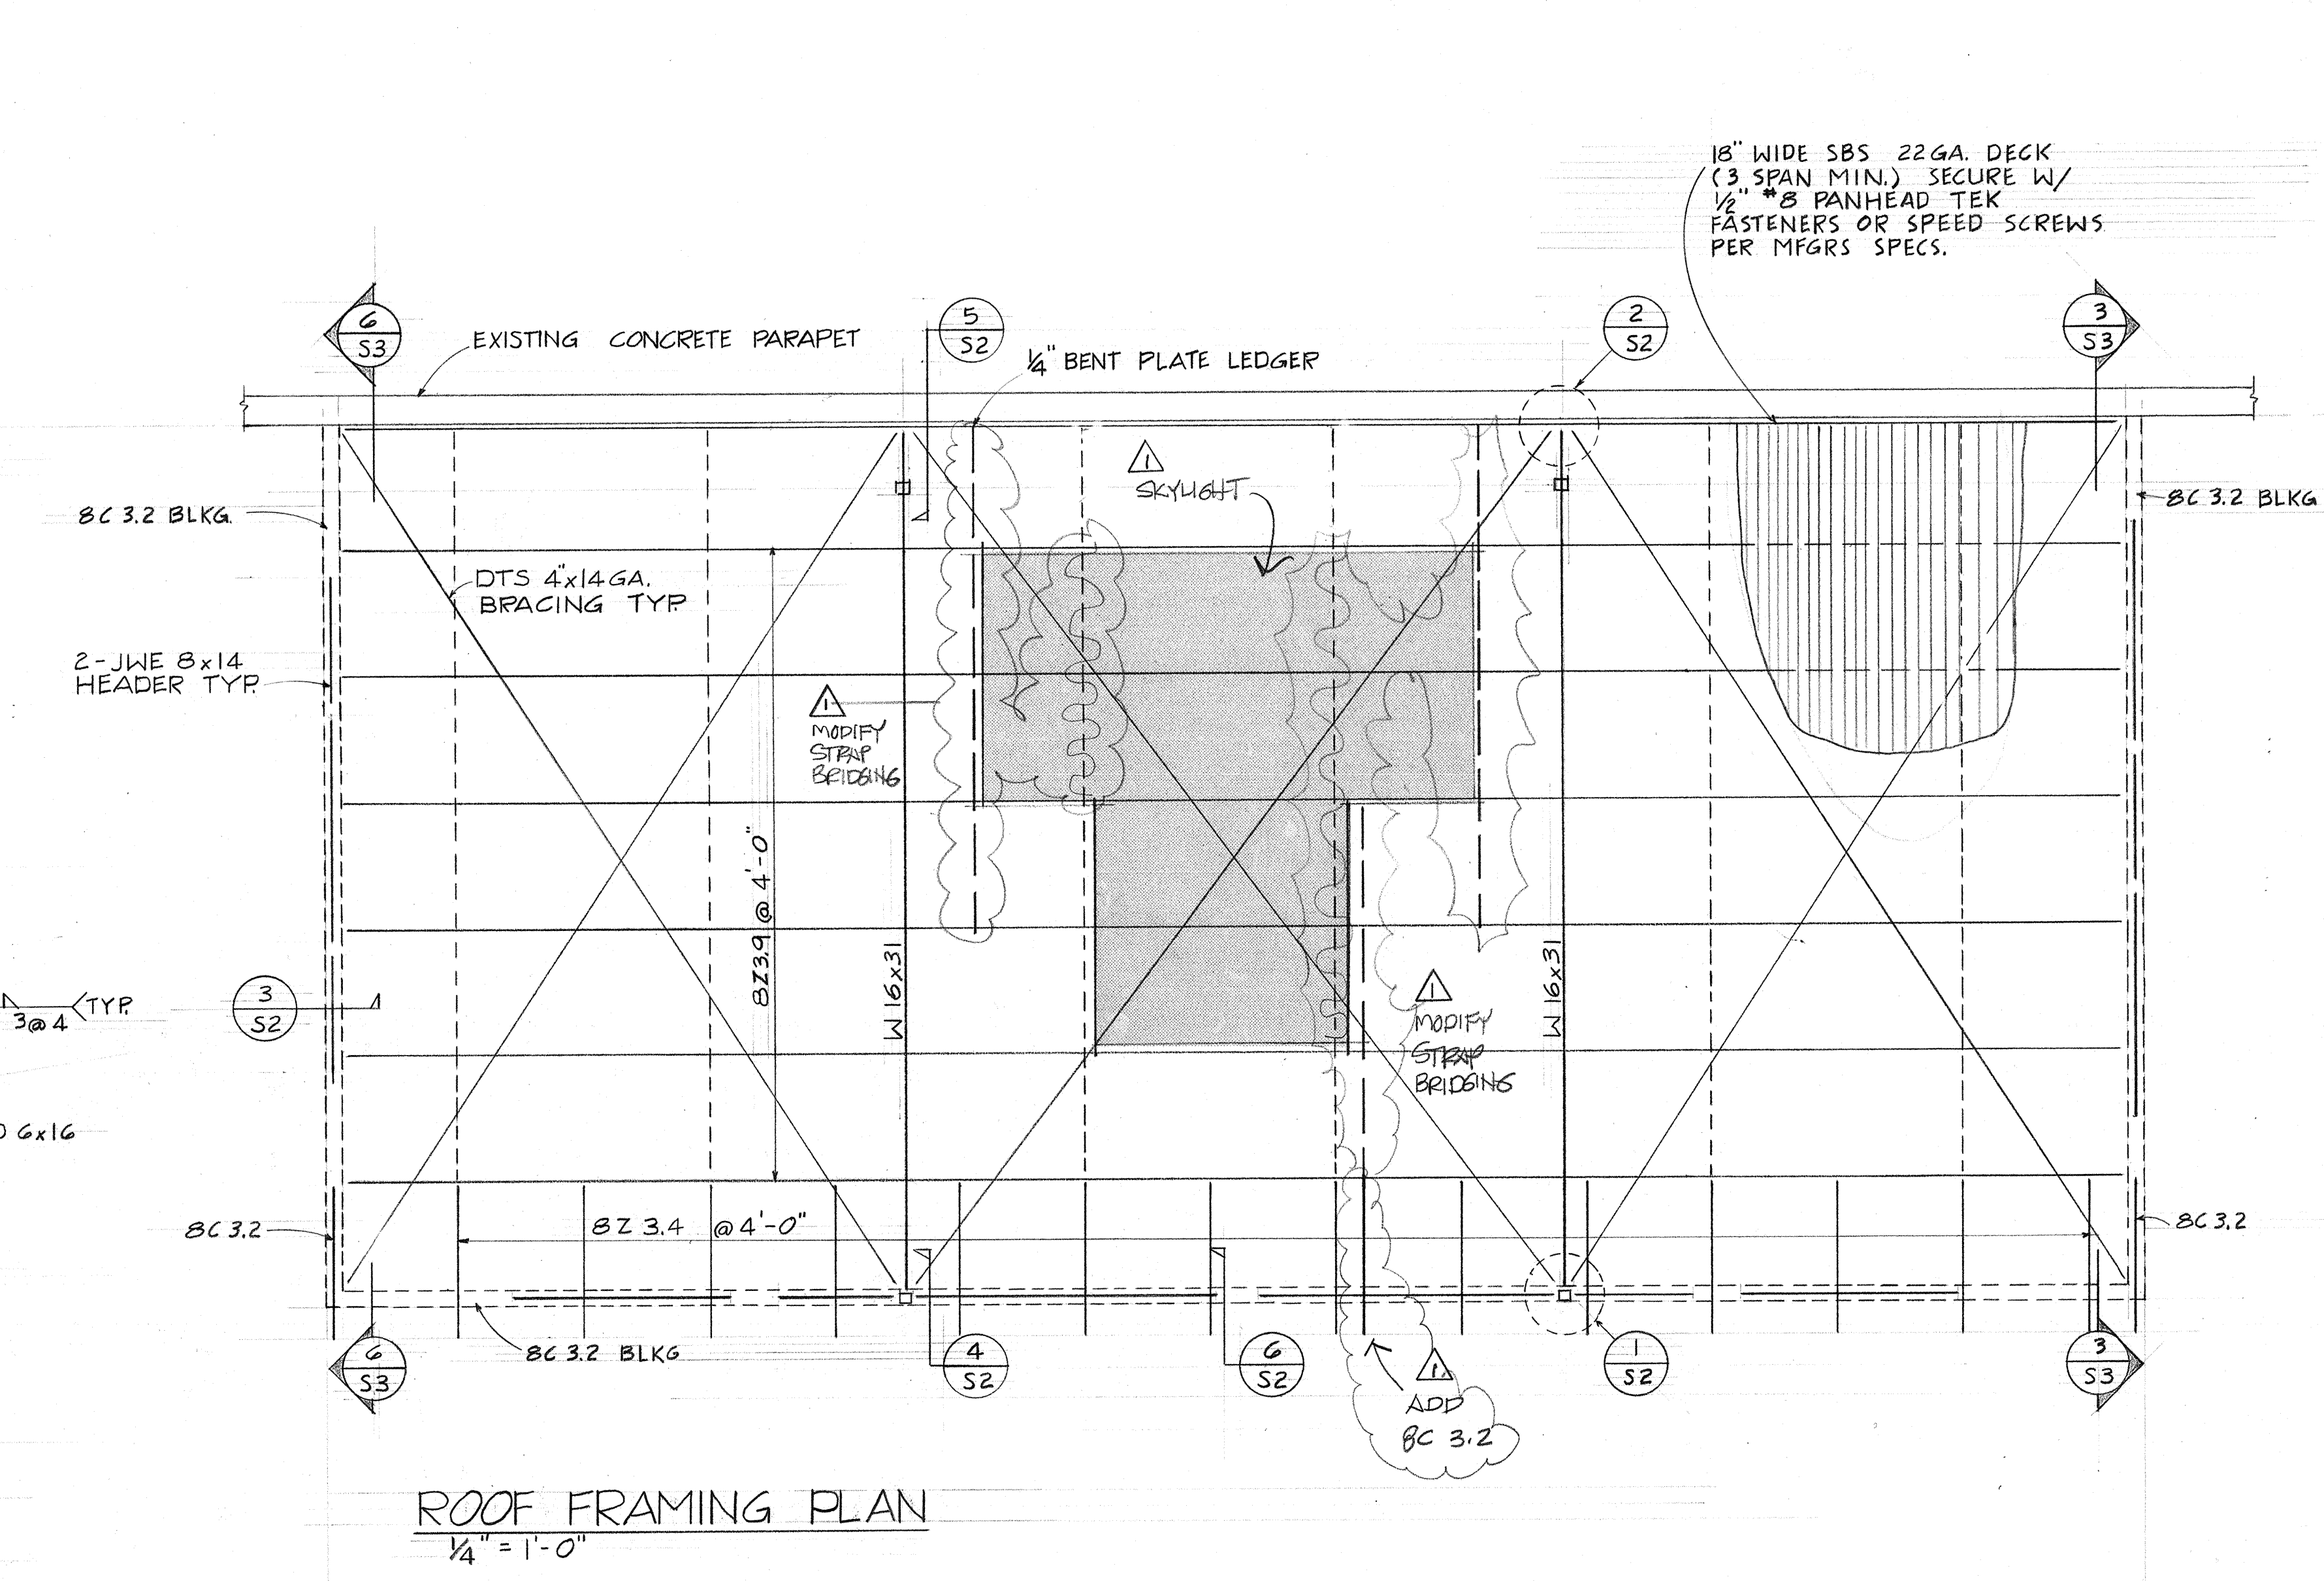
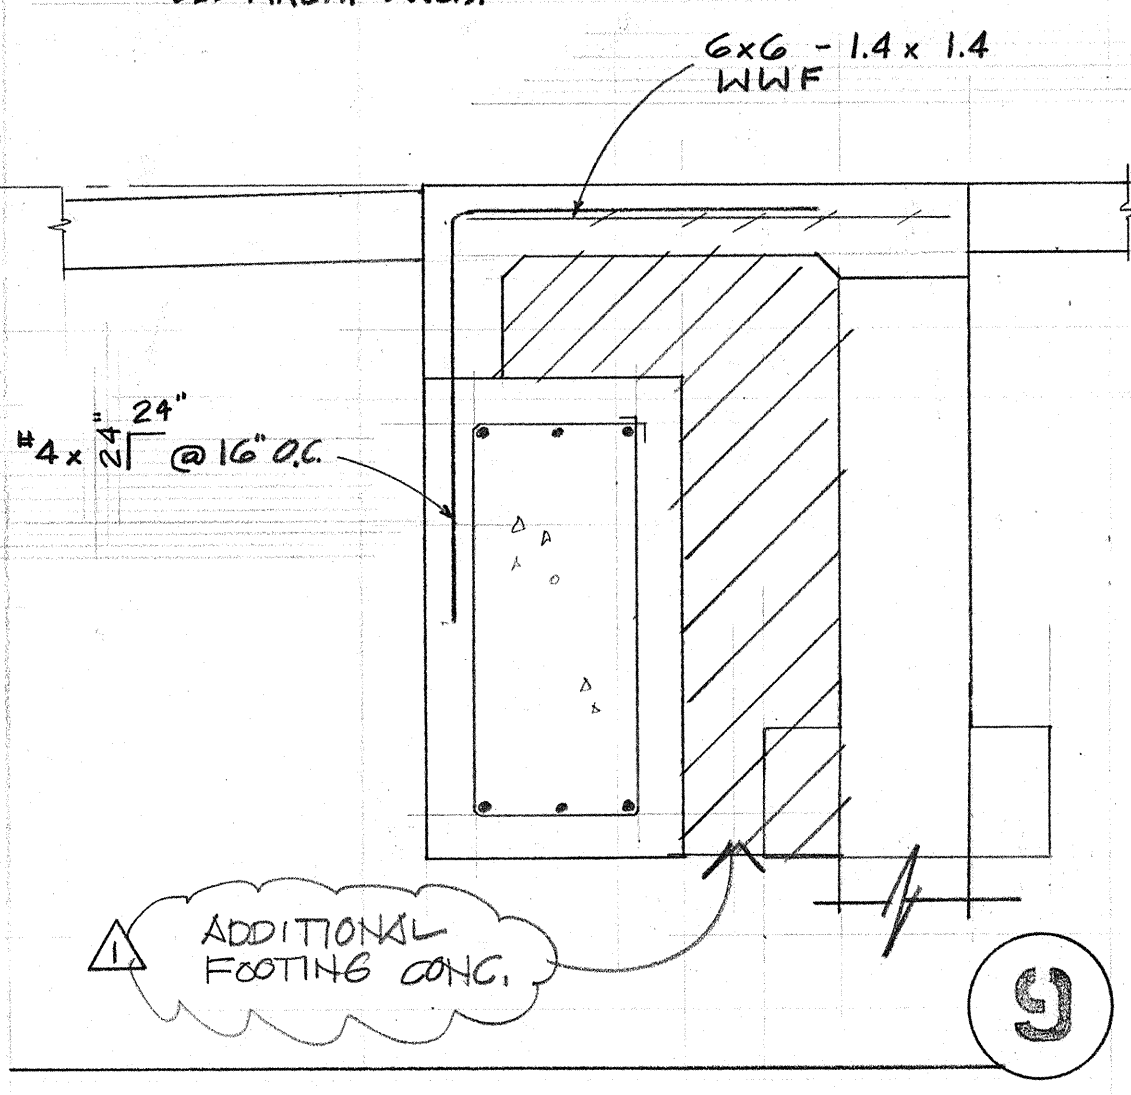
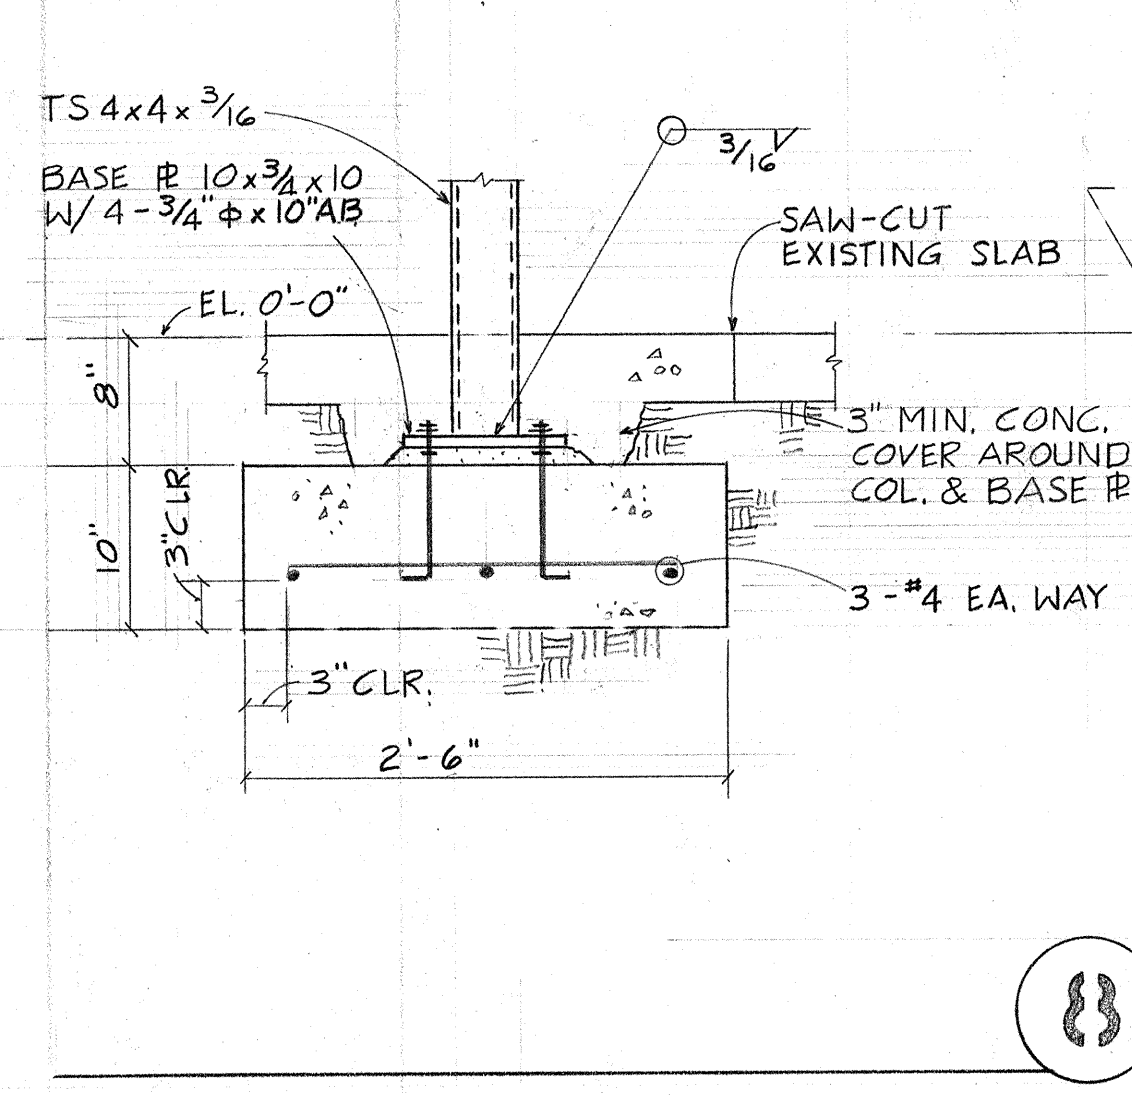
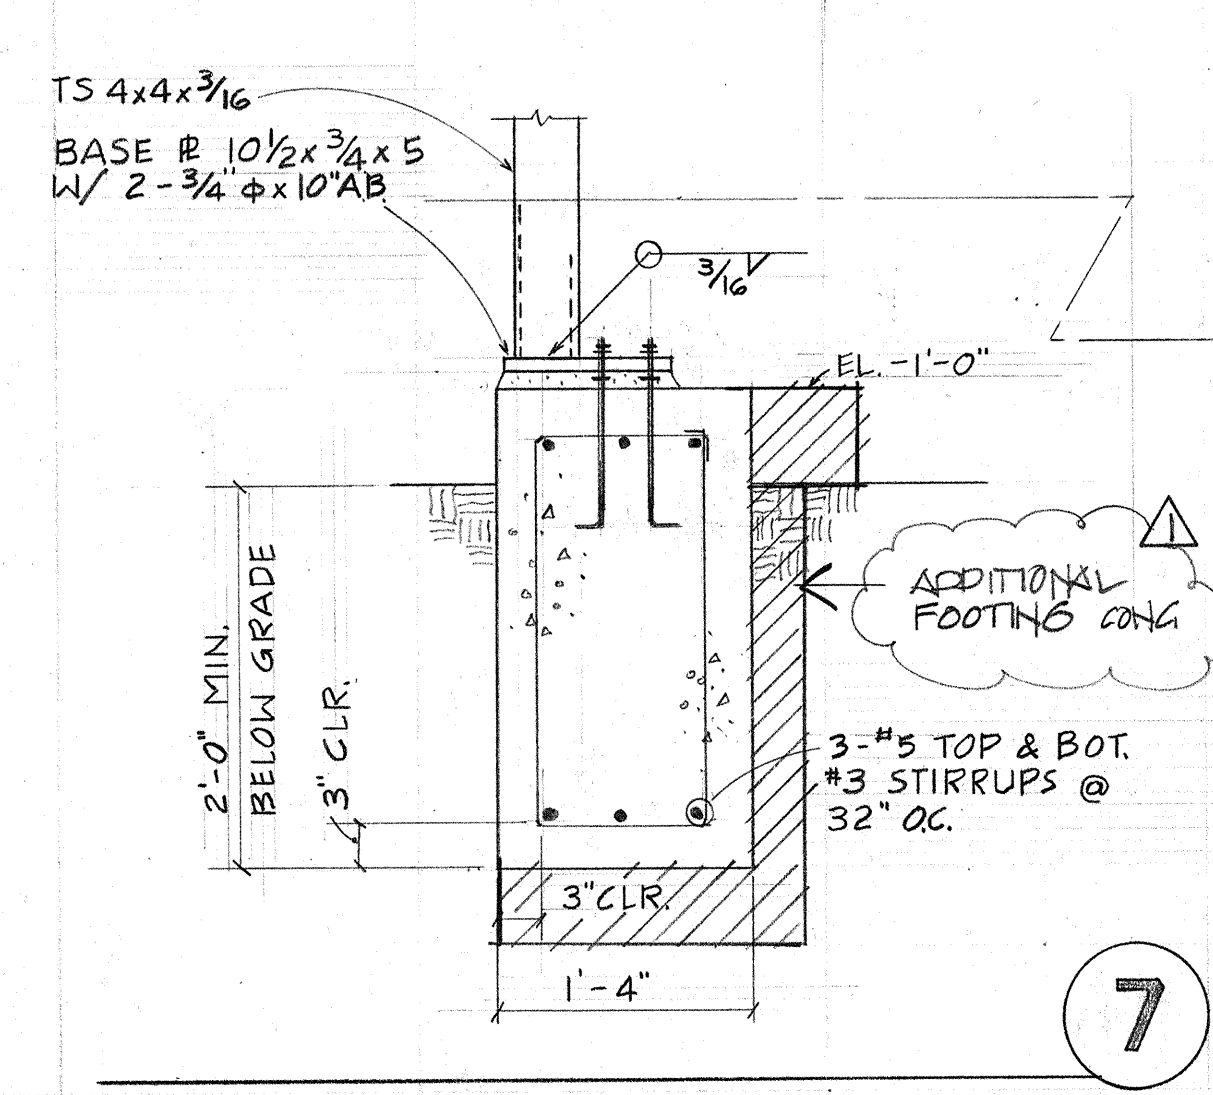
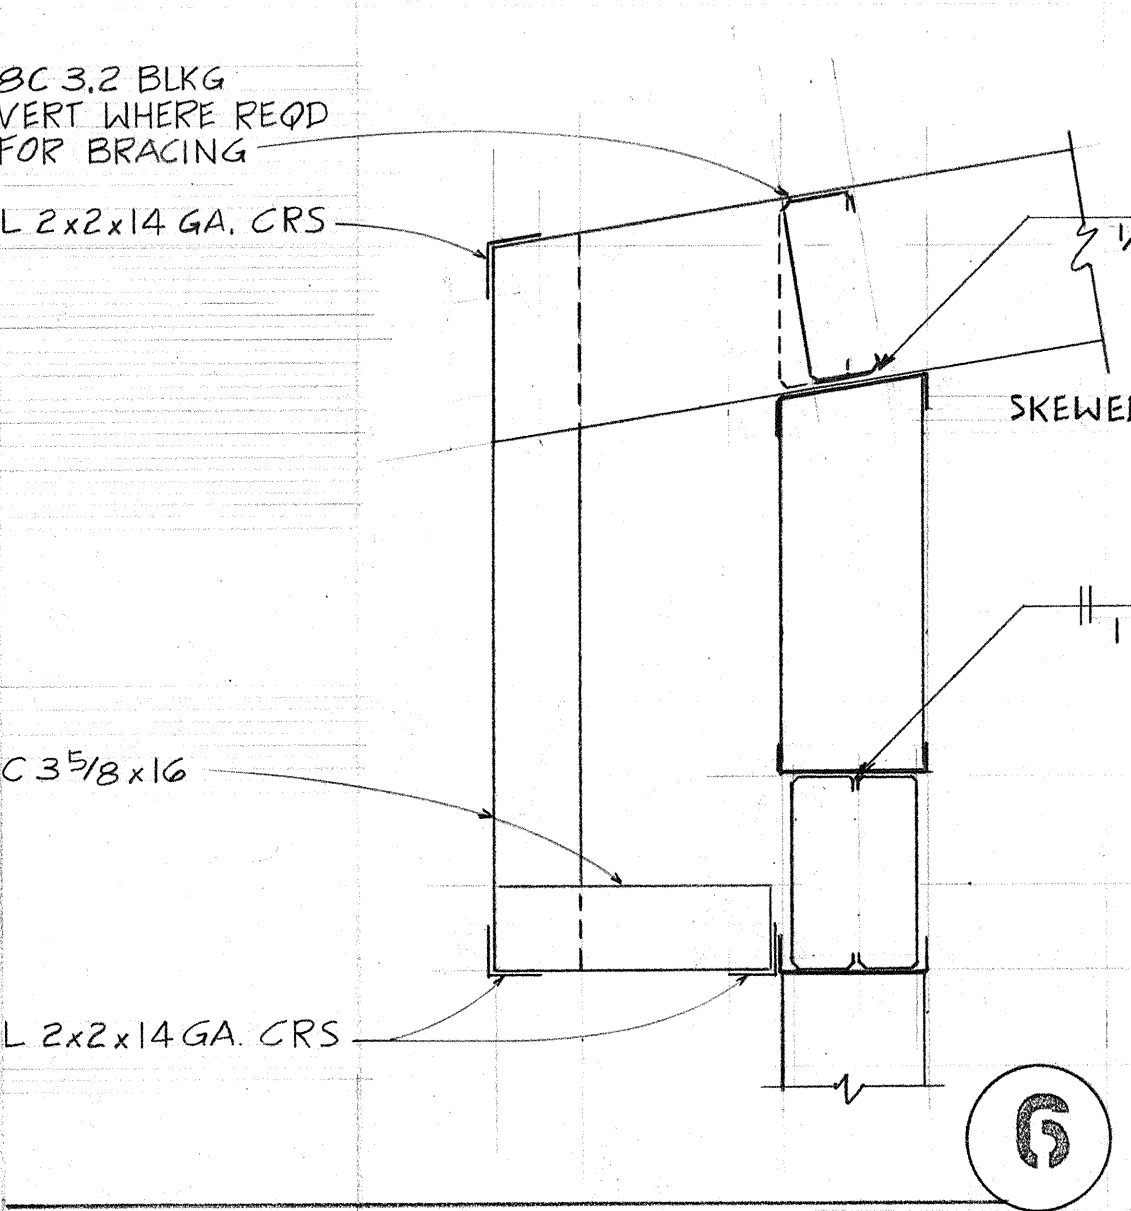
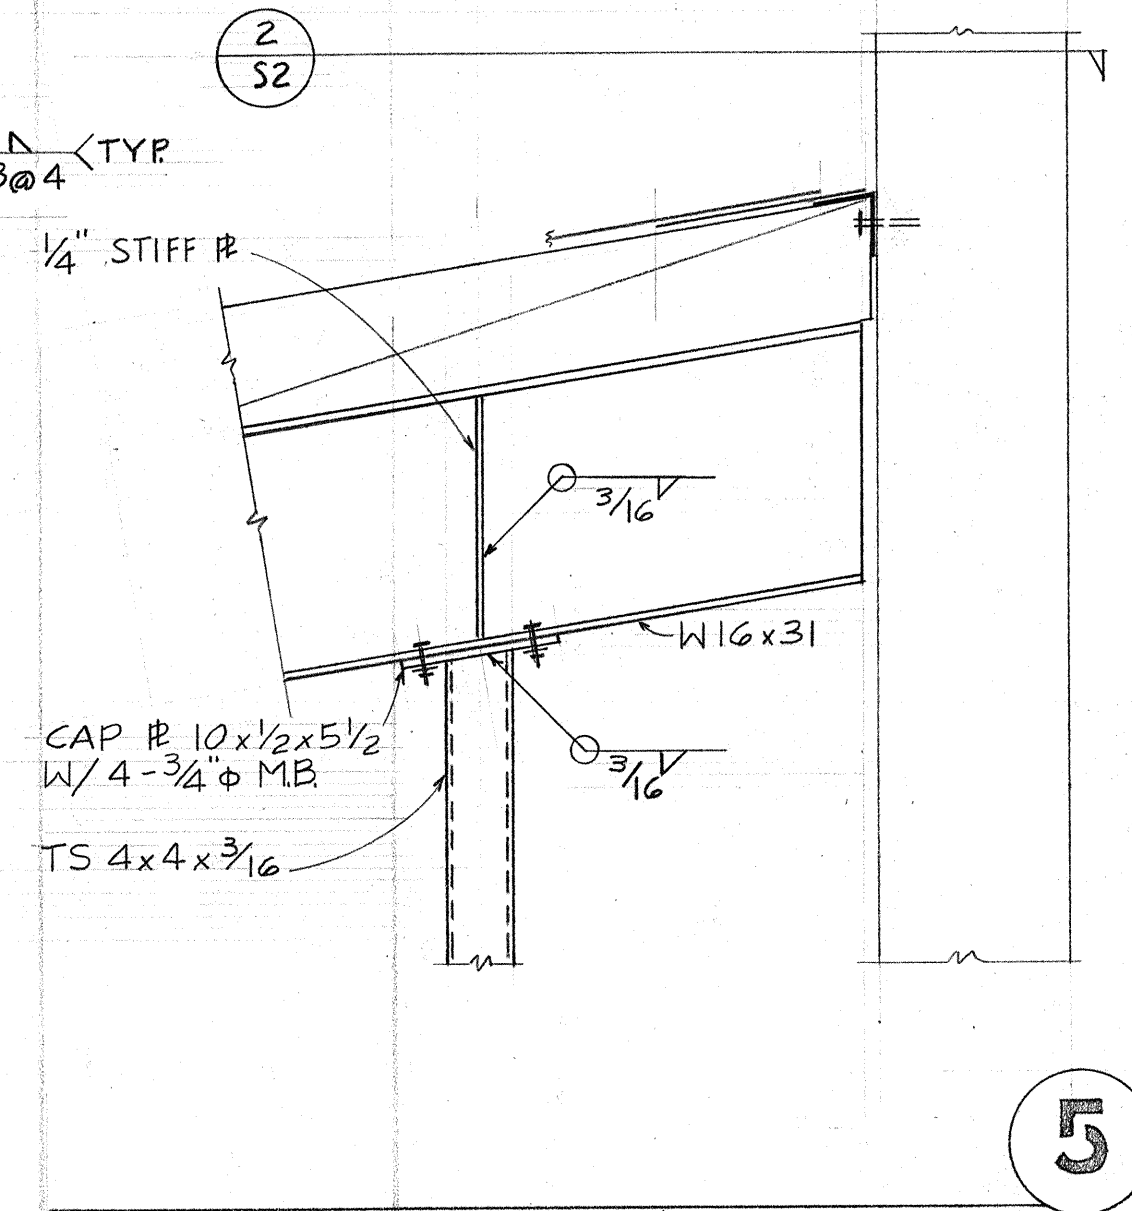
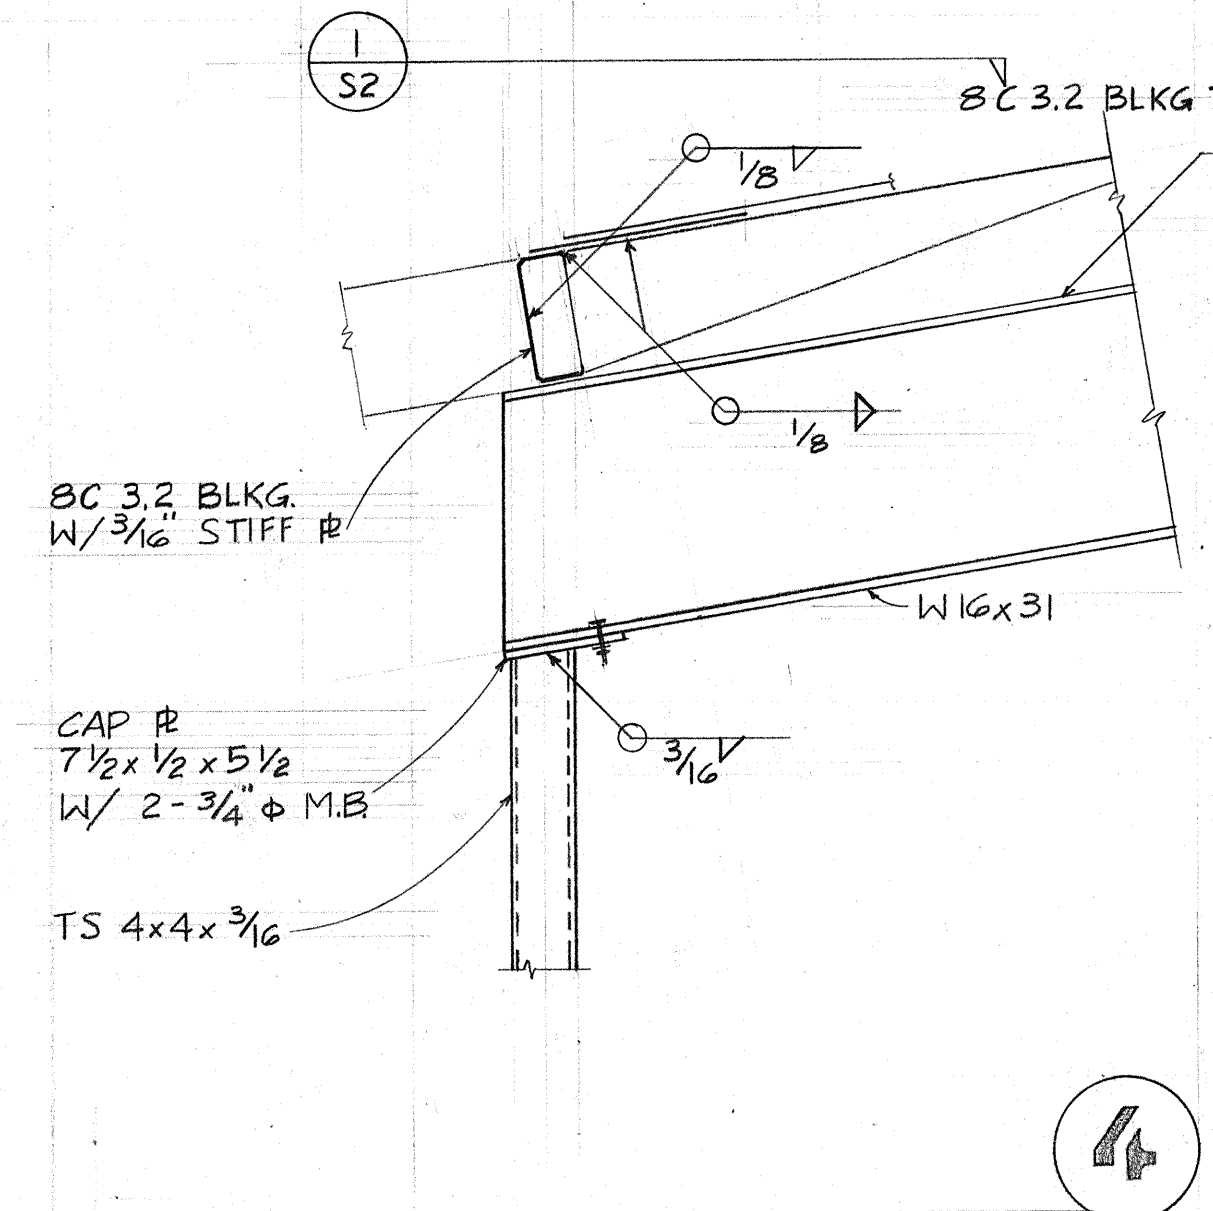
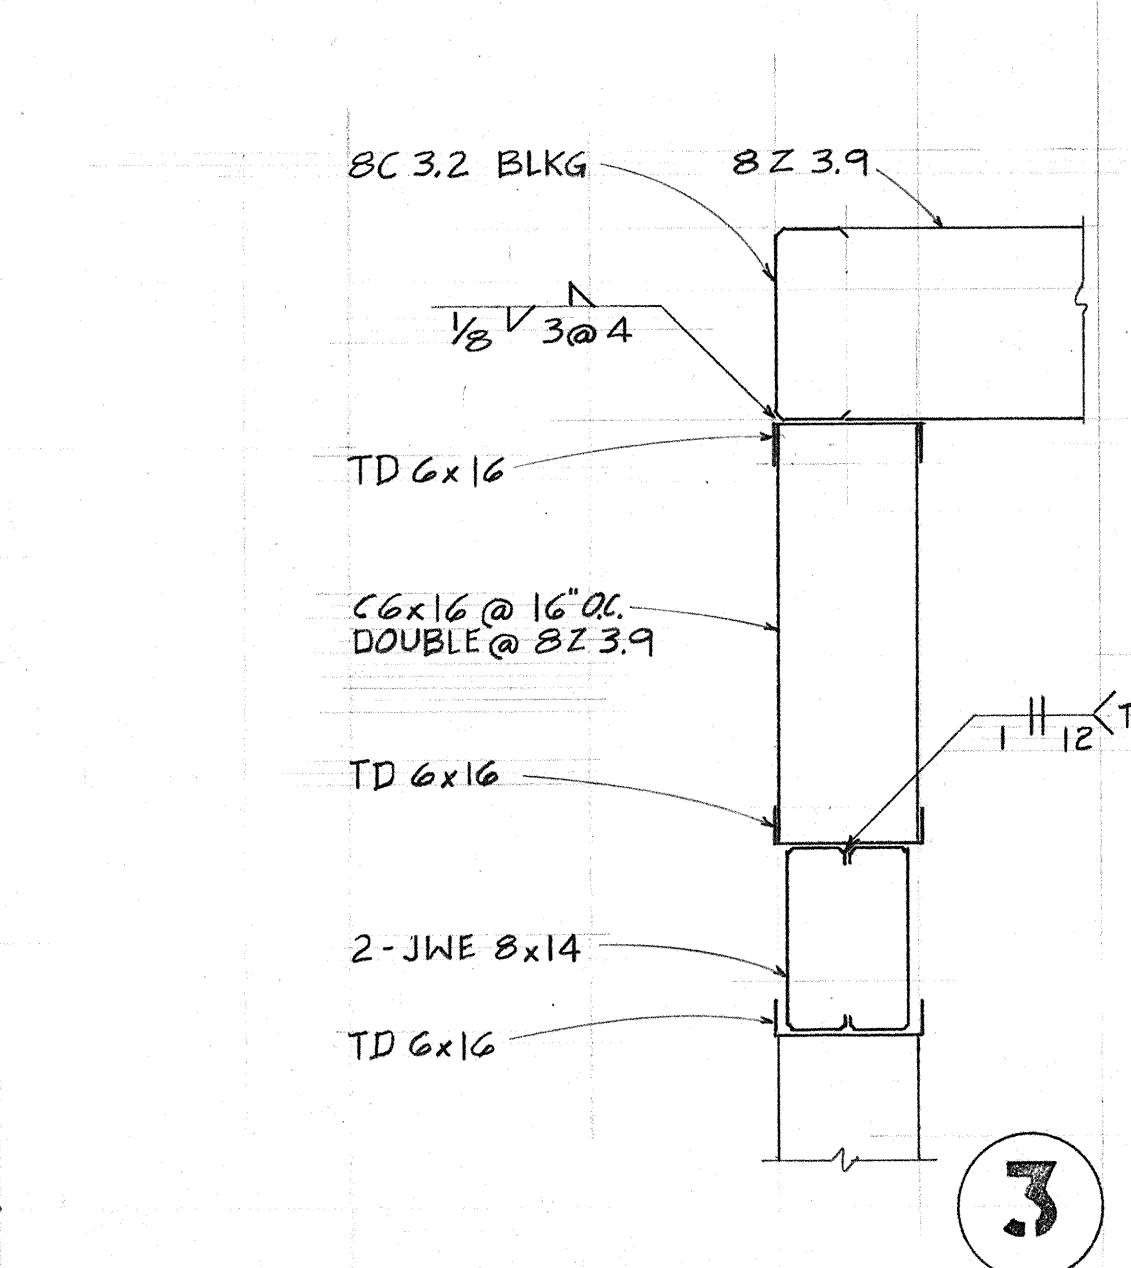
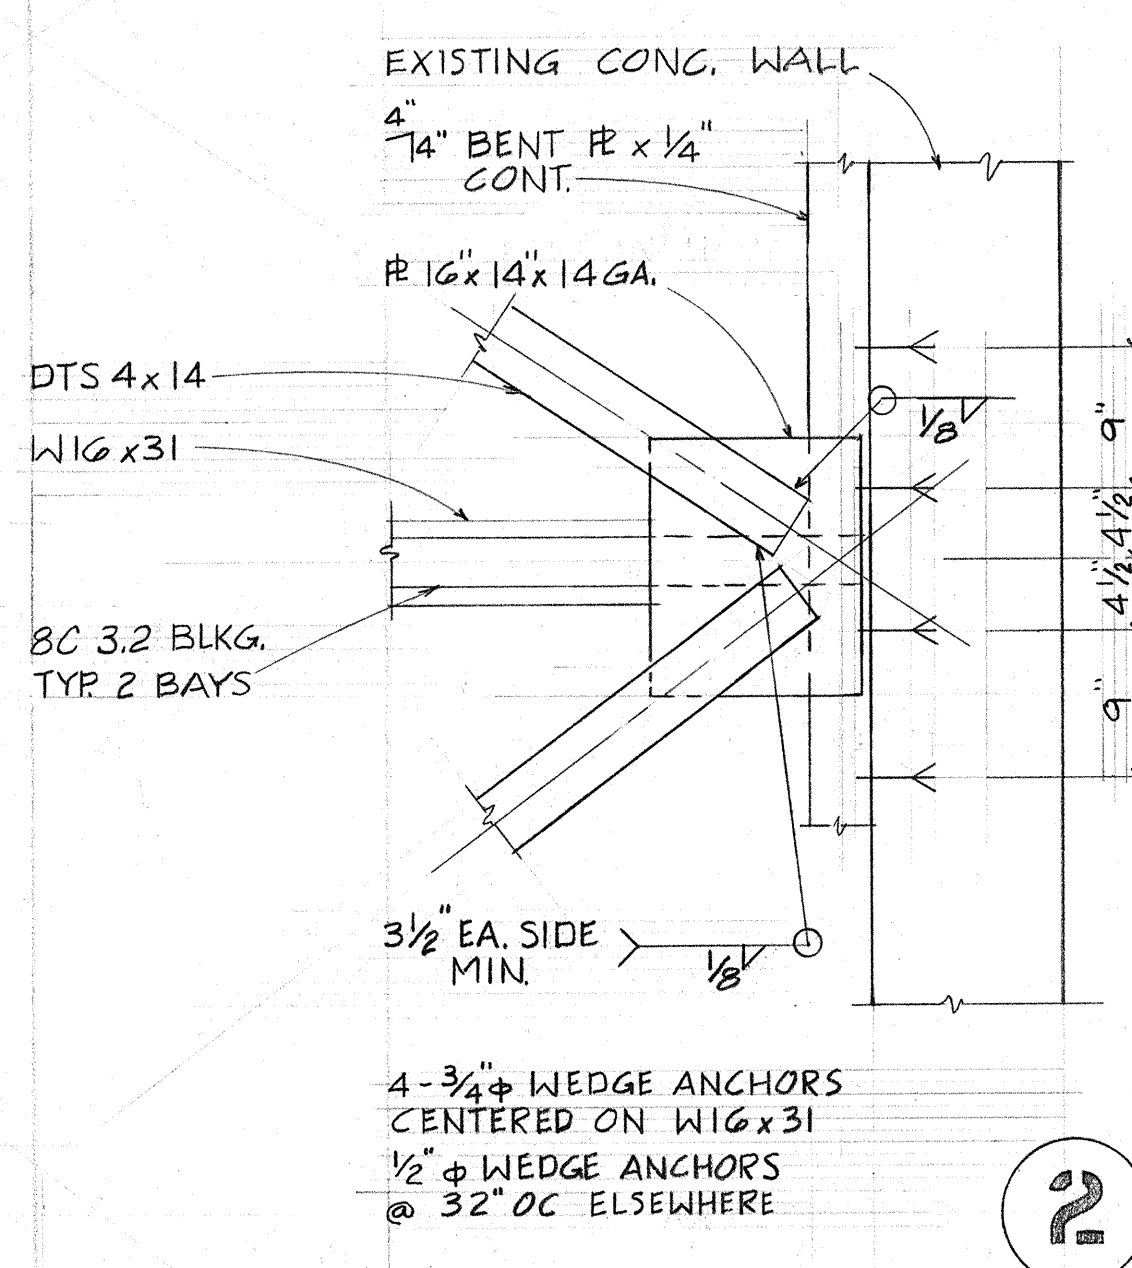


three inches = one foot
one and one-half inches = one foot
one inch = one foot
three-quarters inch = one foot
one-half inch = one foot
three-eighths inch = one foot
one-quarter inch = one foot
one-eighth inch = one foot

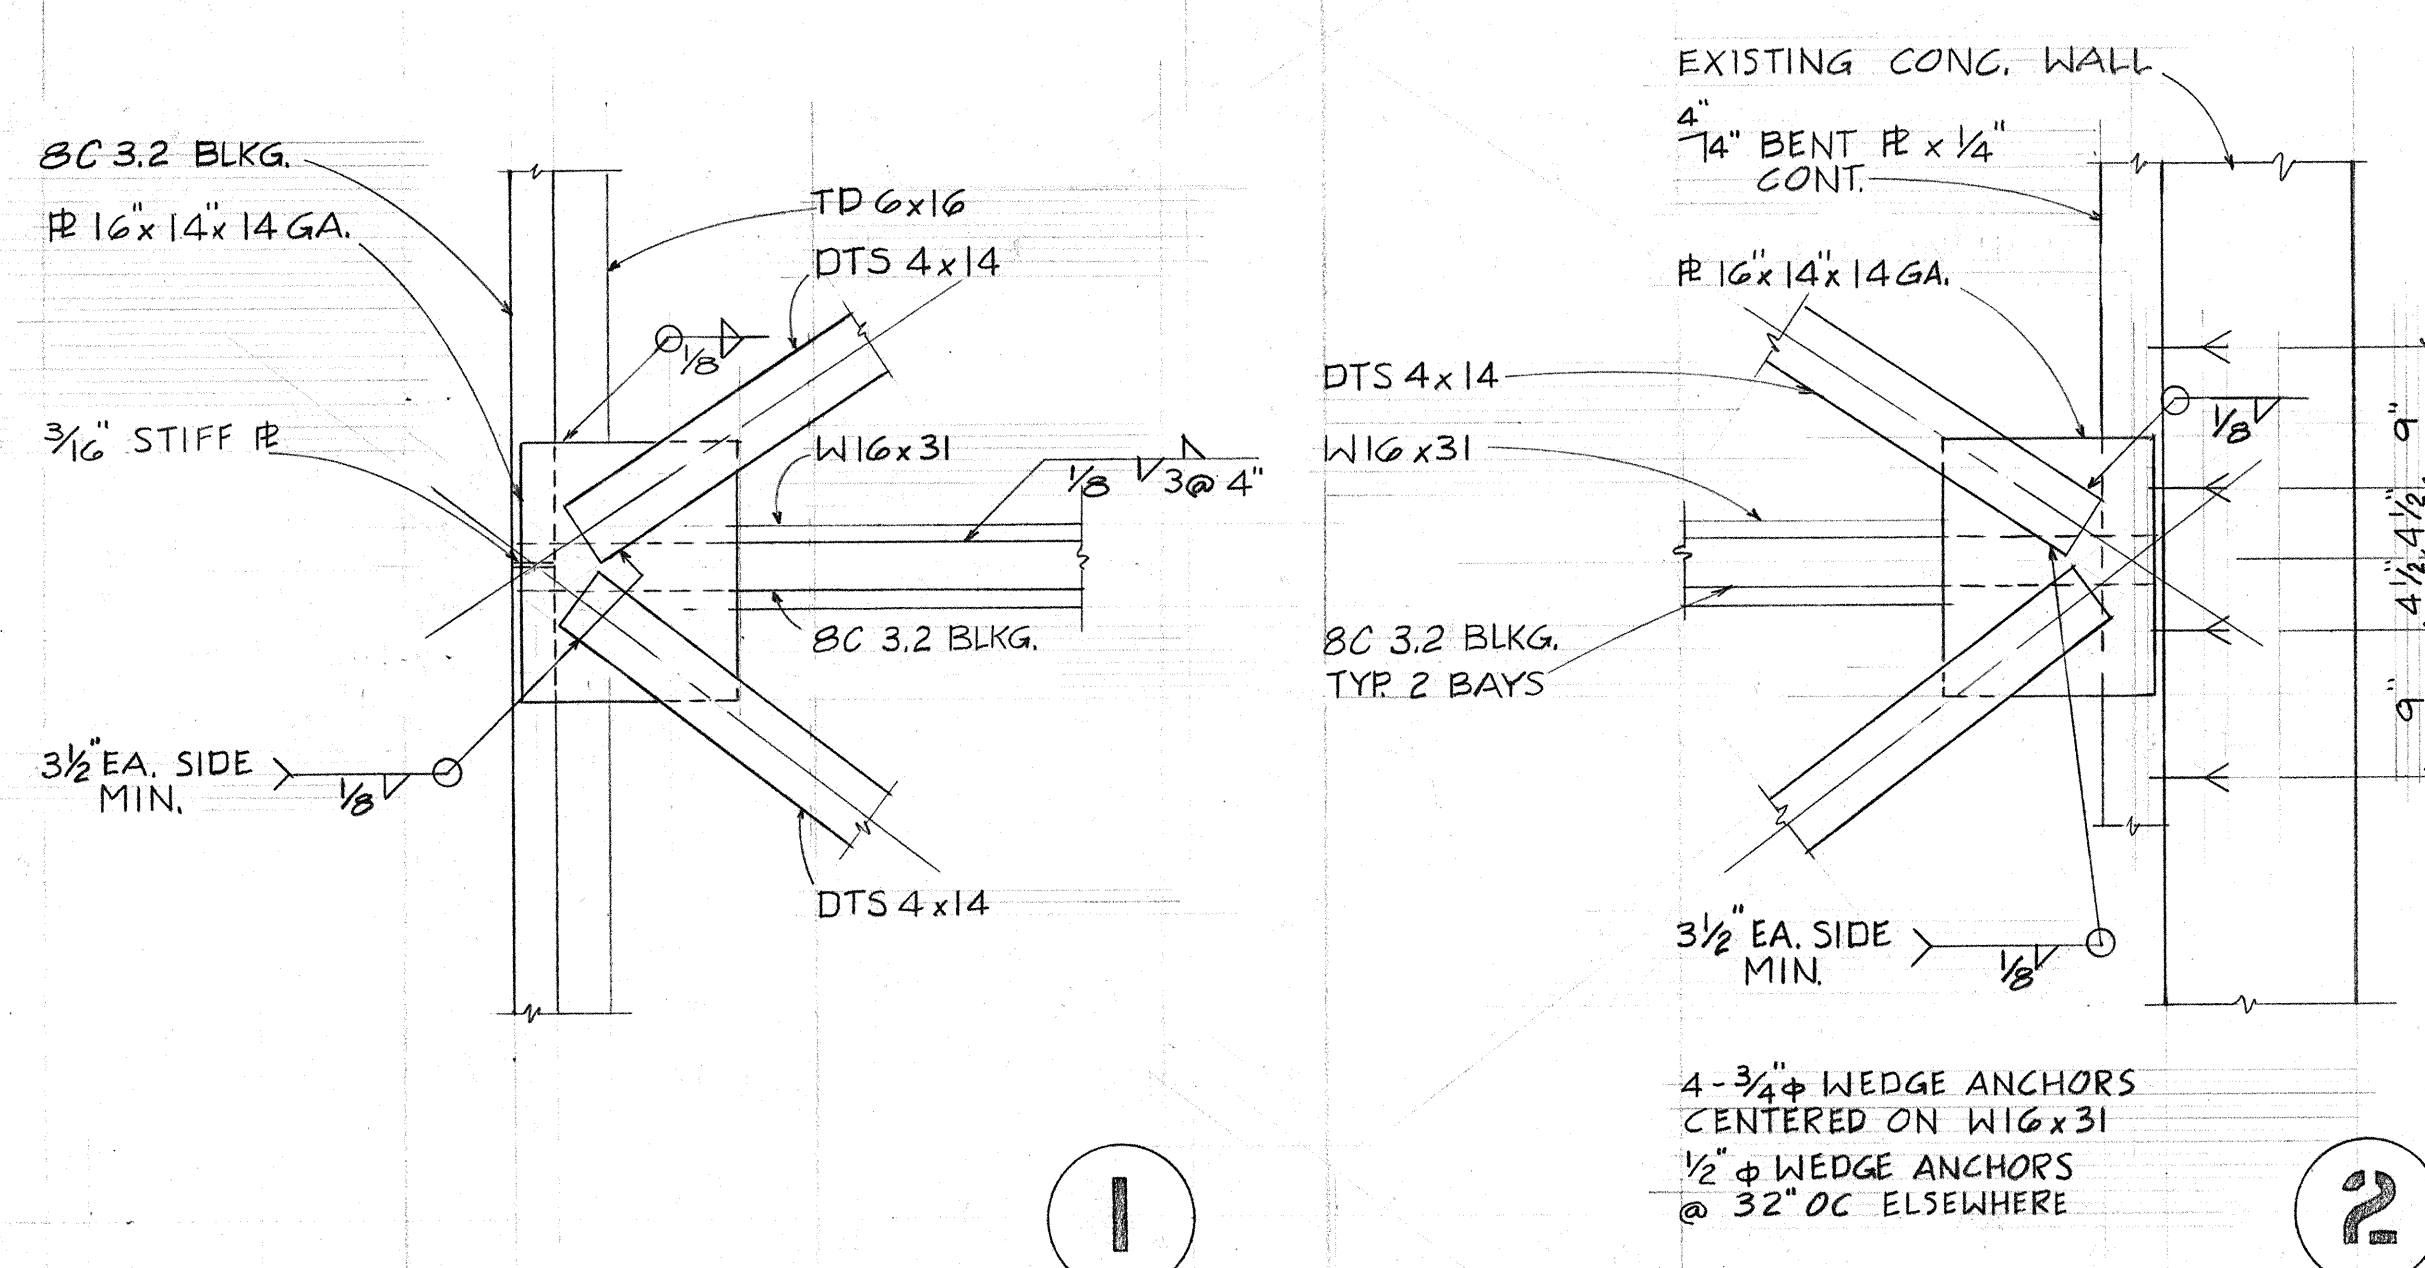

	12/20/88	Project Title		Date	
		ROOF FRAMING & FOUNDATION PLANS, FRAMING DETAILS		7/31/86	
		NHCU COVERED PATIO / SOLARIUM		Project No. 654-83-1210	
		Building Number 10		Drawing No. S 2	
Approved: Division Chief		Checked		Drawn	
Approved: Service Director		Location		VMAC RENO, NEVADA	

U.S. GOVERNMENT PRINTING OFFICE: 1984-455-088

Veterans Administration