


three inches = one foot
one and one half inches = one foot
one inch = one foot
three eighths inch = one foot
one half inch = one foot
one quarter inch = one foot
one eighth inch = one foot
one sixteenth inch = one foot


C1 SECTION DETAIL
SCALE: 1 1/2" = 1'-0"

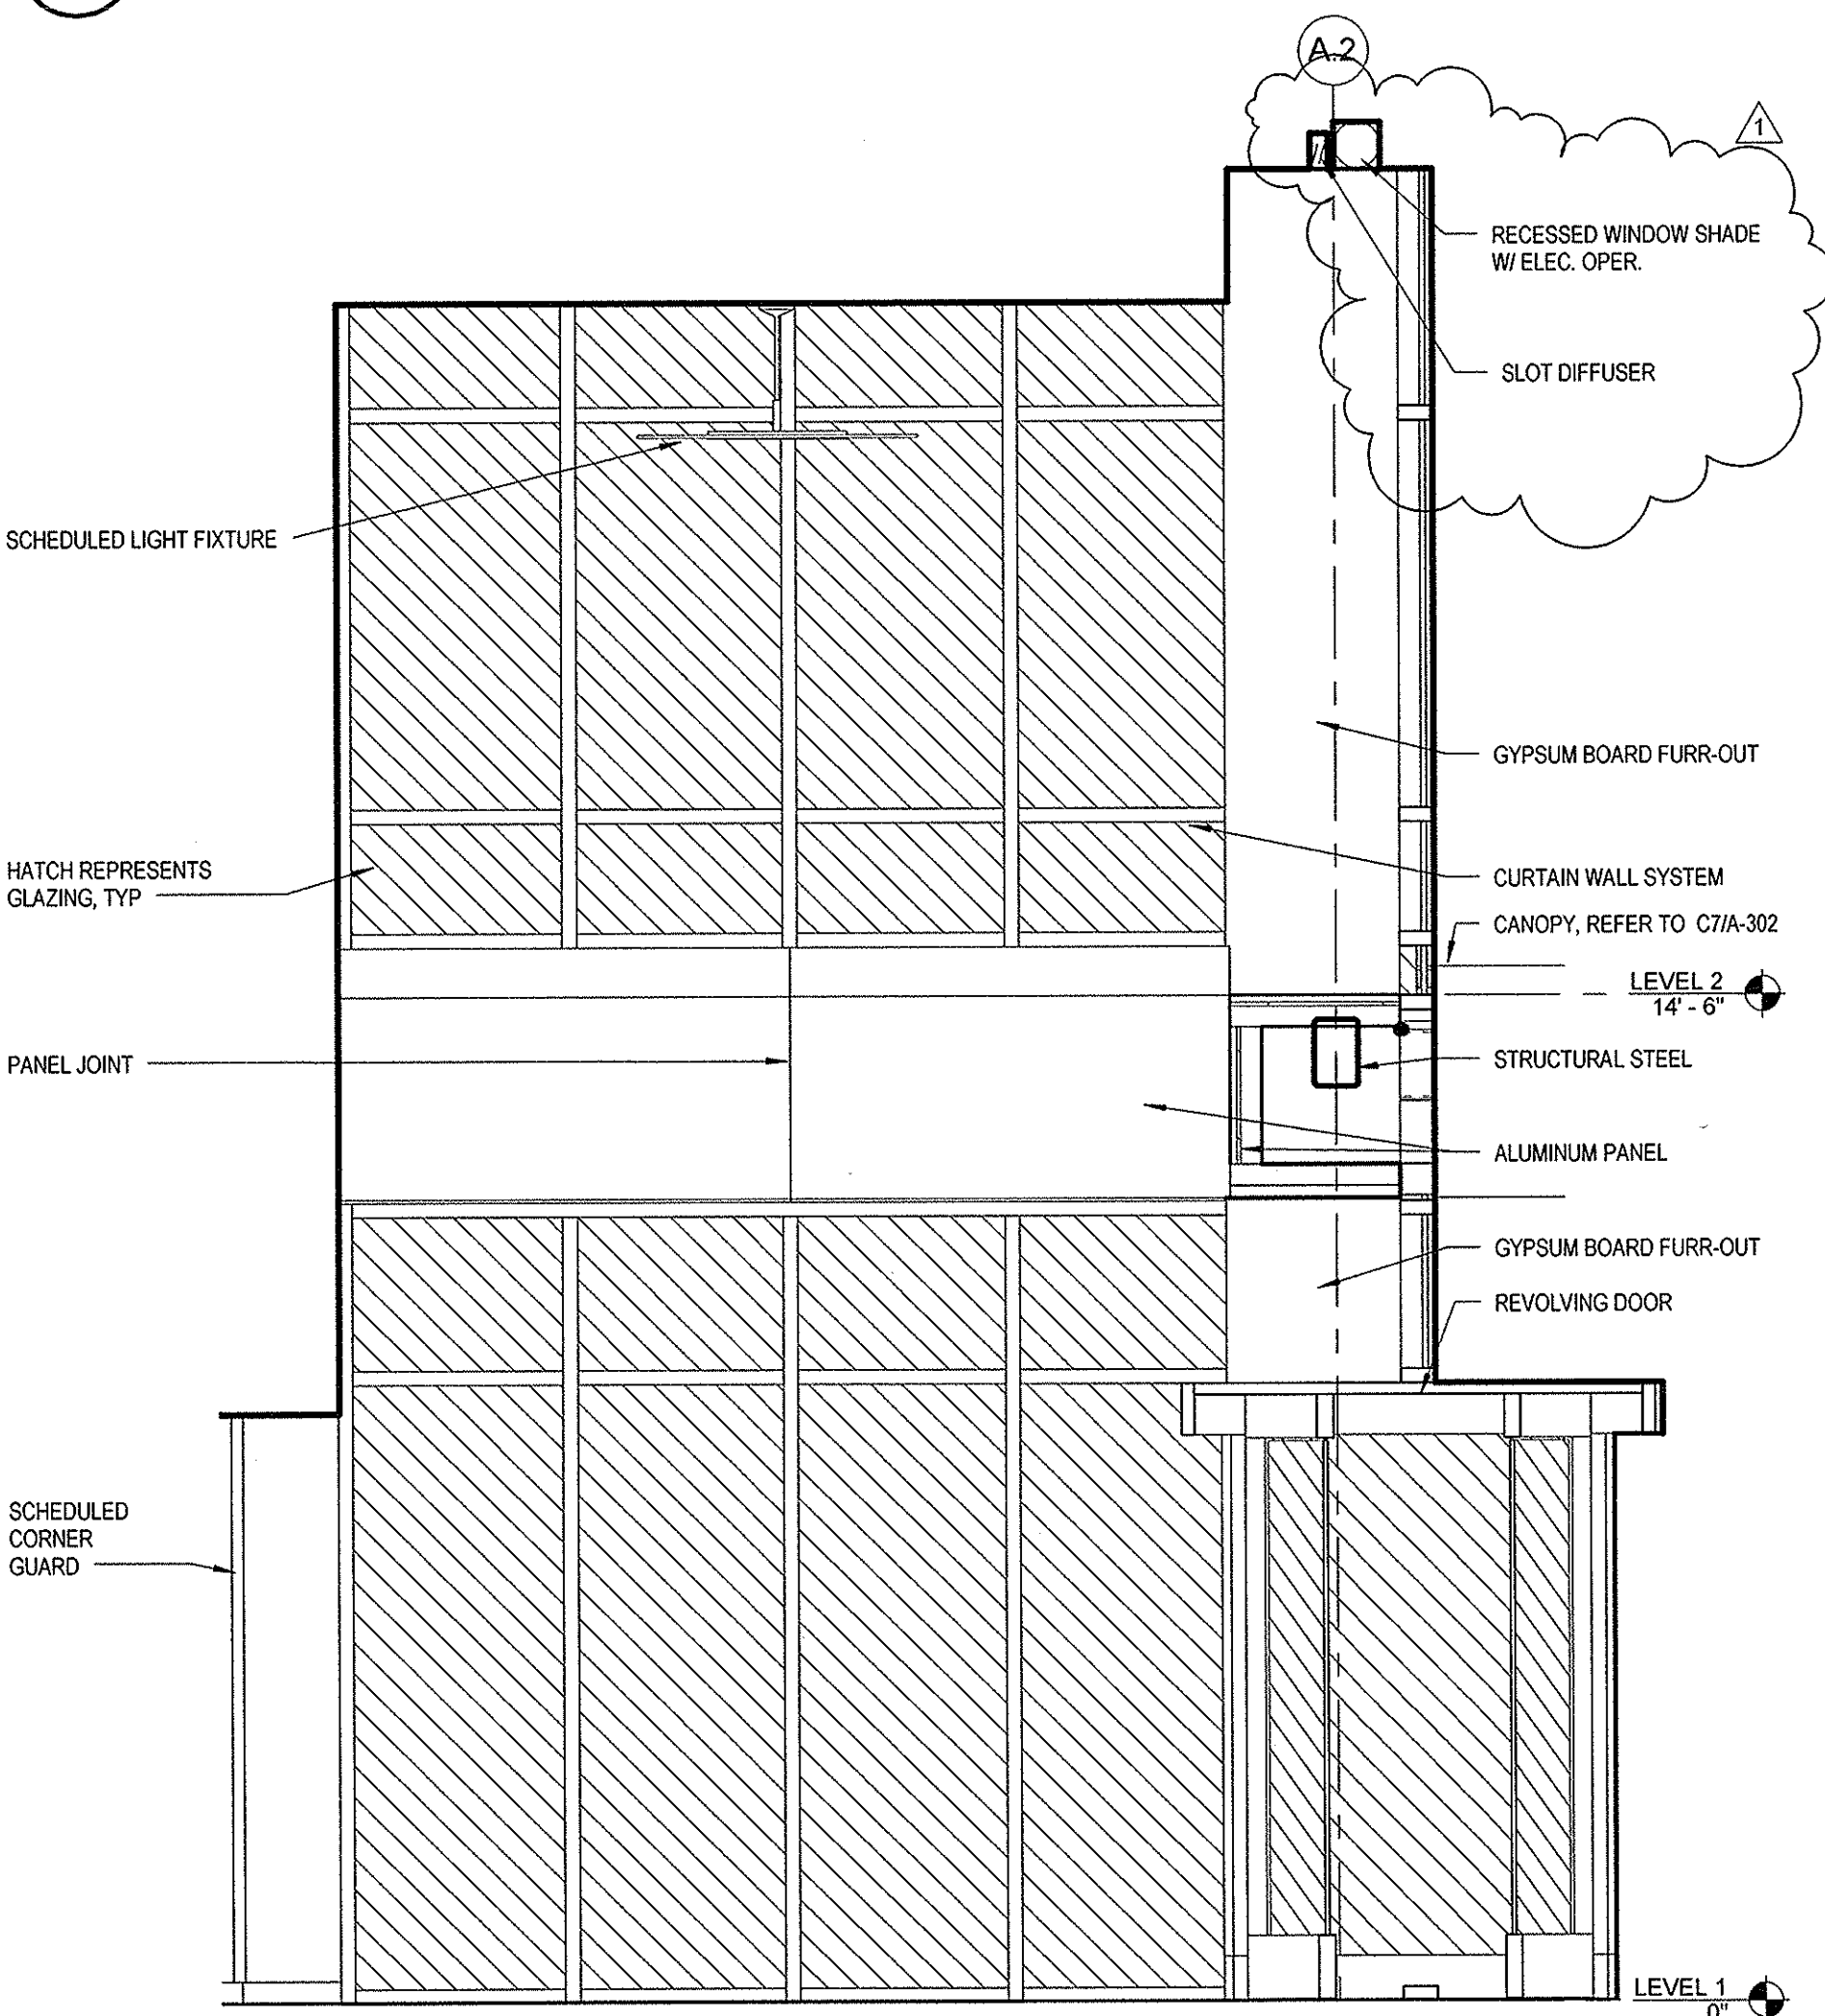

F1 ENTRY C-121 SOUTH INTERIOR ELEVATION
SCALE: 3/8" = 1'-0"

Revisions	Date
1	Addendum No 3
2	09-12-2012

CONSULTANTS:
STRUCTURAL **ROGERS MOORE ENGINEERS**
2411 Fountainview, Suite 222 Houston, TX 77057 TEL: 832 342 3372 FAX: 281 582 5955
WALTER P. MOORE
1301 McKinney, Suite 1100 Houston, TX 77010 TEL: 713 630 7300 FAX: 713 630 7394
CIVIL **H2B, INC.**
1225 North Loop West, Suite 900 Houston, TX 77008 TEL: 713 864 2900 FAX: 713 583 1245
PARKING **WALTER P. MOORE**
1301 McKinney, Suite 1100 Houston, TX 77010 TEL: 713 630 7300 FAX: 713 630 7396
COMMUNICATIONS **4B TECHNOLOGY**
12600 Northborough Dr., Suite 290 Houston, TX 77067 TEL: 832 249 9379 FAX: 832 249 9756

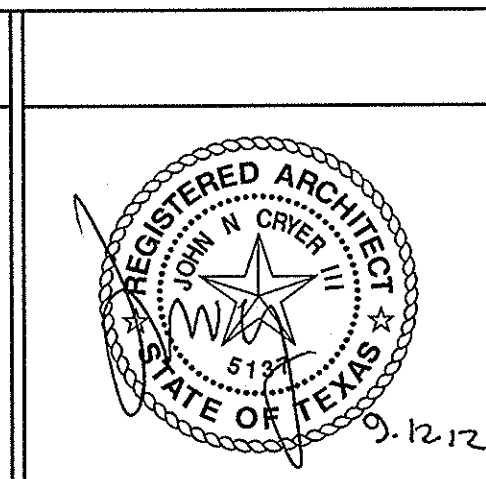


ARCHITECT/MEP ENGINEERS:
AUSTIN
DALLAS
DENVER
HOUSTON
WASHINGTON D.C.
PageSoutherlandPage
ARCHITECTURE INTERIORS CONSULTING ENGINEERING
PAGE SOUTHERLAND PAGE, LLP
1100 Louisiana Suite 1 Houston, Texas 77002
tel: 713 871 8484 fax: 713 871 8440 www.pspaecc.com

Drawing Title
CANOPY PLAN AND SECTIONS-BUILDING 108A
Approved: Project Director


Project Title
Expansion & Renovation of Building 108 for Mental Health
Project Abbreviation
Location Michael E. DeBakey Medical Center
2002 Holcombe Blvd, Houston, TX 77030
Date 06-15-2012
Checked Author
Drawn Checker
Project Number 580-319
Building Number 108A
Drawing Number A-302
Dwg. of 99

ISSUE FOR CONSTRUCTION
FULLY SPRINKLERED
Office of Construction and Facilities Management
Department of Veterans Affairs


F2 TYPICAL SECTION AT CURTAINWALL
SCALE: 1/2" = 1'-0"

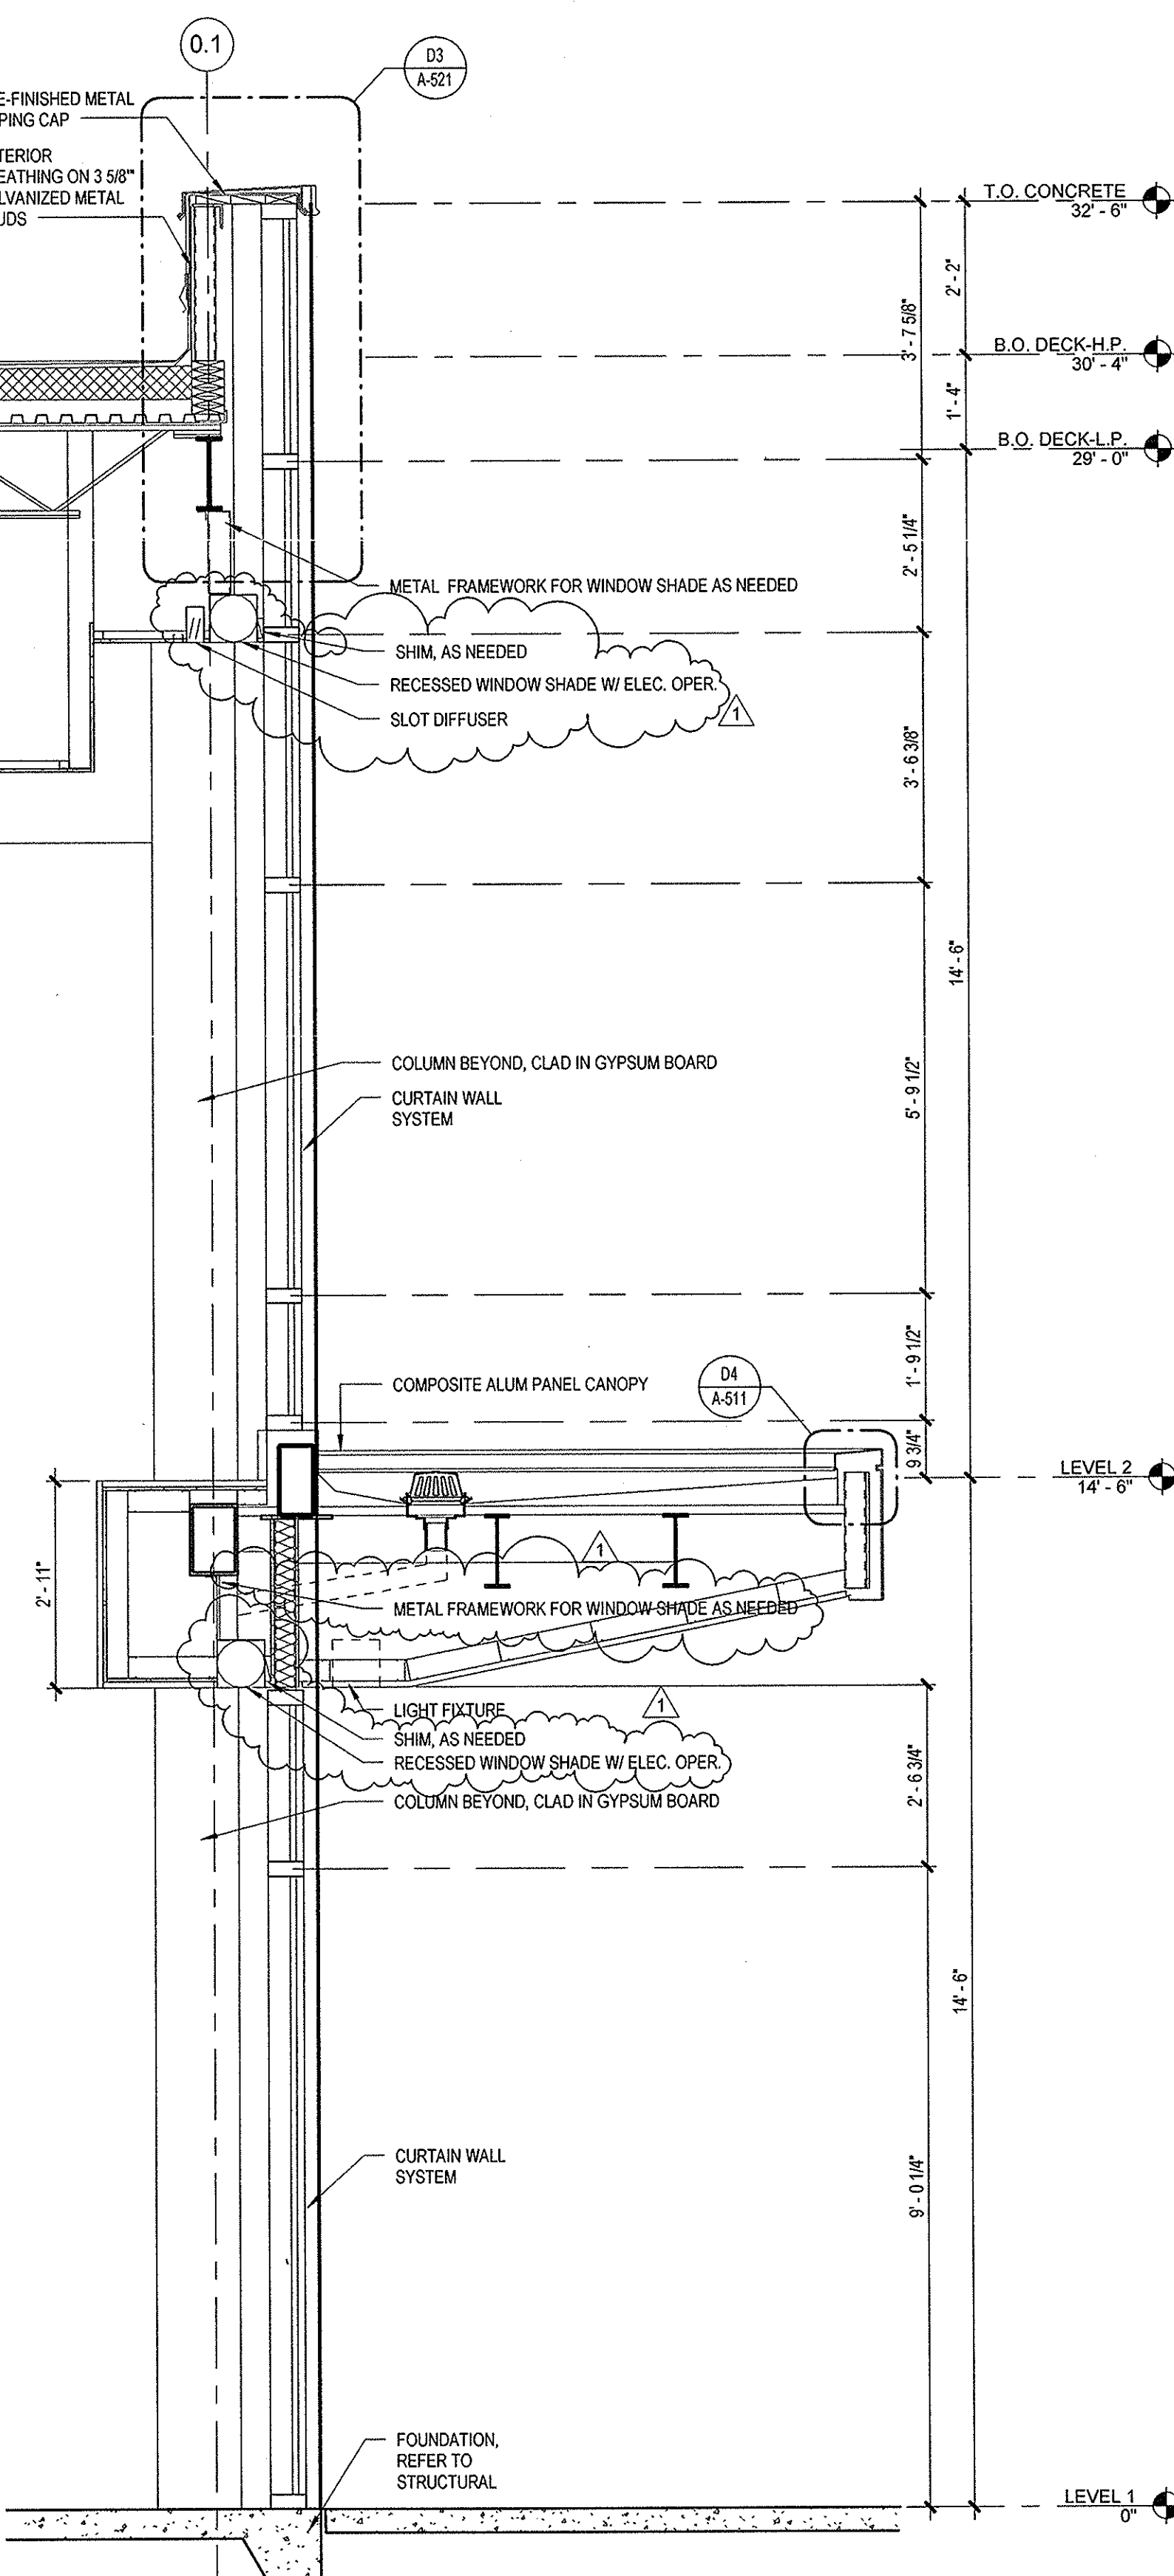

F5 CANOPY SECTION AT GRID A.2
SCALE: 1/4" = 1'-0"

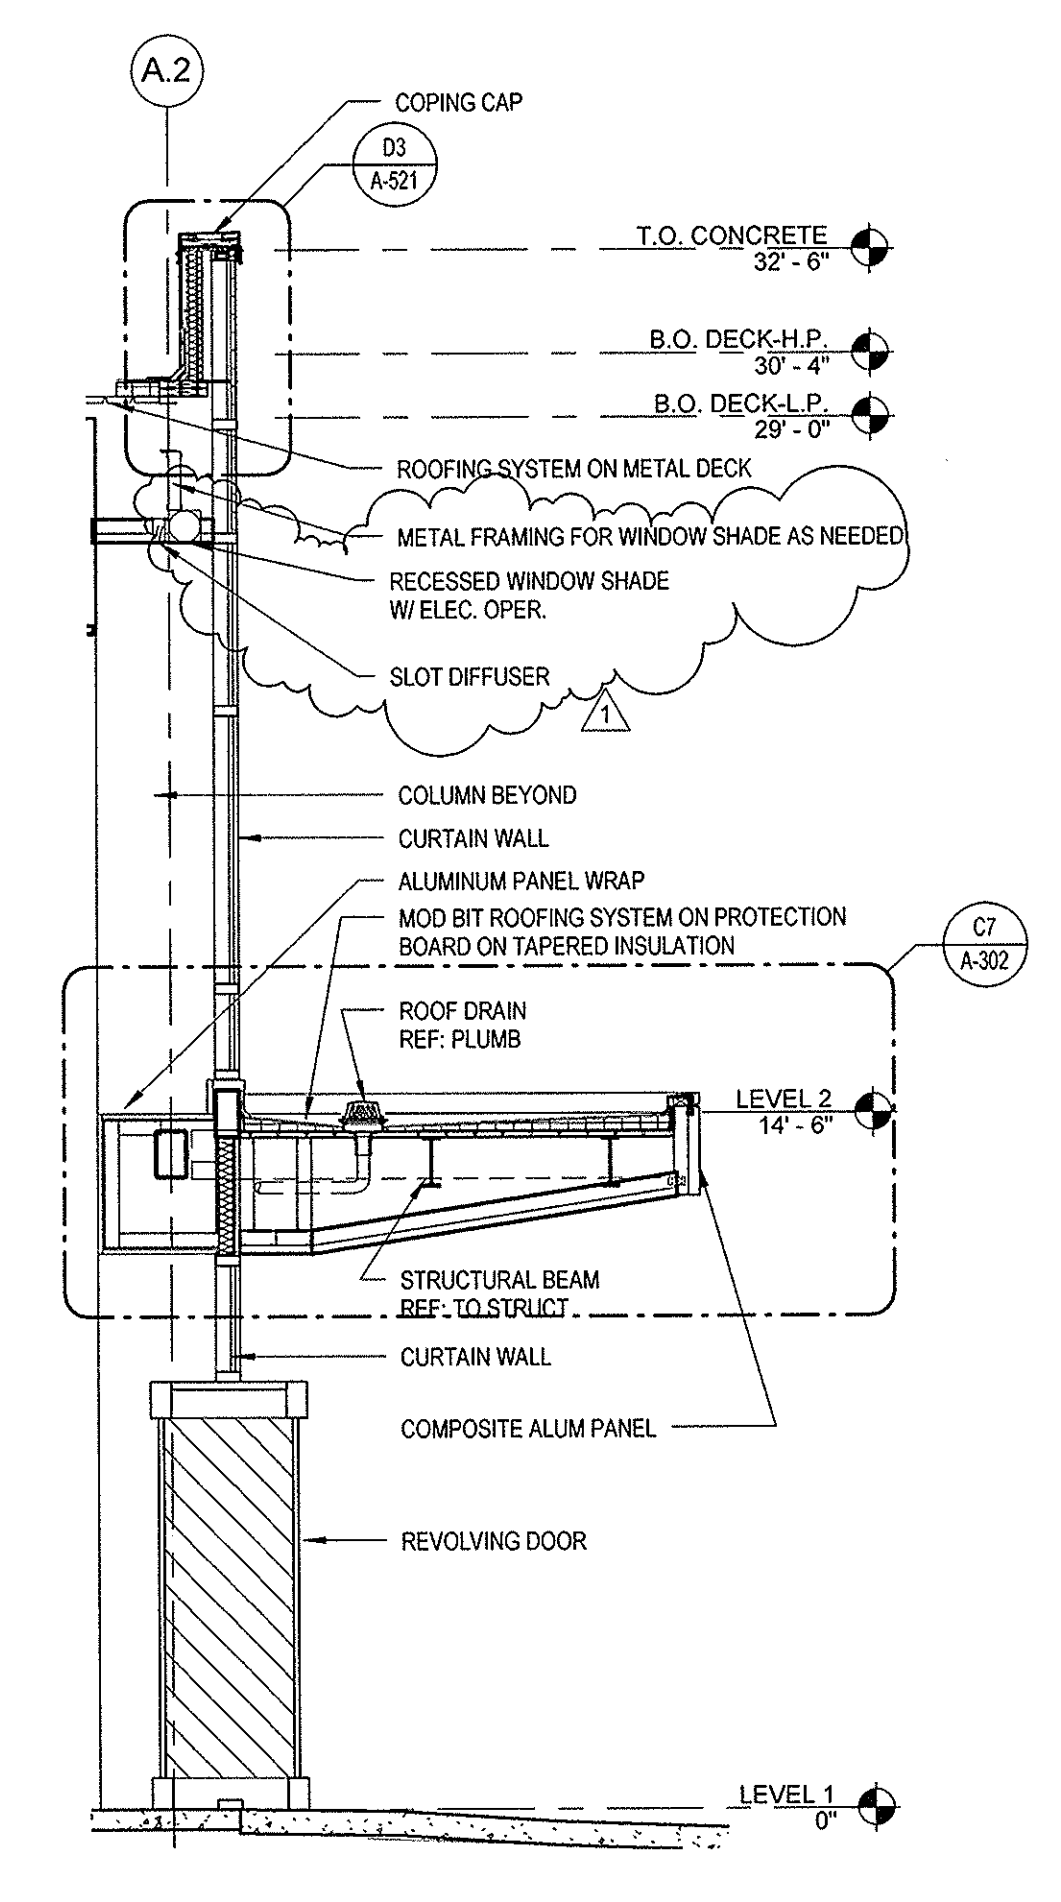

C7 DETAIL CANOPY SECTION
SCALE: 3/4" = 1'-0"

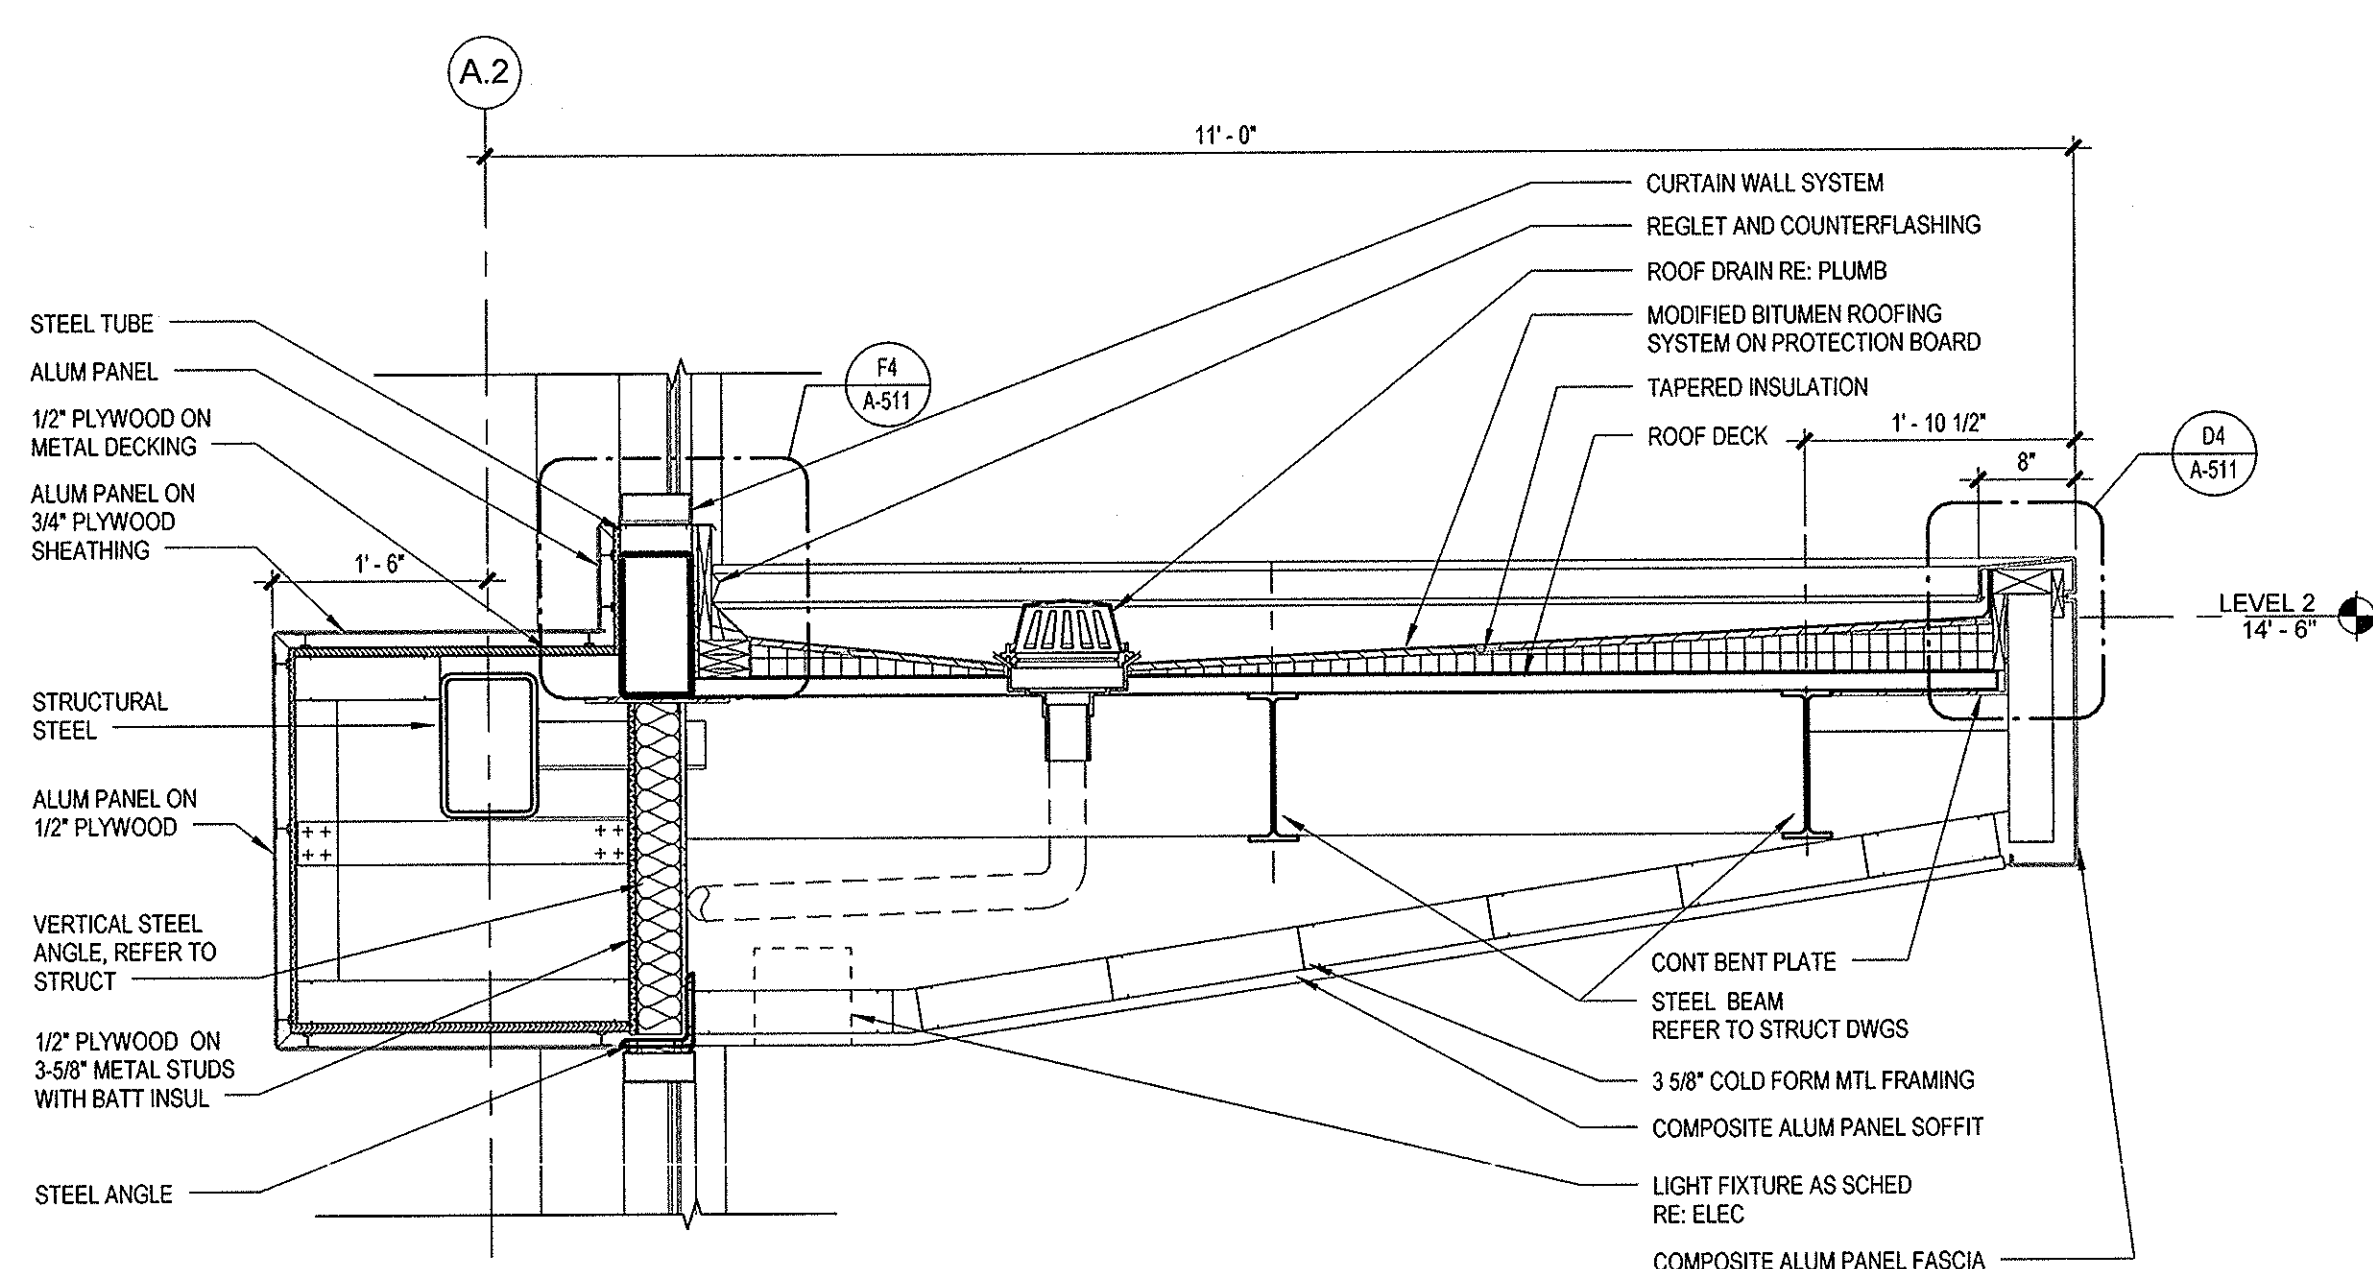

F7 CANOPY PLAN - LEVEL 2
SCALE: 1/4" = 1'-0"

