

LEGEND

EXISTING SPOT ELEVATION

PROPOSED SPOT ELEV., (S) SIDEWALK (P) PAVEMENT

EXISTING CONTOUR

PROPOSED CONTOUR

ST STORM

NEW CLEAN-OUT

NEW FDOT TYPE "E" INLET (B2/CG501)

NEW FDOT TYPE "3" CURB INLET (E4/CG501)

NEW FDOT TYPE "4" CURB INLET (E4/CG501)



STORMWATER FLOW DIRECTION

KCI TBM#6
N=424060.06
E=1575062.77
ELEV=16.50

NOTES

1. SEE SHEET CG102 FOR STORMWATER STRUCTURE AND PIPE TABLES.
2. SEE SHEET CG102 FOR PERIMETER ROADWAY PROFILE.
3. SEE SHEET CG103 FOR PERIMETER ROADWAY SECTIONS.
4. SEE SHEET CG103 FOR RETENTION POND SECTIONS.
5. CLOSELY COORDINATE STORM/UTILITY PIPE LOCATIONS WITH STRUCTURAL FOOTINGS

GRAPHIC SCALE

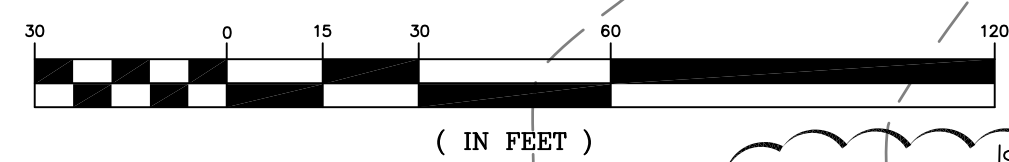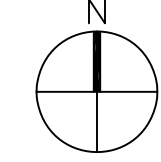

three inches = one foot

one and one half inches = one foot

one inch = one foot

three quarters inch = one foot

one half inch = one foot

three eighths inch = one foot

one quarter inch = one foot

one eighth inch = one foot





CONSULTANTS:

CIVIL:
KENNETH HORNE & ASSOCIATES
7201 NORTH 9TH AVENUE, STE. 6
PENSACOLA, FLORIDA 32504
PH: (850) 471-9005
FX: (850) 471-0093

COMM/DES:
SCHMIDT CONSULTING GROUP, INC.
40 S. PALAFOX PLACE, STE. 300
PENSACOLA, FLORIDA 32502
PH: (850) 438-0050
FX: (850) 432-8631

SURVEYORS:
KCI TECHNOLOGIES, INC.
10401 HIGHLAND MANOR DRIVE, SUITE 120
TAMPA, FLORIDA 33610
PH: (813) 740-2300

LANDSCAPE ARCHITECT:
CSA GROUP, INC.
6300 PICCADILLY SQUARE DRIVE
MOBILE, ALABAMA 36609
PH: (251) 344-4023
FX: (251) 344-4052

ARCHITECT/ENGINEERS:



BES DESIGN/BUILD, LLC
766 Middle St, Fairhope, AL 36532
Phone: 251.990.5778 Fax: 251.990.3716

Drawing Title

GRADING AND STORMWATER PLAN

Approved Project Director

Project Title
PANAMA CITY
JOINT OUTPATIENT CLINIC
VA GULF COAST HEALTH CARE

Location
PANAMA CITY, FLORIDA

Date
SEPTEMBER 5, 2012

Checked
KCH

Drawn
LRR

Project Number
520-326

Building Number
-

Drawing Number
CG101

Dwg. 16 of 21

Office of
Construction
and Facilities
Management



FINAL SUBMISSION