GENERAL NOTES:

1. COORDINATE PIPING AND EQUIPMENT INSTALLATION WITH CEILING REMOVAL/INSTALLATION AND OTHER WORK INDICATED ON THE ARCHITECTURAL DRAWINGS.
2. COORDINATE PIPING AND EQUIPMENT INSTALLATION WITH ACTUAL FIELD CONDITIONS. VARY PIPING ROUTING AND EQUIPMENT PLACEMENT AS REQUIRED WHERE CONFLICTS OCCUR.
3. COORDINATE PIPING AND EQUIPMENT INSTALLATION WITH WORK OF OTHER TRADES, INCLUDING ELECTRICAL ELEMENTS TO PREVENT INTERFERENCES.
4. REMOVE EXISTING EQUIPMENT IDENTIFICATION MARKERS AND PROVIDE NEW IDENTIFICATION MARKERS TO MATCH NEW EQUIPMENT IDENTIFICATION. TAGS INDICATED ON THESE NEW WORK DRAWINGS. THIS APPLIES TO THE EQUIPMENT INCLUDING AIR HANDLING UNITS AND ASSOCIATED CONTROL PANELS, ELECTRICAL DISCONNECTS, MOTOR CONTROL CENTERS, ETC.

KEYED NOTES:

(1) SET HWR BALANCING VALVE TO 1 GPM.

(2) CORE DRILL THRU EXISTING WALL. PROVIDE MIN. 12" CONCRETE BETWEEN OPENINGS. DO NOT CUT TWO (2) CONSECUTIVE VERTICAL BARS IN WALL.

(3) PROVIDE PRE-INSULATED PIPE SYSTEM FOR UNDERGROUND HW & HWR PIPING. HW & HWR PIPING SHALL BE K COPPER WITH 1" INSULATION. THE CW PIPING SHALL BE K COPPER WITH NO INSULATION. APPROVED MANUFACTURERS: ROVANCO HDPE COPPER-THERM OR APPROVED EQUAL. 9

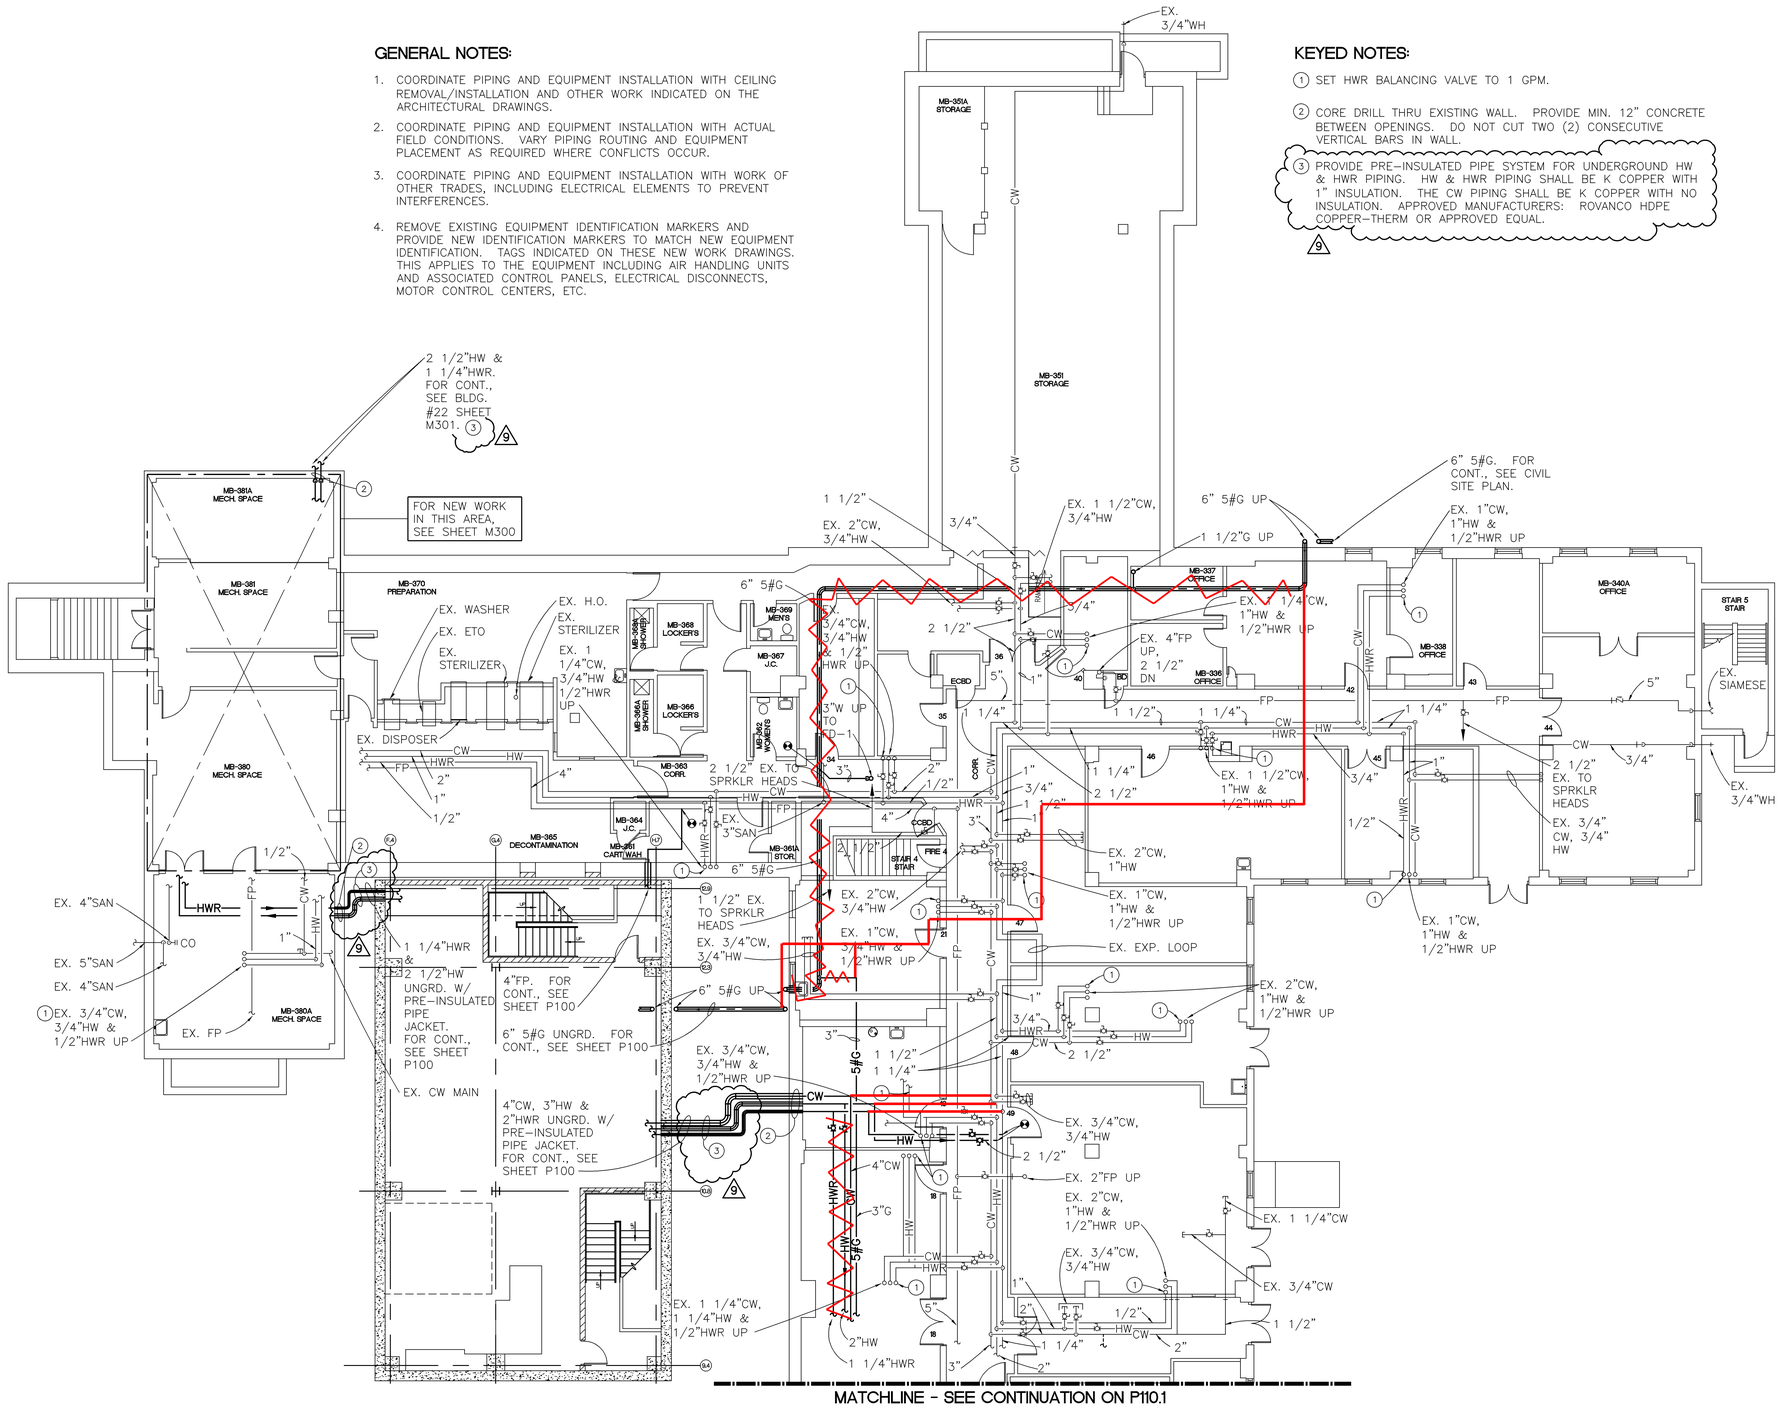

MATCHLINE - SEE CONTINUATION ON P110.1

N

Building No.1 - Basement - Area 3
SCALE: 1/8" = 1'-0"

BASEMENT	
DOOR NO.	ROOM NO. ROOM NAME
–	MB-100 BUILDING MANAGE.
–	MB-119 CORRIDOR
–	MB-126 MORGUE AMBULANCE ENT.
–	MB-126 STORAGE
–	MB-150A LAV.
–	MB-210A VEST.
–	MB-215 SHOWER
–	MB-215A MEN'S BATH
–	MB-221 BATH
–	MB-225 MEDICAL RECORDS
–	MB-230 MEDICAL RECORDS
–	MB-231 OFFICE
–	MB-250 LOUNGE
–	MB-255 SWITCHGEAR ROOM
–	MB-300 TELEPHONE
–	MB-305 OFFICE
–	MB-305A OFFICE
–	MB-306 STOR.
–	MB-326 CANTEEN STORAGE
–	MB-335 OFFICE
–	MB-336 OFFICE
–	MB-337 OFFICE
–	MB-338 OFFICE
–	MB-339 OFFICE
–	MB-340A OFFICE
–	MB-351 STORAGE
–	MB-351A STORAGE
–	MB-361 CART WASH
–	MB-362 WOMEN'S
–	MB-363 CORR.
–	MB-364 J.C.
–	MB-365 DECONTAMINATION
–	MB-366 LOCKER'S
–	MB-366A SHOWER
–	MB-367 J.C.
–	MB-368 LOCKER'S
–	MB-369 MEN'S
–	MB-368A SHOWER
–	MB-370 PREPARATION
–	MB-380 MECHANICAL SPACE
–	MB-380A MECHANICAL SPACE
–	MB-381 MECHANICAL SPACE
–	MB-381A MECHANICAL SPACE
–	STAIR 2
–	STAIR 3
–	STAIR 4
–	STAIR 5
2	MB-120 SOILED LINEN
2	MB-210 VEST.
5	MB-220 RECORDS
5A	MB-222 OFFICE
5B	MB-224 OFFICE
5C	MB-226 OFFICE
5D	MB-228 OFFICE
5G	MB-223 WAITING ROOM
9	MB-240 SOILED LINEN
12	MB-261 MACHINE SHOP
12A	MB-264 KEY ROOM
12B	MB-263 SWITCHGEAR ROOM
12C	MB-262 BLDG. MGMT. STORAGE
14	MB-241 OFFICE
15	MB-215 MEN'S LOCKER
16	MB-201 OFFICE
17	MB-301 EVIDENCE RM
18	MB-315 SUPPLY SHOP
19	MB-321 LAUNDRY
21	MB-325 STORAGE
34	MB-360 OFFICE
35	MB-355 OFFICE
36	MB-350 RECEIVING
40	MB-349 STORAGE
44	MB-340 CARPENTRY SHOP
45	MB-332 PAINT SHOP
46	MB-330 ELECTRICAL SHOP
48	MB-324 OFFICE
49	MB-320 LAUNDRY
54	MB-141 CART STORAGE
55	MB-129 OFFICE
56	MB-125 MORGUE
58	MB-115 FMS
58B	MB-116 OFFICE
59	MB-105 OFFICE

BASEMENT	
DOOR NO.	ROOM NO. ROOM NAME
60	MB-103 MECH.
60A	MB-101 STOR.
61	MB-104 OFFICE
62	MB-106 OFFICE
63	MB-108 OFFICE
64	MB-110 OFFICE
65	MB-112 OFFICE
70	MB-124 SOILED LINEN
71	MB-130 FEE OFFICE
71A	MB-131 FEE OFFICE
72	MB-132 HVAC SHOP
72	MB-133 MECH.
73	MB-134 STORAGE
74	MB-140 SECURITY ROOM
76	MB-150 WOMEN'S LOCKER
CCB	MB-200 TELEPHONE EQUIP.
CCBC	MB-117 COPIER
CCBD	MB-327 STORAGE
ECBB	MB-203 ELECT.
ECBD	MB-354 ELECT.
HCBB	MB-122 SOILED LINEN

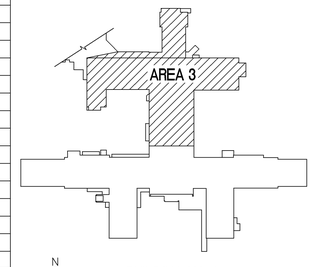

BUILDING NO. 1
KEY PLAN

AMENDMENT 9	06-28-09
Revisions	Date

CONSULTANTS:

WOLF WINEMAN
30500 Northwestern Hwy, Suite 100
Farmington Hills, Michigan 48334
TEL: (248) 855-3053
FAX: (248) 855-2632
Project No. 390005

Department of Veterans Affairs
Aleda E Lutz Medical Center
1500 Weiss Street
Saginaw, MI 48602

Property of the United States Government
For Official Use Only
Do not remove this notice
Properly Destroy documents when no longer needed

File Name: 655-07-111.001 P110.3

File Location: V:\330 VA Saginaw - Aleda E Lutz Medical Center\390005 Replace and Convert Steam Distribution System\Construction Dwg

Drawing Title: BASEMENT AREA NO. 3 NEW WORK PLAN - PLUMBING

Approved: Director Facilities Management Service

Approved: Medical Center Director

Project Title: REPLACE AND CONVERT STEAM DISTRIBUTION SYSTEM

Project No.: 655-07-111

Date: 05-01-09 | Checked: JMK | Drawn: PKB

Scale: AS NOTED

Building Number: 1

Drawing Number: 1-P110.3 R

Dwg. 3 of 9

Office of Facilities Management

Department of Veterans Affairs

VA FORM 08-6231, OCT 1978