BUILDING NO. 1
FIFTH FLOOR

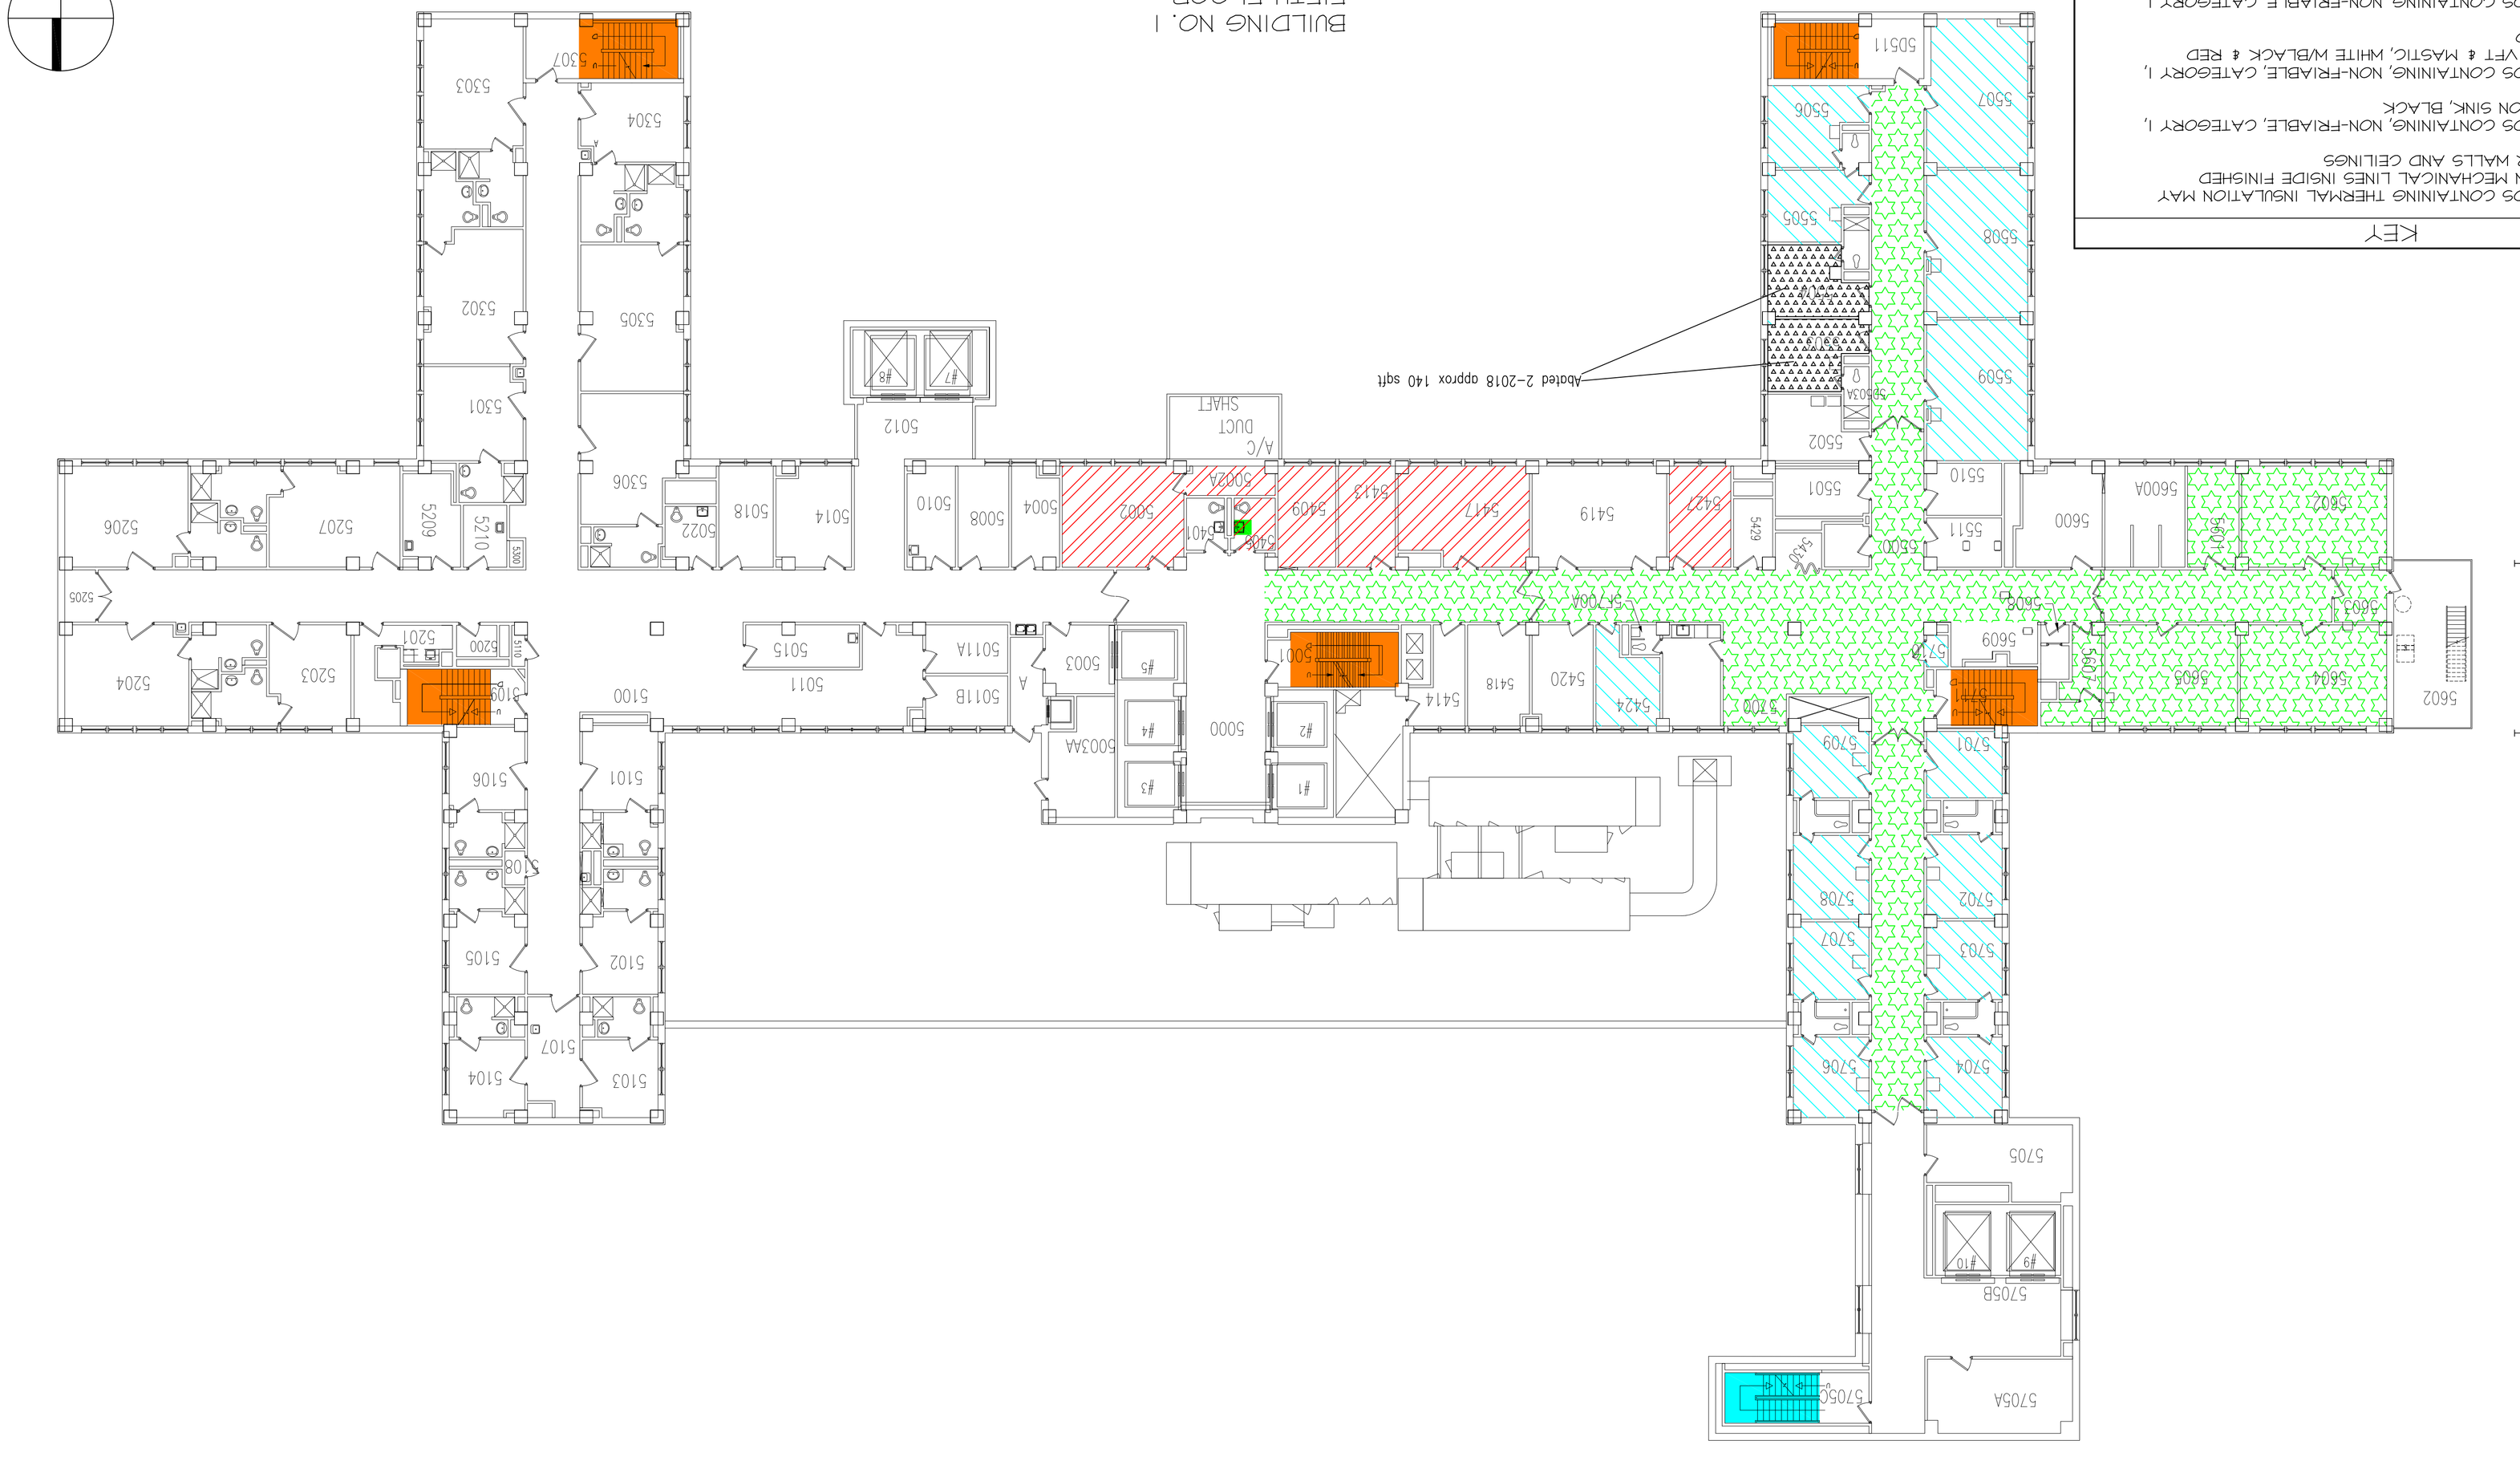

KEY

- ASBESTOS CONTAINING THERMAL INSULATION MAY EXIST ON MECHANICAL LINES INSIDE FINISHED INTERIOR WALLS AND CEILINGS
- ASBESTOS CONTAINING, NON-FRIABLE, CATEGORY I, MASTIC ON SINK, BLACK
- ASBESTOS CONTAINING, NON-FRIABLE, CATEGORY I, 12" × 12" VFT & MASTIC, WHITE W/BLACK & RED SPOTTED
- ASBESTOS CONTAINING, NON-FRIABLE, CATEGORY I, 12" × 12" VFT, WHITE W/GREEN SPOTTED (RESIDUAL BLACK MASTIC ONLY)
- ASBESTOS CONTAINING, NON-FRIABLE, CATEGORY I, 12" × 12" VFT, WHITE W/YELLOW SPOTTED (MASTIC ONLY)
- ASBESTOS CONTAINING, NON-FRIABLE, CATEGORY I, 4" × 4" VFT & MASTIC
- ASBESTOS CONTAINING, NON-FRIABLE, CATEGORY I, 12" × 12" VFT, YELLOW & TAN WITH BLACK MASTIC
- ASBESTOS CONTAINING, NON-FRIABLE, CATEGORY I, RESIDUAL BLACK HALLWAY FLOORING MASTIC

DRAWING TITLE
VA Medical Center
4101 Woolworth Avenue
Omaha, NE 68105

JOB NUMBER	DRAWN BY	DATE	CAD FILE	SCALE	SHEET
			Bl15.dwg	NONE	