


abated Jan 2015

▽ ▽ ▽ ▽ } asbestos abated


BUILDING NO. 8
FIRST FLOOR

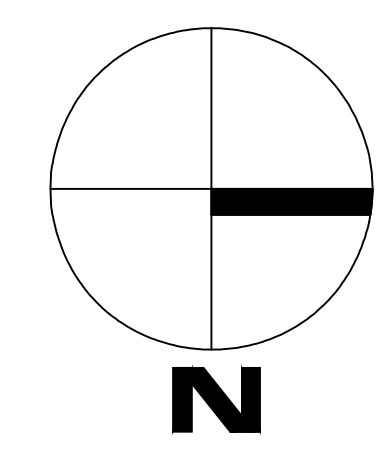

KEY

ASBESTOS CONTAINING THERMAL INSULATION MAY EXIST ON MECHANICAL LINES INSIDE FINISHED INTERIOR WALLS AND CEILINGS

ASSUMED ASBESTOS CONTAINING, FRIABLE, PIPE INSULATION, RUNS/RISERS THROUGHOUT

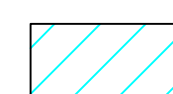 ASBESTOS CONTAINING, NON-FRIABLE, CATEGORY I, 12" x 12" VFT, WHITE W/BLACK SPOTTED (MASTIC ONLY)

 ASSUMED ASBESTOS CONTAINING, NON-FRIABLE, CATEGORY I, VINYL SHEET FLOORING, GREEN (MASTIC ONLY)

DRAWING TITLE

VA Medical Center
4101 Woolworth Avenue
Omaha, NE 68105

JOB NUMBER	DRAWN BY	DATE	CAD FILE B0f1.dwg	SCALE NONE	SHEET
------------	----------	------	----------------------	---------------	-------