

## **ADDENDUM ONE**

**20 SEPTEMBER 2012**

**DEPARTMENT OF VETERANS AFFAIRS MEDICAL CENTER  
Louis Stokes Medical Center – Wade Park Division  
Hemo Oncology Renovation**

as prepared by

**HASENSTAB ARCHITECTS, INC.**  
190 North Union Street  
Suite 400  
Akron, Ohio 44304

V.A. Project No. 541-10-1001  
HAI Project No. 09005

To: VAMC Contracting Officer for Distribution

---

This Addendum becomes a part of the Contract Documents and modifies the original Bidding documents dated 23 November 2011 as noted below. The Bidder shall acknowledge receipt of this Addendum as required by VAMC Solicitation documentation. Failure to do so may subject the Bidder to disqualification.

---

### **CHANGES TO SPECIFICATIONS**

None.

### **CHANGES TO DRAWINGS**


- 1.1 Drawing 1: Demolition Plan:
  - a. Revise drawing to include additional demolition of a door recently added to the area. See Sketch SK-A4.
- 1.2 Drawing 2: Floor Plan:
  - a. Added Keyed Notes #16 and #17 to clarify expansion joint locations. Refer to Sketches SK-A1 and SK-A2.
- 1.3 Drawing DE-3: Details:
  - a. Added Detail #10. Refer to Sketch SK-A3.
- 1.4 Drawing 8: Interior Elevations:
  - a. Revise Interior Elevation #5 to indicate procedure light to be 'VC' (FBO/IBC).

**END OF ADDENDUM ONE**

### **Attachments**

File: 09005/Bidding/Addendum  
P:\2009projects\09005.000 VAMC Oncology Dept Second Floor\Office\III  
BIDDING\_NEGOTIATIONS\Addenda\Addendum One 2012\Addendum One\_092012.doc


SUPP. DWG. NO.  
SK-A1

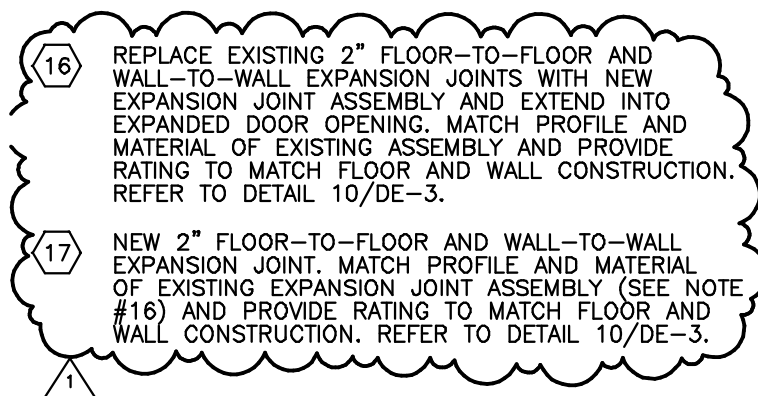

## **FLOOR PLAN LEGEND - KEYED NOTES**

NO SCALE

<b>HASENSTAB ARCHITECTS, INC.</b>  190 N. Union Street AKRON, OHIO 44304 PHONE: 330-434-4464 FAX: 330-434-8546	PROJECT NAME:	PROJECT NO.
	VAMC - Wade Park Division Hemo Oncology Renovation	09005
	ISSUED WITH: Addendum One	DATE 09/20/12
	REVISES SHEET: 2	SUPP. DWG. NO. SK-A2

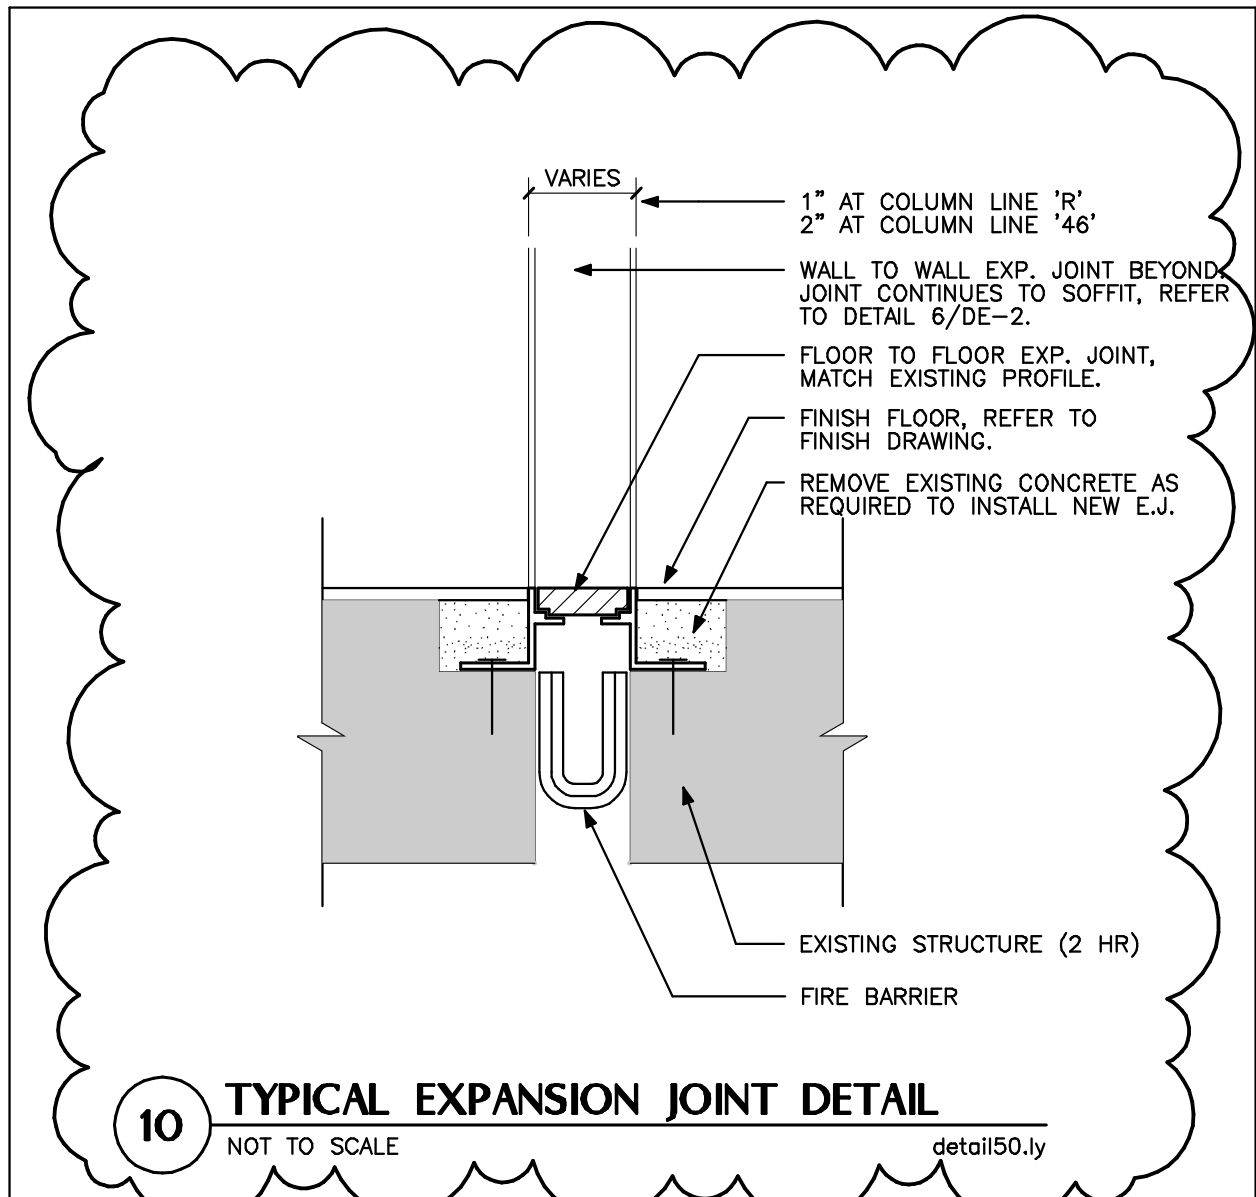

## HASENSTAB ARCHITECTS, INC.

190 N. Union Street  
AKRON, OHIO 44304  
PHONE: 330-434-4464  
FAX: 330-434-8546

### PROJECT NAME:

VAMC - Wade Park Division  
Hemo Oncology Renovation

### ISSUED WITH:

Addendum One

### REVISES SHEET:

DE-3

### PROJECT NO.


09005

### DATE

09/20/12

### SUPP. DWG. NO.

SK-A3

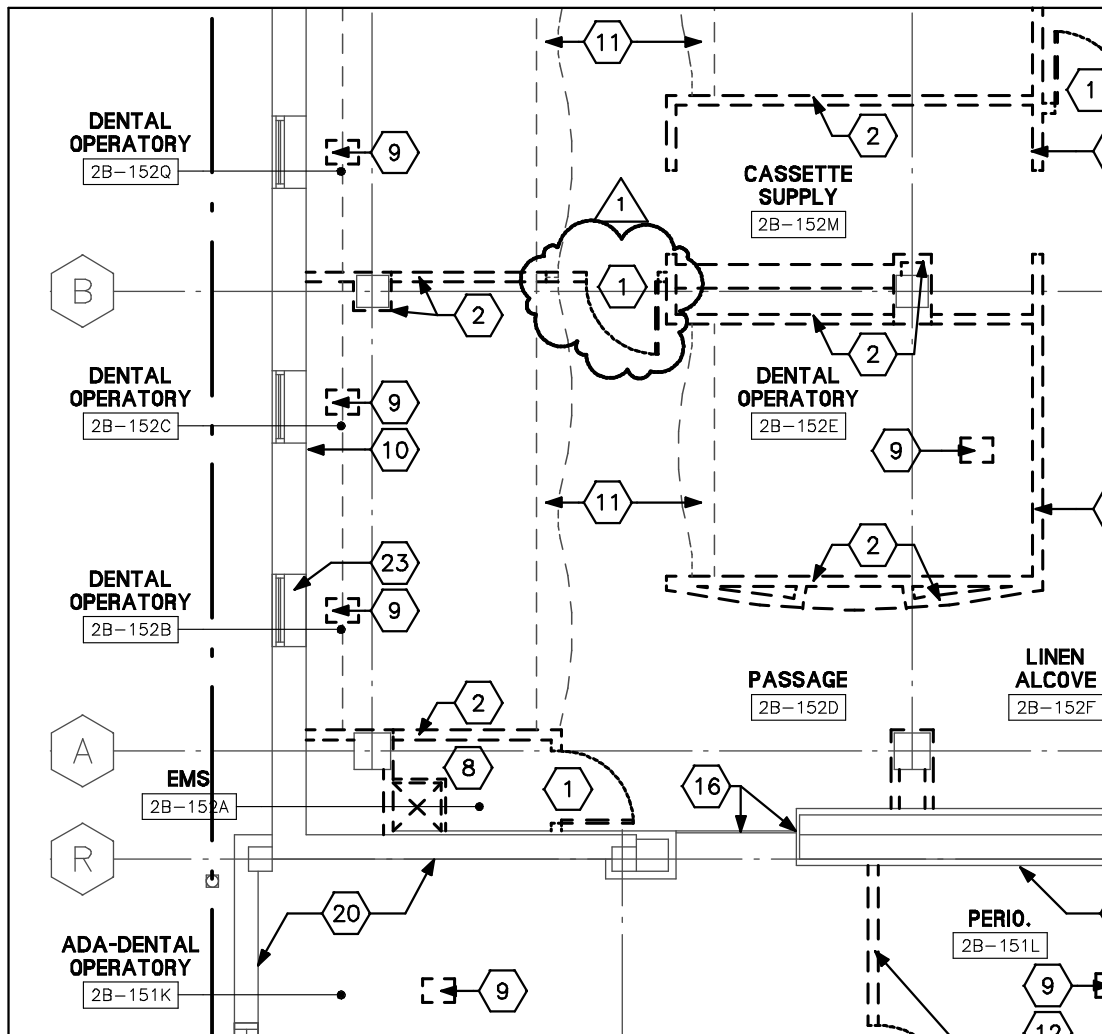

## PARTIAL DEMOLITION PLAN

SCALE: 1/8" = 1'-0"

### HASENSTAB ARCHITECTS, INC.

190 N. Union Street  
AKRON, OHIO 44304  
PHONE: 330-434-4464  
FAX: 330-434-8546

PROJECT NAME:  
VAMC - Wade Park Division  
Hemo Oncology Renovation

ISSUED WITH: Addendum One

REVISES SHEET: 1

PROJECT NO.  
09005

DATE  
09/20/12

SUPP. DWG. NO.  
SK-A4