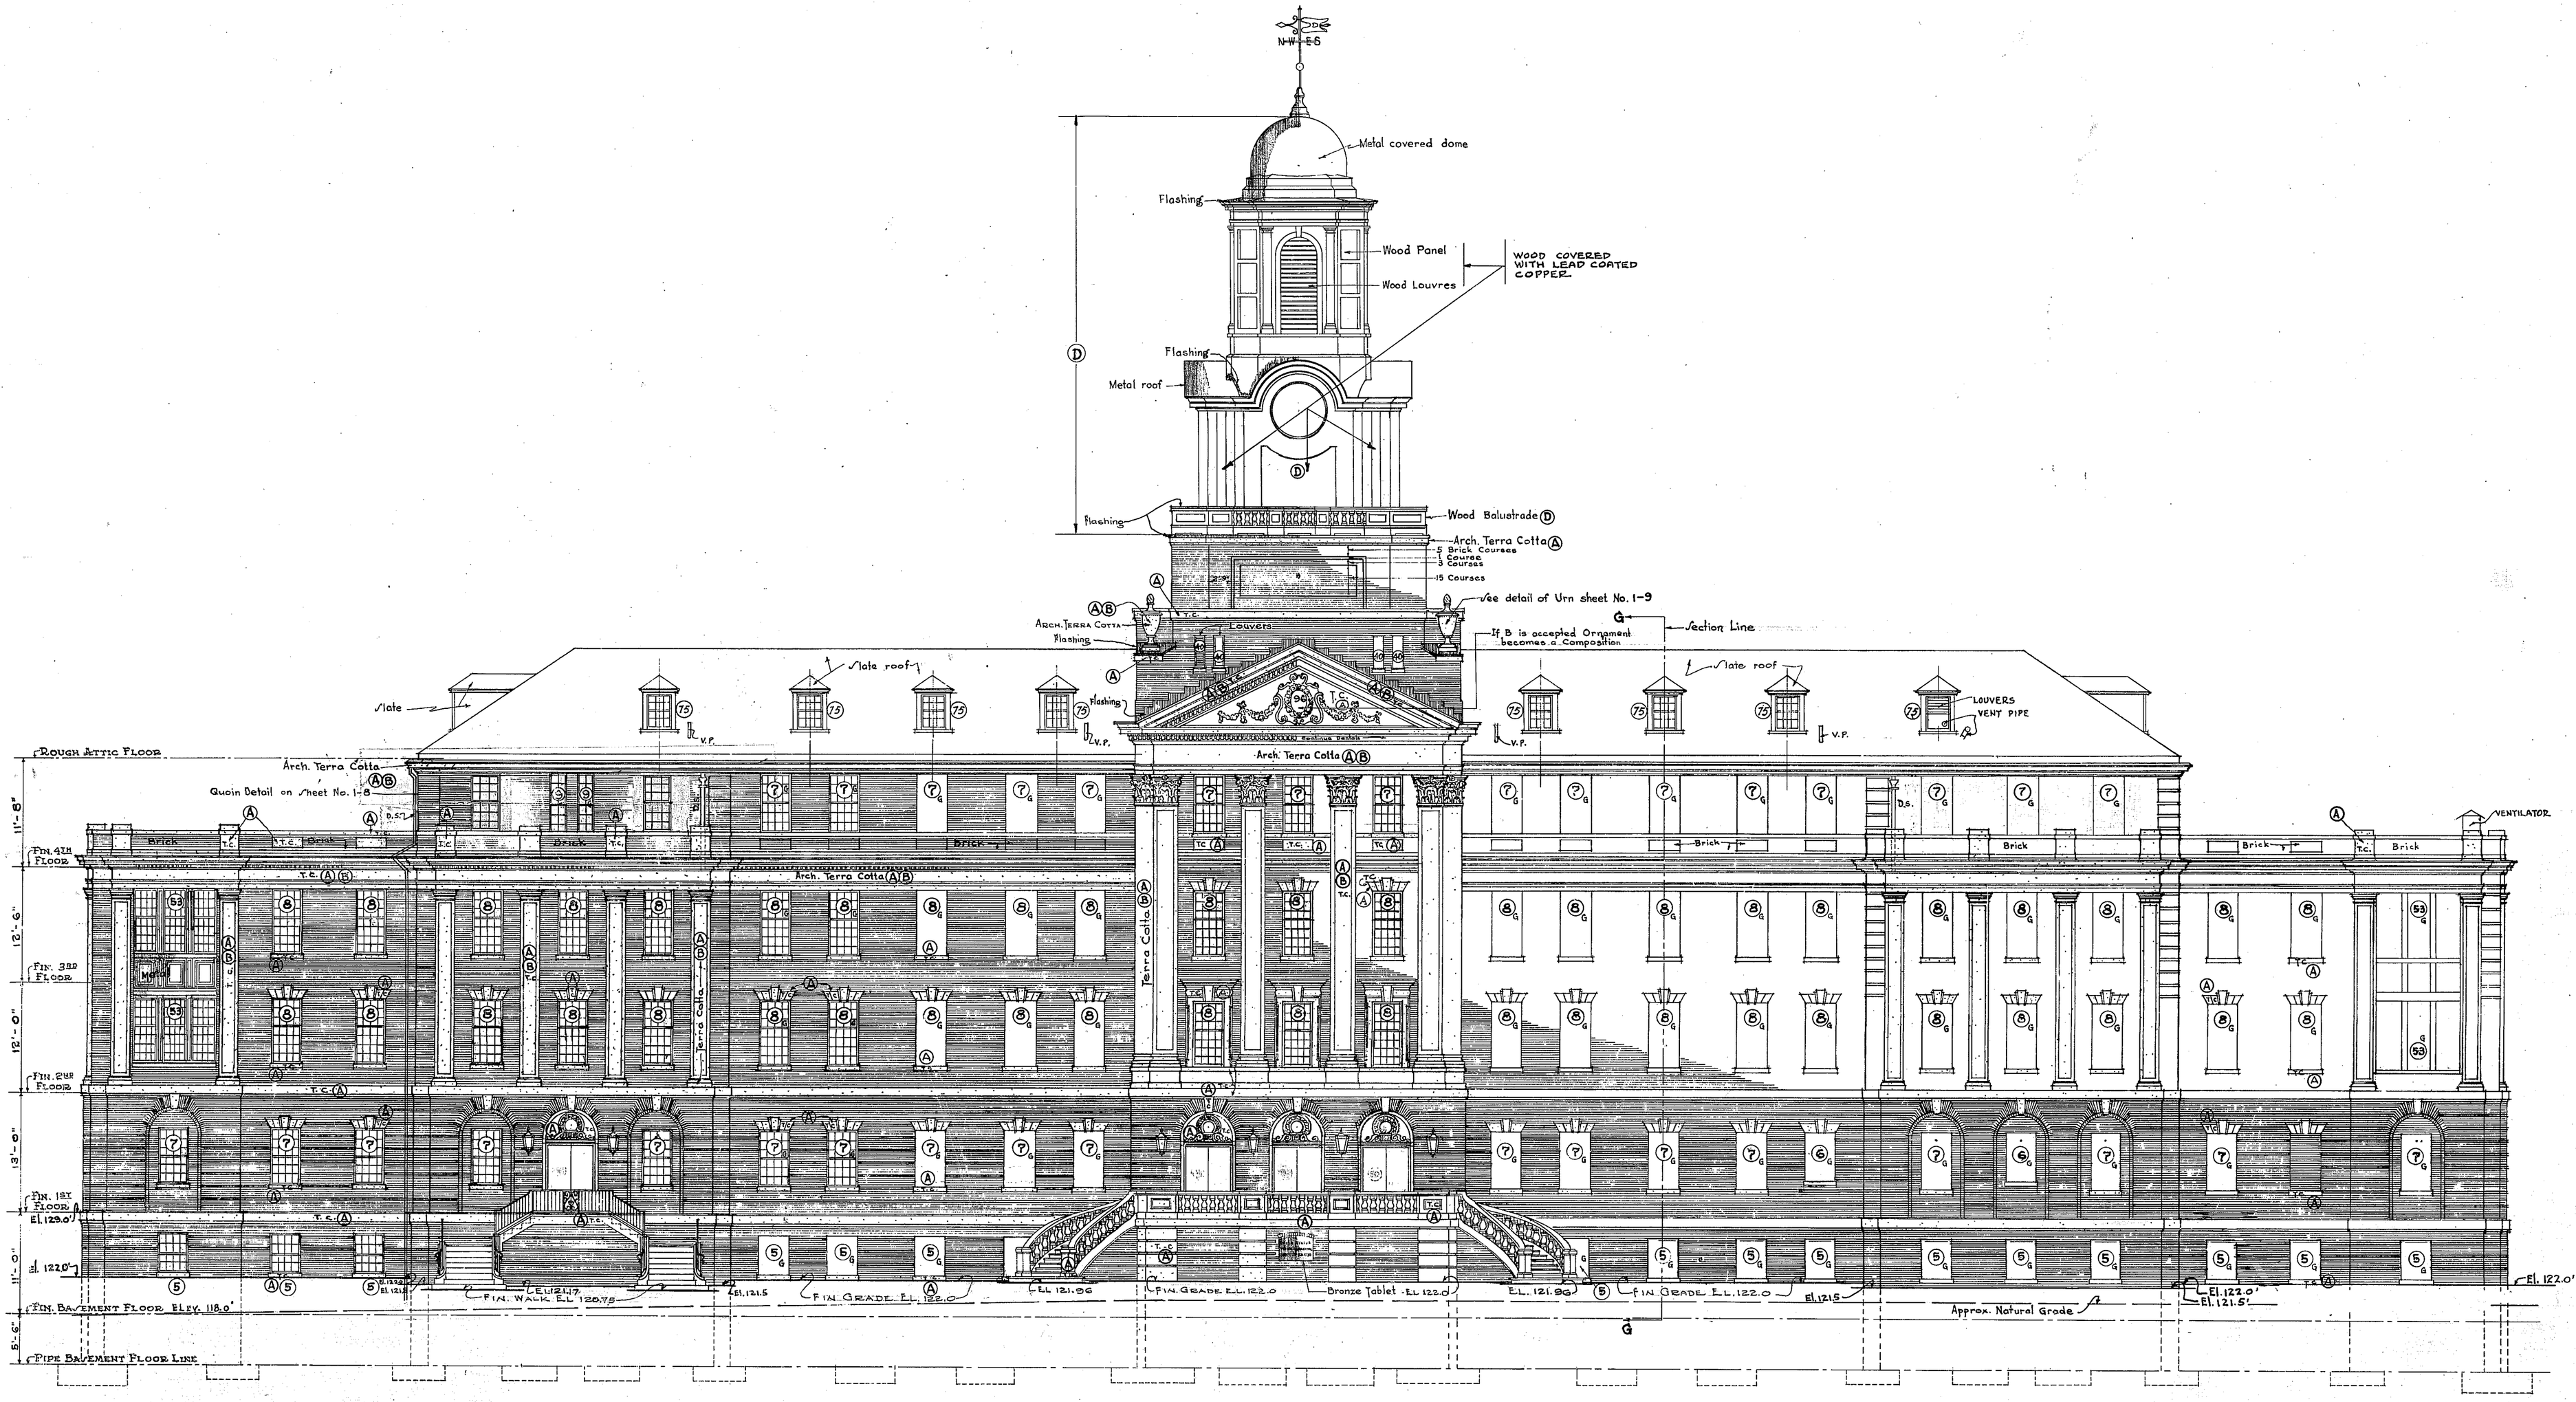

FRONT [EAST] ELEVATION

SCALE 1/8" = 1'-0"

(A) Architectural Terra Cotta with alternate on Stone

(B) " " " " " " Wood

(D) Wood, no alternate

1-2-1-1047

AS BUILT

U. S. VETERANS BUREAU	
WASHINGTON, D.C.	
APPROVED Frank T. Hines	DIRECTOR
	CHIEF CONSTRUCTION DIVISION
W. L. Dalton	CHIEF DESIGN SUBDIVISION
	CHIEF ENGINEERING SUBDIVISION

MAIN - BUILDING - No 1

U. S. VETERANS HOSPITAL

NEWINGTON, CONN.

Drawn	REVISIONS	NUMBER
Traced	6/10/49 AS BUILT - R.B.R.	1-7
Checked		
Date Dec. 27, 1929		Sheet 7 of 43