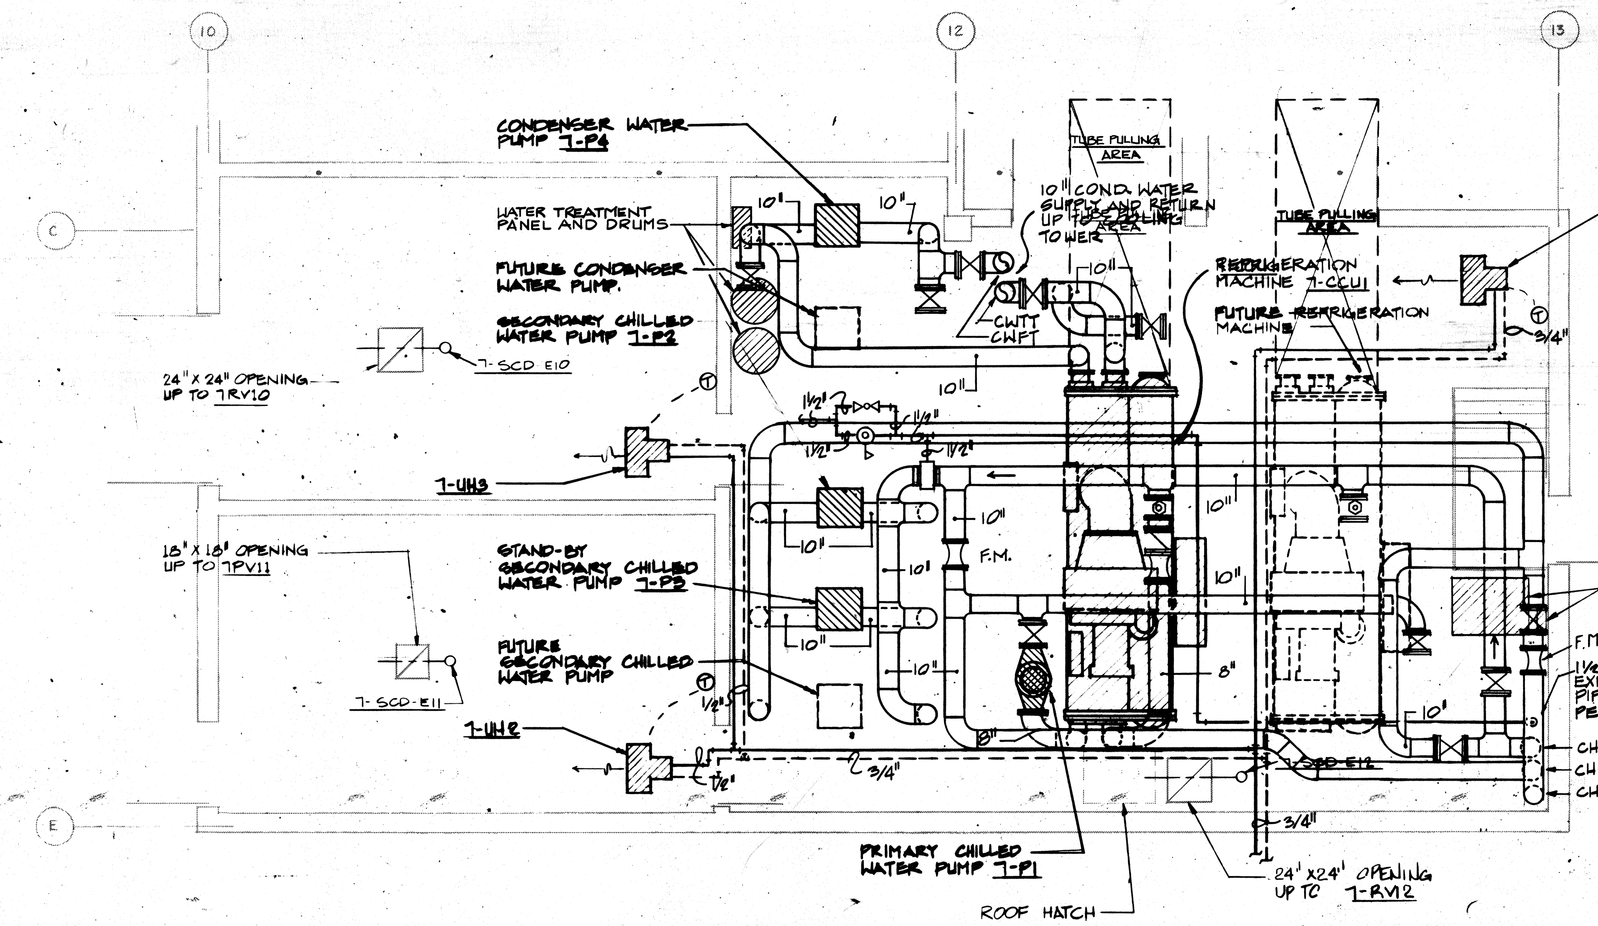

1 CHILLER ROOM
1/4"=1'-0"

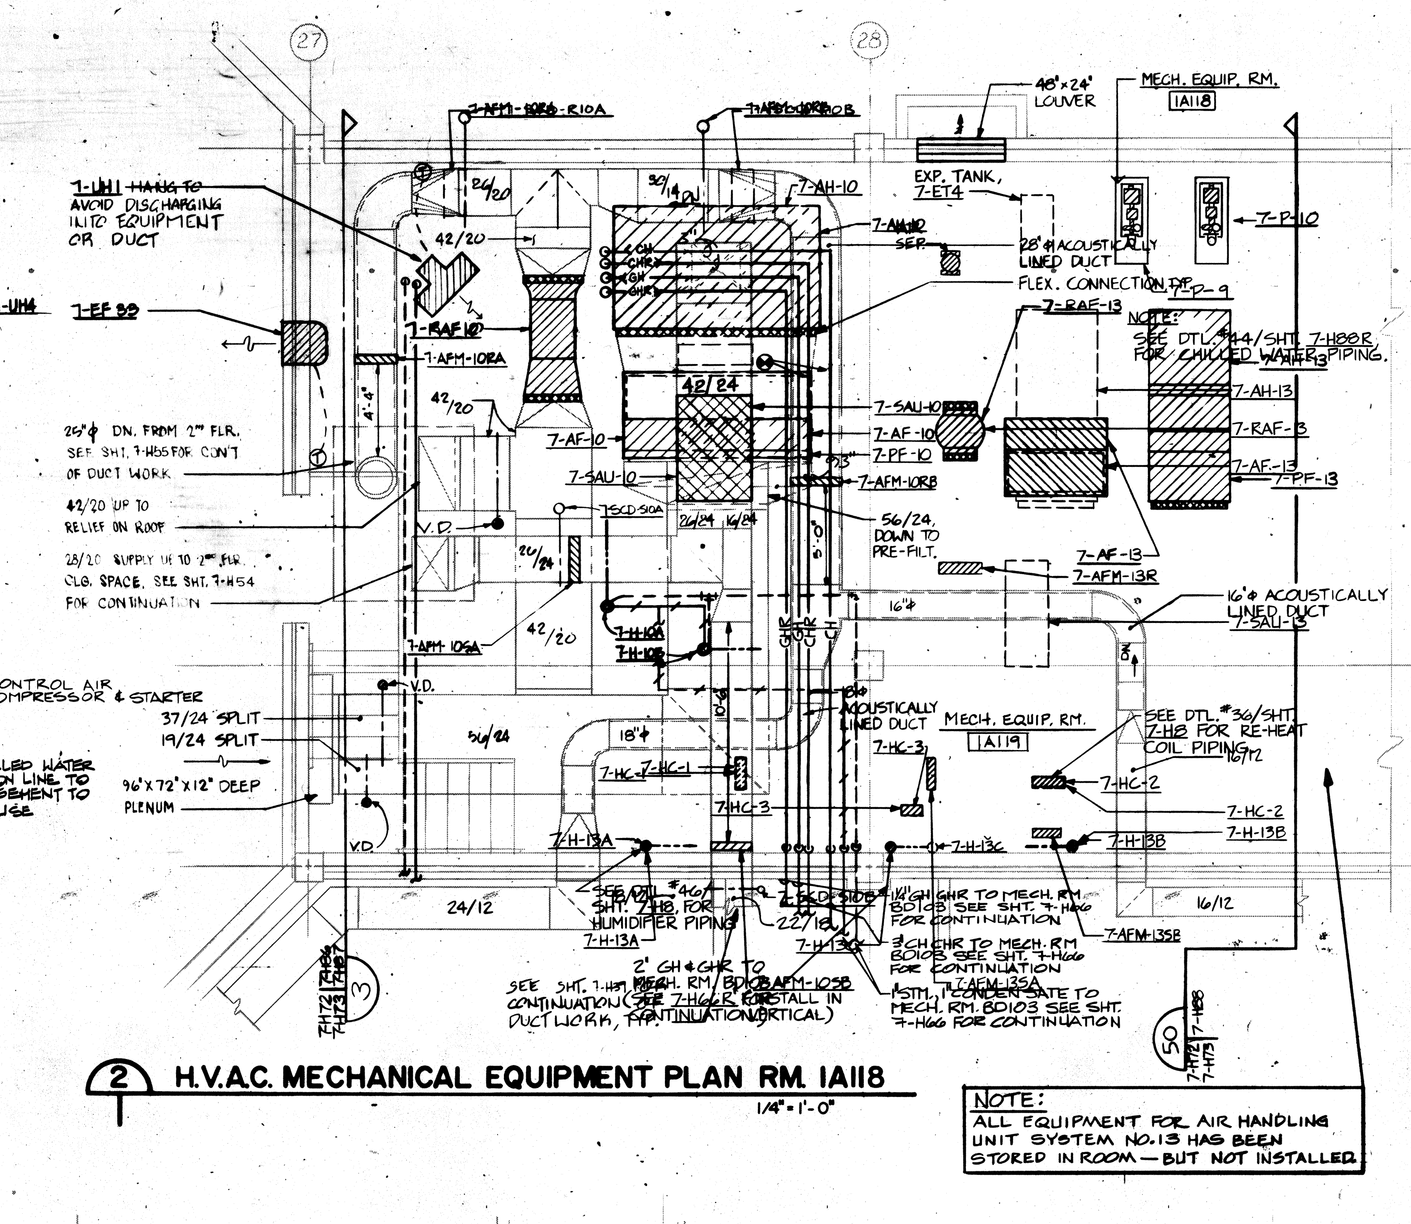

2 H.V.A.C. MECHANICAL EQUIPMENT PLAN RM. 1A118
1/4"=1'-0"

NOTE:
ALL EQUIPMENT FOR AIR HANDLING UNIT SYSTEM NO.13 HAS BEEN STORED IN ROOM — BUT NOT INSTALLED

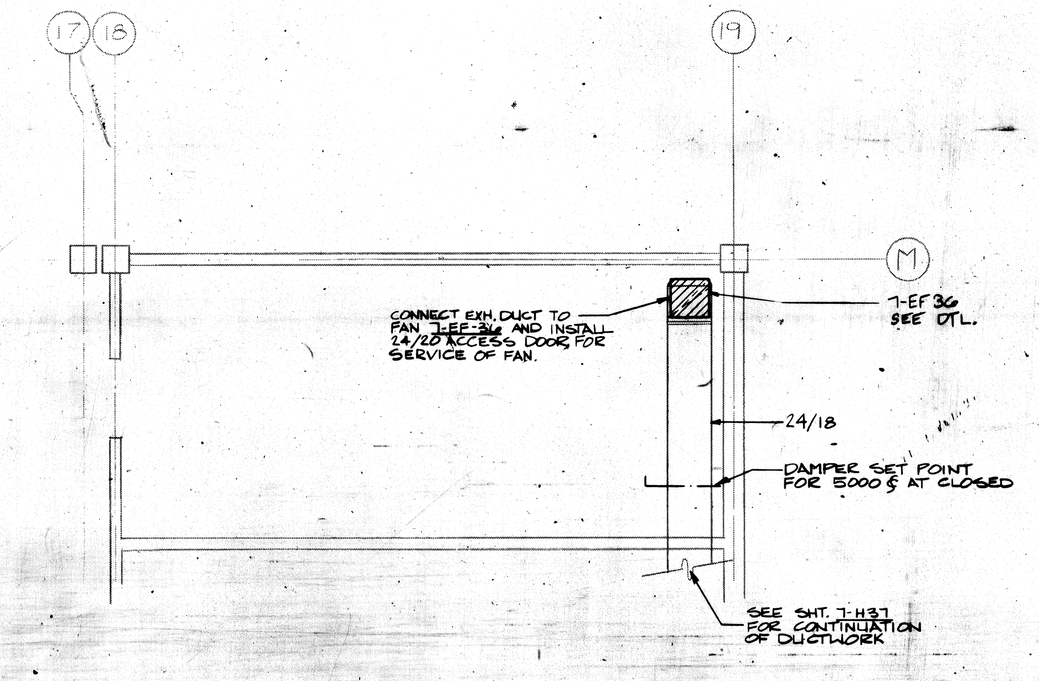

3 PIPE BASEMENT EXHAUST SYSTEM
1/4"=1'-0"

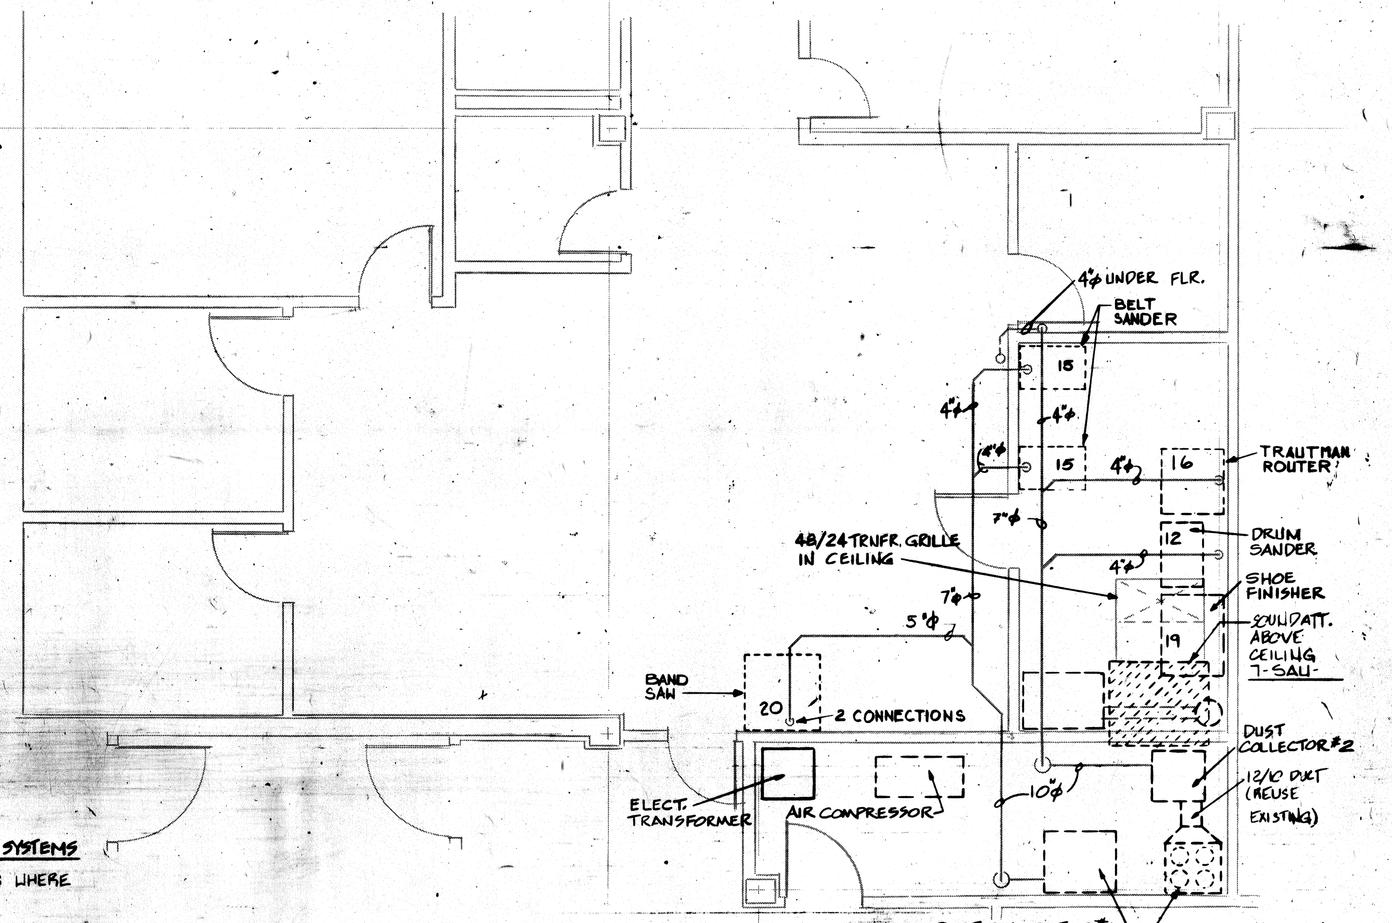

4 PROSTHETICS DUST COLLECTION SYSTEM
1/4"=1'-0"

NOTES FOR PROSTHETICS DUST COLLECTION SYSTEMS

1. CONTRACTOR MAY REUSE DUCT & FITTINGS WHERE APPLICABLE.
2. ALL HORIZONTAL DUCT SHALL BE ABOVE CEILING.
3. DASHED LINES INDICATE EXISTING EQUIPMENT IN PRESENT V.A. HOSPITAL.

RECORD DRAWING

Revisions	Date
1	4-1-87

A JOINT VENTURE OF:
2080 PEABODY AVENUE, MEMPHIS, TENNESSEE 38104
YEATES, GASKILL, RHODES, ARCHITECTS, INC.
CROMWELL, TRUEMPER, LEVY, PARKER & WOODSMALL, INC., ARCHITECTS – ENGINEERS
PICKERING, WOOTEN, SMITH & WEISS, INC., CONSULTING ENGINEERS
THOMPSON – MILLER ARCHITECTS, INC.

6-7-2-0260

Drawing Title	MECH. RM. 1A118 PIPING
Scale	1/4" : 1'-0"
Project Title	120 BED S.C.I. UNIT
Date	2-1-83
Project No	614-014
Approved Project Director	
Drawn	EEG
Checked	WMW
Building Number	7
Location	V.A.M.C. MEMPHIS
DRAWING NO	7-H74
Dwg: Of	

Veterans Administration