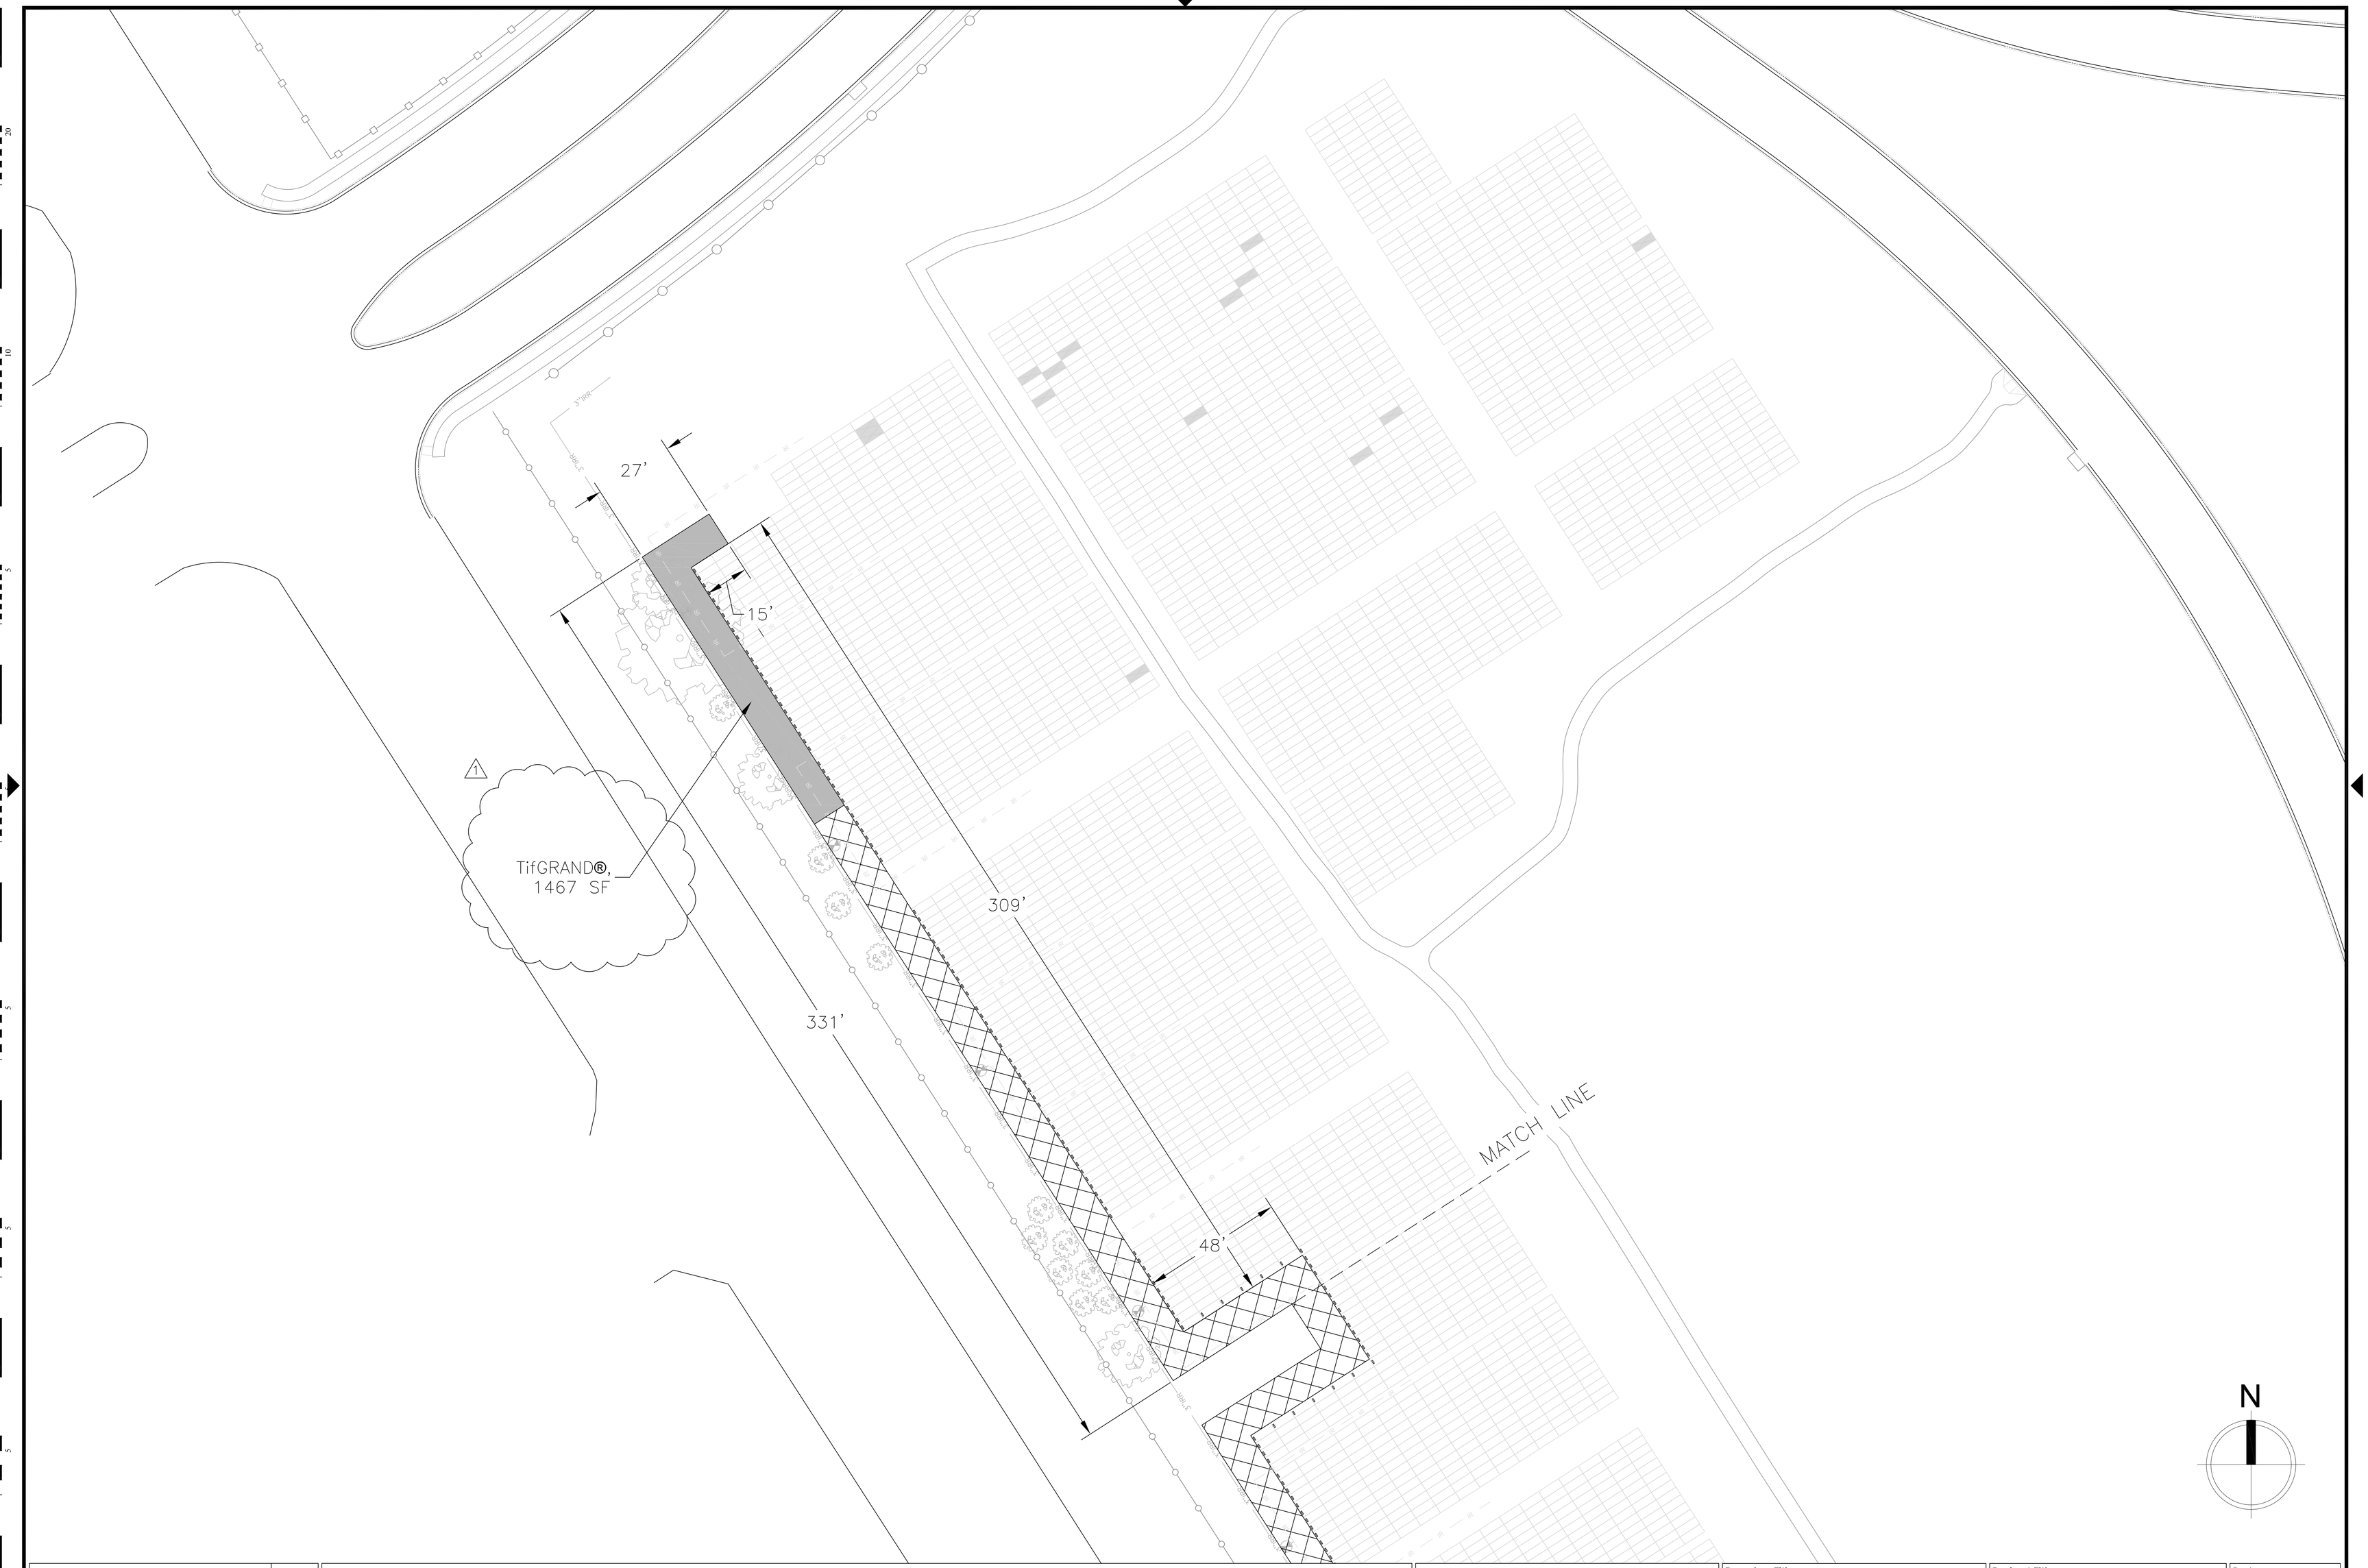

1 TifGRAND FOR SHADY AREA

Revisions | Date

one inch = twenty feet

NATIONAL CEMETERY ADMINISTRATION

Drawing Title
SLOPE STABILIZATION PLAN, NORTH

Project Title
STABILIZE GRASS SLOPE

Date
06/15/2017

Project No.
851-19-301

Approved: Division Chief

Building Number

Checked

Drawn
CFC

DRAWING NO.
L-101

Approved: Service Director

Location
HOUSTON NATIONAL CEMETERY

Dwg. **2** Of **3**