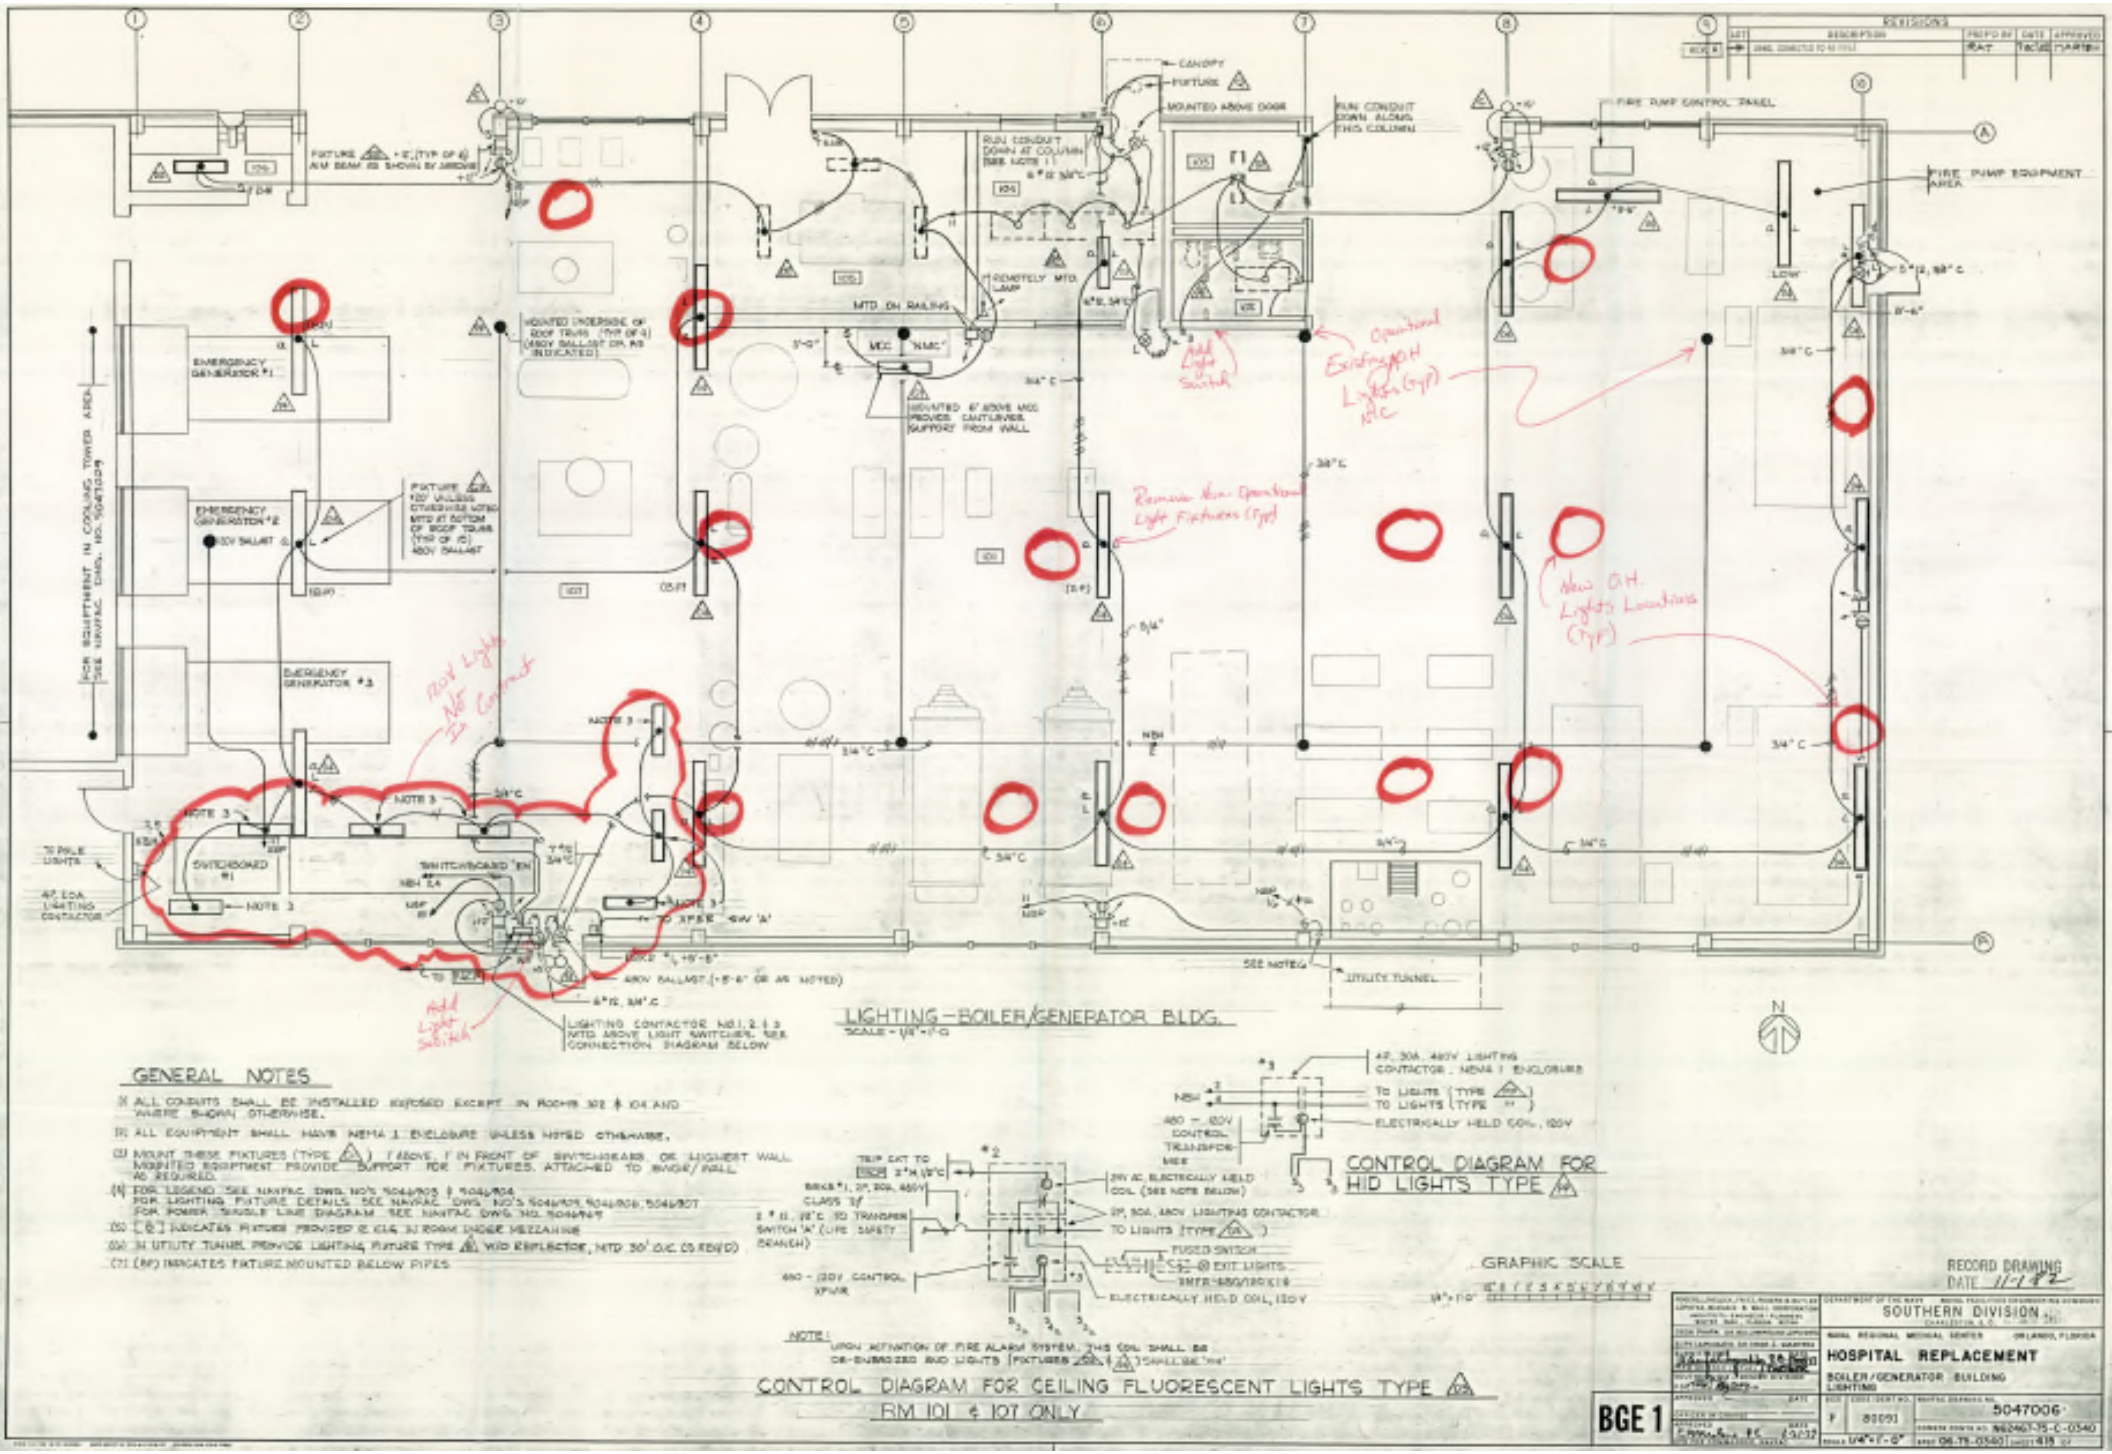

LIGHTING – BOILER/GENERATOR BLDG.
SCALE – 1/8" = 1'-0

GENERAL NOTES

1. ALL CONDUITS SHALL BE INSTALLED EXPOSED EXCEPT IN ROOMS 102 & 104 AND WHERE SHOWN OTHERWISE.
2. ALL EQUIPMENT SHALL HAVE NEMA 1 ENCLOSURE UNLESS NOTED OTHERWISE.
3. MOUNT THESE FIXTURES (TYPE ⚠) 1' ABOVE, 1' IN FRONT OF SWITCHGEAR OR LIQUIDTIGHT WALL MOUNTED EQUIPMENT. PROVIDE SUPPORT FOR FIXTURES ATTACHED TO ENCLOSURE/WALL AS REQUIRED.
4. FOR LEGEND SEE NAVFAC DWG NO'S 5046/803 & 5046/804. FOR LIGHTING FIXTURE DETAILS SEE NAVFAC DWG NO'S 5046/809, 5046/808, 5046/807. FOR POWER SINGLE LINE DIAGRAM SEE NAVFAC DWG NO. 5046/849
5. [E] INDICATES FIXTURES PROVIDED IN RM 3J ROOM UNDER MEZZANINE
6. IN UTILITY TUNNEL PROVIDE LIGHTING FIXTURE TYPE ⚠ W/O REFLECTOR, MTD 30" O.C. (5 REQ'D)
7. (RF) INDICATES FIXTURE MOUNTED BELOW PIPES

NOTE:
UPON ACTIVATION OF FIRE ALARM SYSTEM, THIS COIL SHALL BE DE-ENERGIZED AND LIGHTS (FIXTURES TYPE ⚠) SHALL BE "ON"

CONTROL DIAGRAM FOR CEILING FLUORESCENT LIGHTS TYPE ⚠
RM 101 & 107 ONLY

CONTROL DIAGRAM FOR HID LIGHTS TYPE ⚠

GRAPHIC SCALE
1/8"=1'-0"

RECORD DRAWING
DATE 11-1-82

SOUTHERN DIVISION
CHARLESTON, S.C.
NAVAL REGIONAL MEDICAL CENTER ORLANDO, FLORIDA

HOSPITAL REPLACEMENT
BOILER/GENERATOR BUILDING LIGHTING

BGE 1

DESIGN DIST. NO.	5047006
F	80091
CONTRACT NO.	N62467-75-C-0340
SCALE	1/4"=1'-0"
AMD	06-79-0340