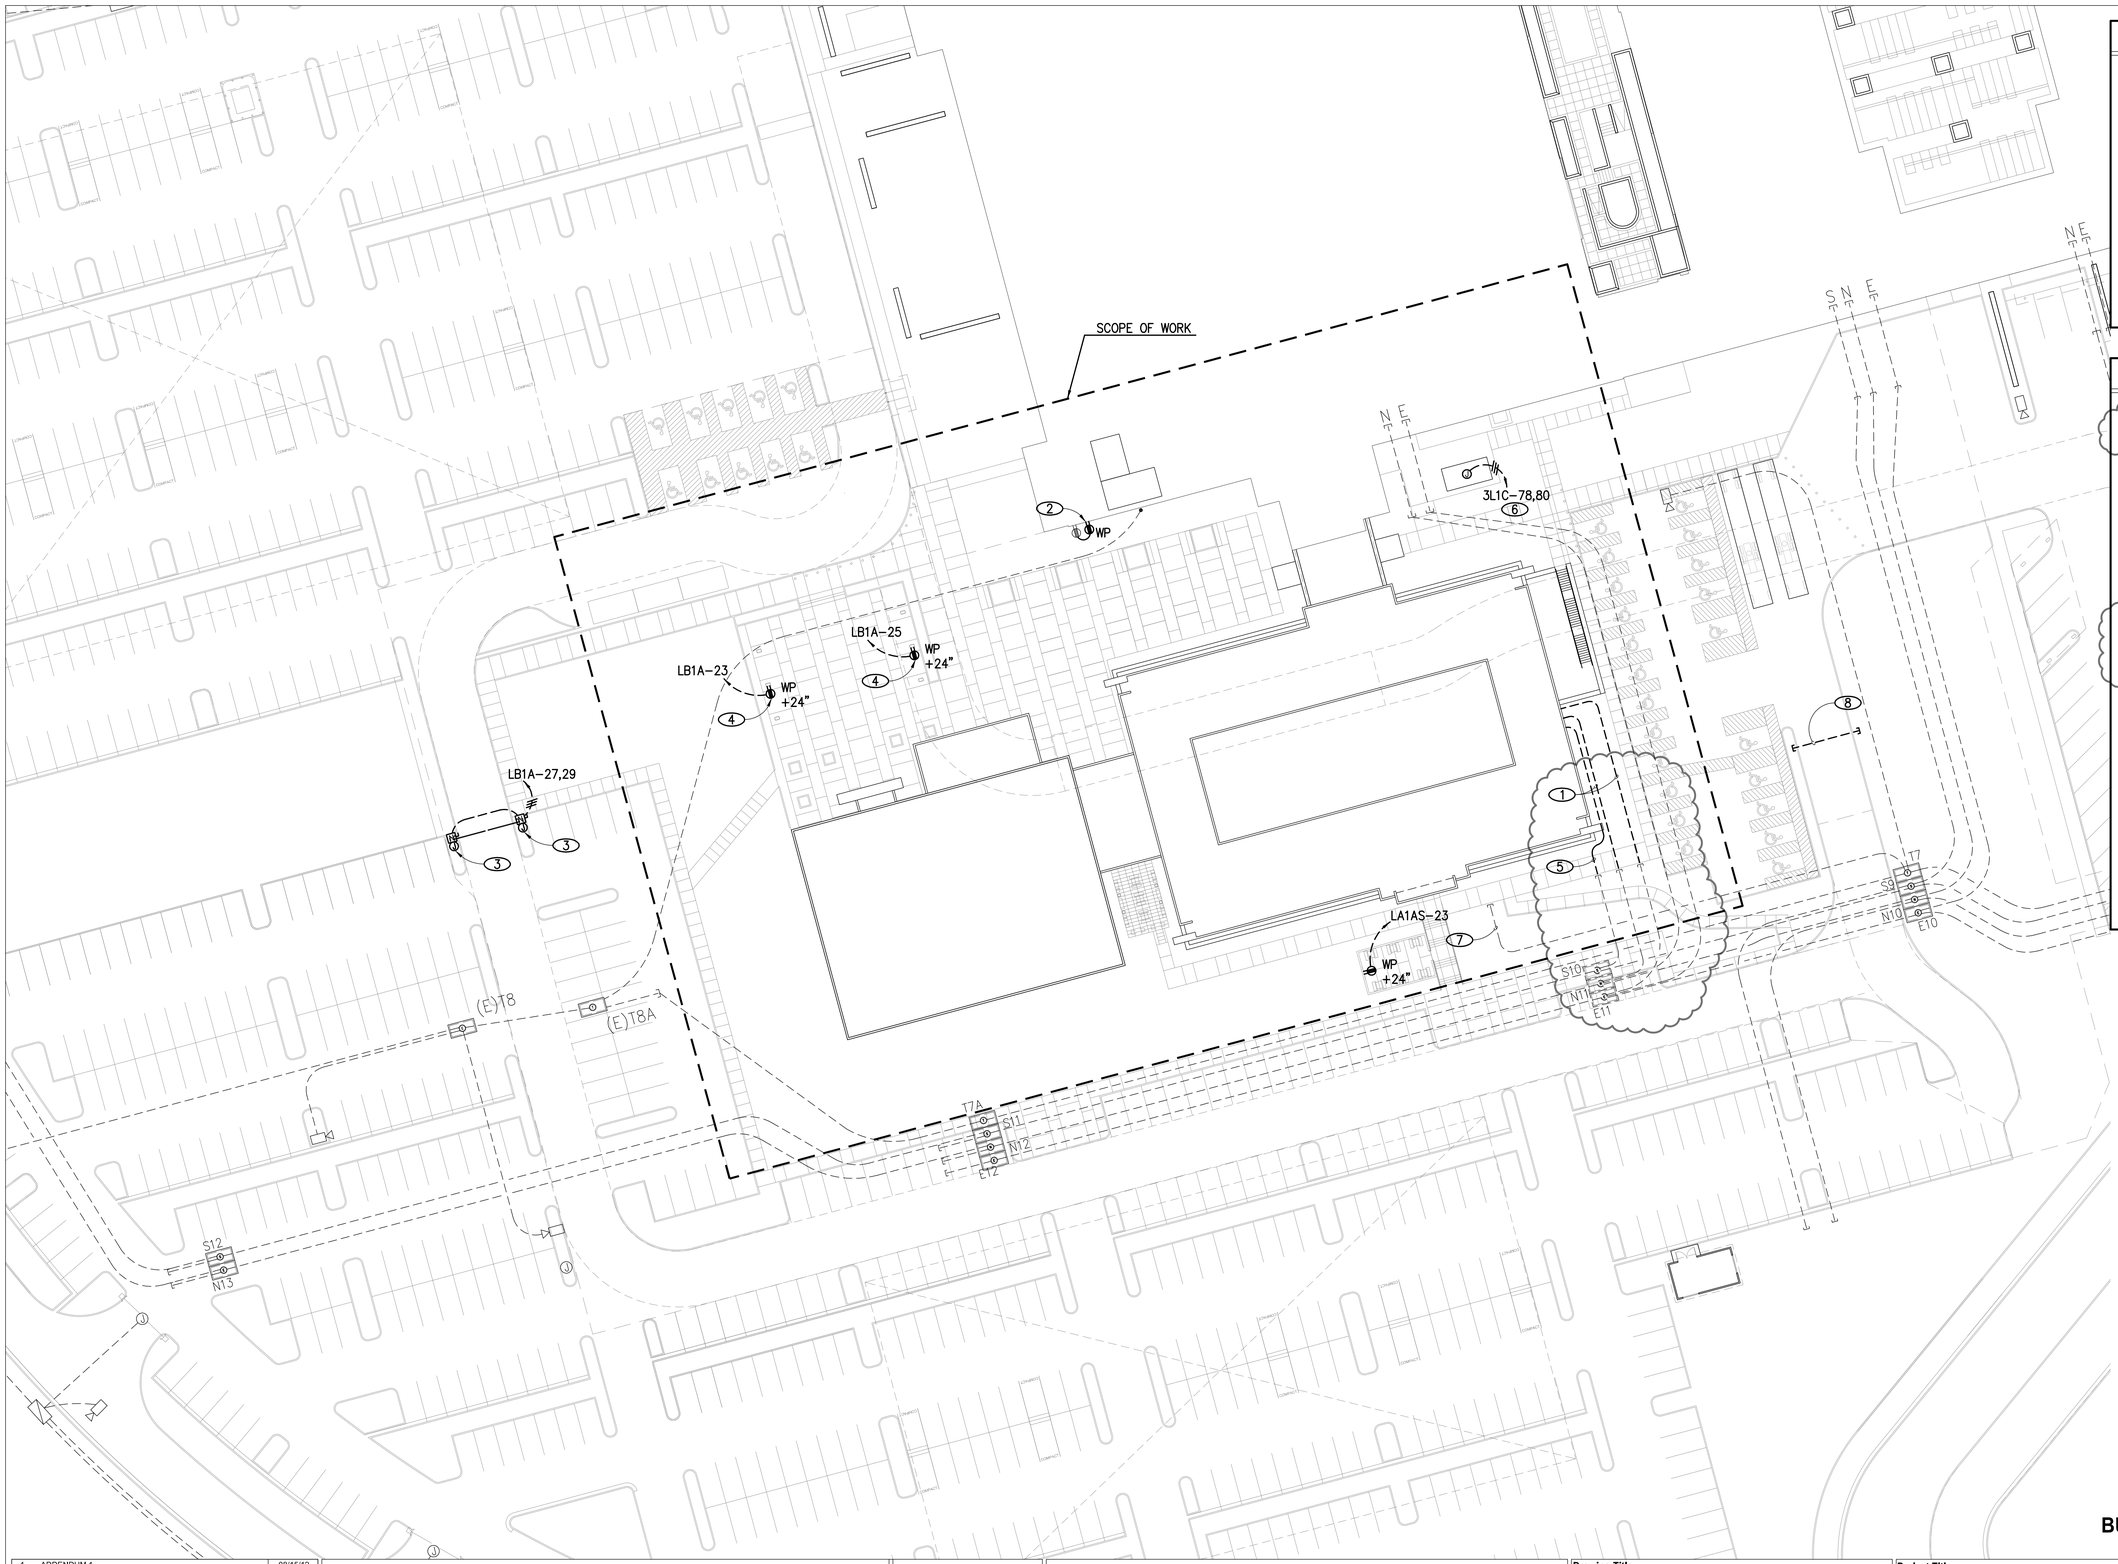

NOTICE

1. EXISTING SHOWN LIGHT AND NEW SHOWN BOLD.

NOTES

1. REFER TO SINGLE LINE DIAGRAMS FOR CIRCUITING REQUIREMENTS TO UNIT-SUBSTATION. PROVIDE (4) 6"C.
2. COORDINATE ROUGH-IN WITH LANDSCAPE IRRIGATION CONTROLLER. CONNECT TO EXISTING CIRCUIT SERVING EXISTING CONTROLLERS AT THIS LOCATION. FIELD VERIFY.
3. 120V CONNECTION TO GATE OPERATOR. COORDINATE CONNECTION REQUIREMENTS WITH ACTUAL EQUIPMENT AND SECURITY DRAWINGS.
4. COORDINATE ROUGH-IN WITH CANOPY STRUCTURE.
5. (1) 4"C & CABLE FOR BMS. (1) 4"C & CABLE FOR ATS. (1) 4"C FOR LIGHTING CONTROLS. (2) 4"C FOR SPARE. COORDINATE CABLING REQUIREMENTS FOR ALL SYSTEMS WITH SYSTEM VENDOR.
6. RECONNECT SMOKING SHELTER TO EXISTING CIRCUIT MAINTAINED FROM DEMOLITION. EXTEND EXISTING 3" CONDUIT TO NEW STUB UP LOCATION AND PULL NEW CONDUCTORS FROM SERVING PANEL INDICATED. (3 #1/0 & 1 #2 GRND)
7. REFER TO DIVISION 27 DRAWINGS FOR COMMUNICATIONS REQUIREMENTS.
8. PROVIDE (4) 1"C UNDER DRIVE FOR FUTURE USE. STUB AND CAP BELOW GRADE.

CONSTRUCTION DOCUMENTS
BUILDING IS FULLY SPRINKLERED

10.0264

Revisions:	Date:
1 ADDENDUM 1	08/15/12

CONSULTANTS:

CIVIL:	SLATER HANIFAN GROUP, 5740 S. ARVILLE ST. #216, LAS VEGAS, NV 89118
LANDSCAPE:	J W ZUNINO LANDSCAPE ARCHITECTURE, 3191 S. JONES BLVD., LAS VEGAS, NV 89146
MEP:	JBA CONSULTING ENGINEERING, 5155 WEST PATRICK LANE, LAS VEGAS, NV 89118
STRUCTURAL:	DEGENKOLB ENGINEERING, 235 MONTGOMERY STREET, SUITE 500, SAN FRANSISCO CA 94104
GEOTECHNICAL:	NINYO AND MOORE, 6700 PARADISE ROAD, SUITE E, LAS VEGAS, NV 89119
FIRE & LIFE SAFETY:	LASALLE ENGINEERING, 1000 YORK ROAD, WILLOW GROVE, PA 19090

KEY PLAN

ARCHITECT/ENGINEERS:

RTKL
JMA ARCHITECTURE STUDIOS
A Joint Venture

N TRUE

Drawing Title: Electrical - Site Plan - Power
Scale: 1" = 30'-0"
Approved: Project Director: Milan Arsikin

Project Title: VA Medical Center - PHASE V, Administration Bldg. & Education Ctr. Addition
Location: North Las Vegas, NV
Date: June 15, 2012 | Checked: RRJ | Drawn: GSL

Project Number: 593CA2202
Building Number: 6
Drawing Number: ESP-101
364 of 512

Office of Construction and Facilities Management
Department of Veterans Affairs

VA FORM 08-6231