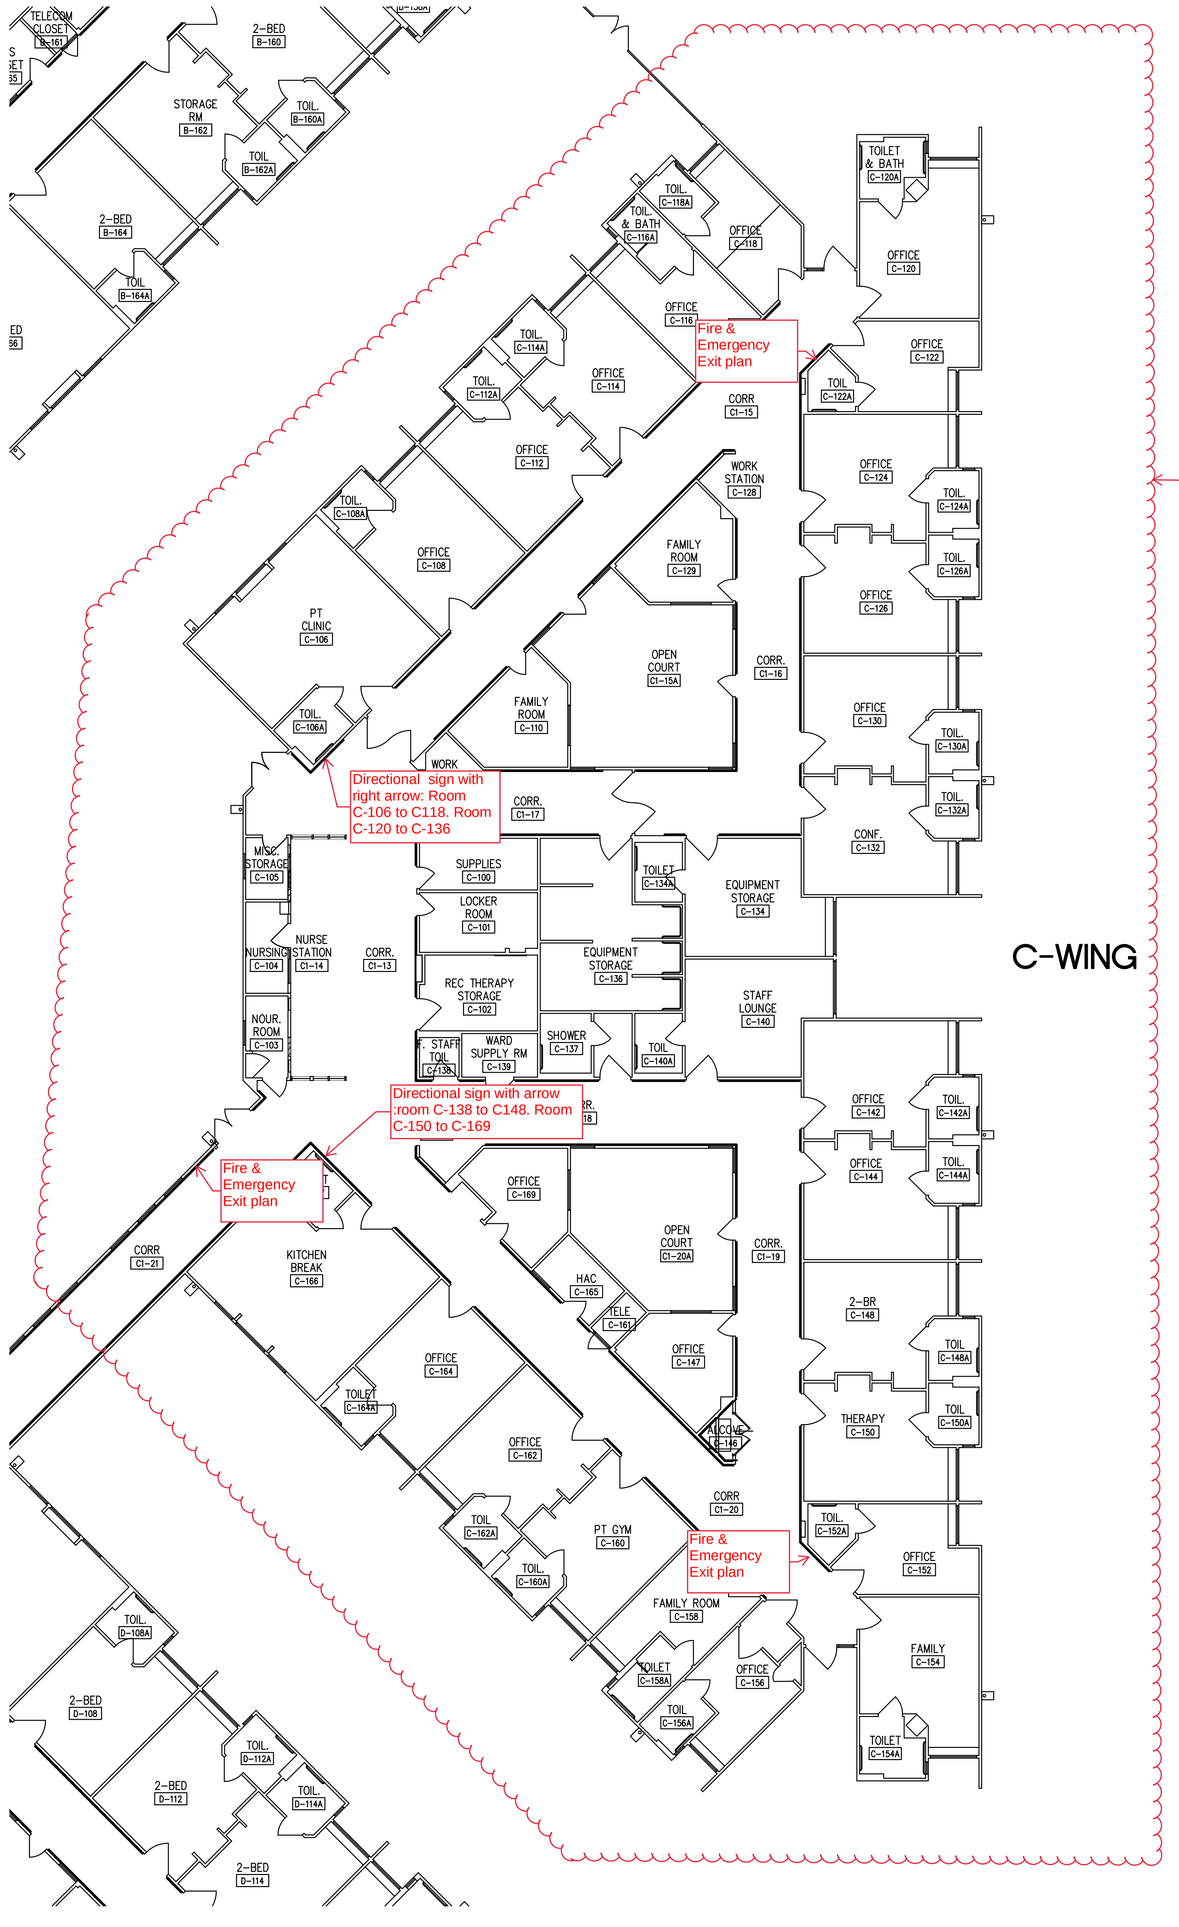

Provide replacement room number sign for C-Wing

DESIGN DEVELOPMENT - NOT FOR CONSTRUCTION

FULLY SPRINKLERED

Scale: 3/32" = 1'-0"

Revisions	Date
-	-
-	-
-	-
-	-
-	-
-	-
-	-
-	-
-	-

CONSULTANTS:

ARCHITECT/ENGINEERS:

Drawing Title: COMMUNITY LIVING CENTER FIRST FLOOR WING "C" ARCHITECTURE PLAN

Approved: Project Director
-
-
VAPAHCS PLANNING AND ENGINEERING

Project Title: BUILDING 331 (FOR REFERENCE ONLY NOT FIELD VERIFIED)

Location: MPD MENLO PARK CA

Date	Checked	Drawn
---	-	---

Project Number: -

Building Number: 331

Drawing Number: —

Dwg. --- of ---

Office of Construction and Facilities Management

Department of Veterans Affairs

VA FORM 08-6231

S:\Engineering\PROJECTS\CAD_File\Temp_CAD_Floor_Plans\MPD\Bldg_331-Community_Center\ARCH\640.000000.331-ARCH.MPD.Comm_Living_Ctr-First_Floor_Plan.01_A.dwg 1-08-14 01:20:29 PM vhapatlast