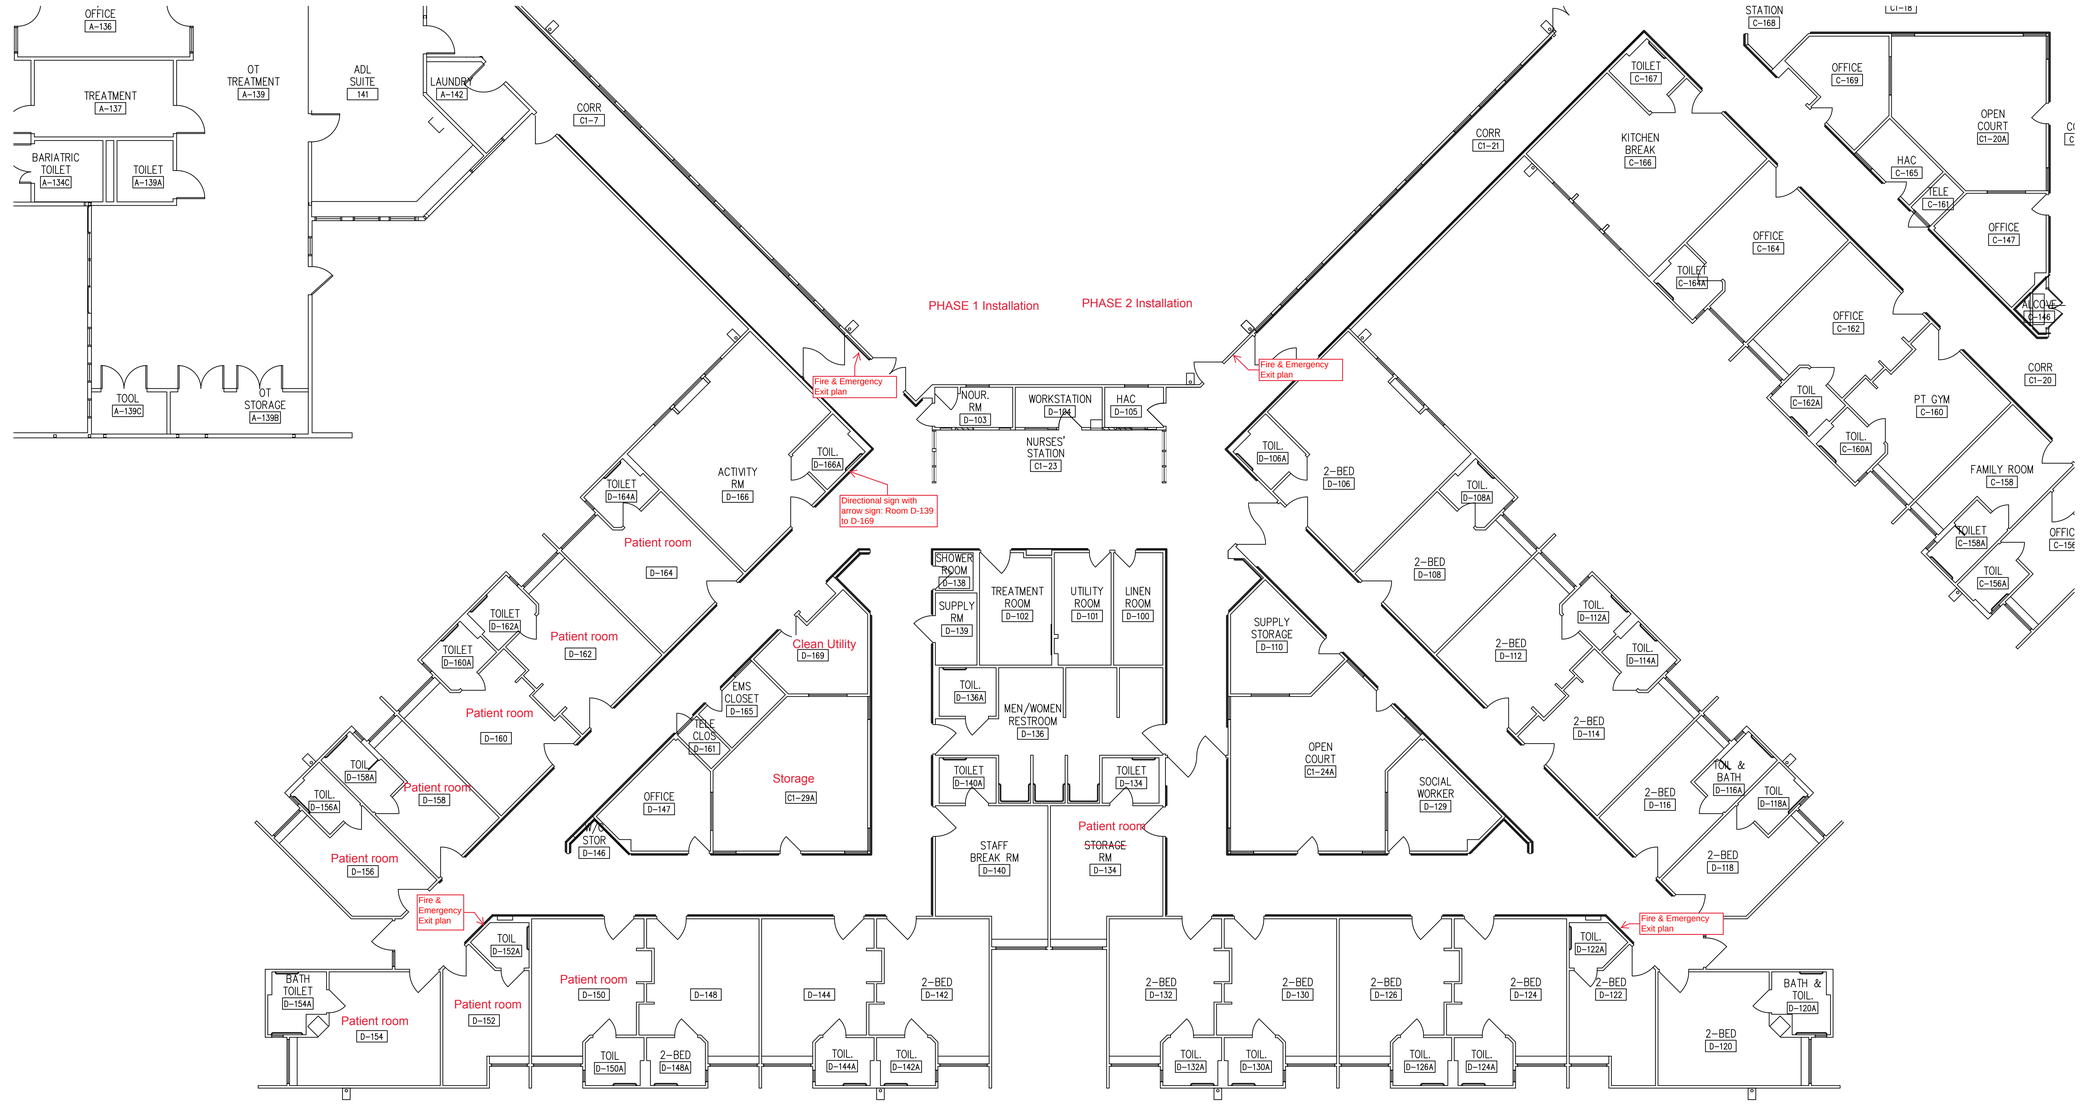

D-WING

DESIGN DEVELOPMENT - NOT FOR CONSTRUCTION

FULLY SPRINKLERED

Scale: 1/8"=1'-0"

Revisions	Date
-	-
-	-
-	-
-	-
-	-
-	-
-	-
-	-
-	-

CONSULTANTS:

ARCHITECT/ENGINEERS:

Drawing Title: COMMUNITY LIVING CENTER FIRST FLOOR WING "D" ARCHITECTURE PLAN

Project Title: BUILDING 331 (FOR REFERENCE ONLY NOT FIELD VERIFIED)

Project Number: -

Building Number: 331

Approved: Project Director
-
-
VAPAHCS PLANNING AND ENGINEERING

Location: MPD MENLO PARK CA

Drawing Number: —

Date: --

Checked: -

Drawn: ---

Dwg. -- of --

Office of Construction and Facilities Management

Department of Veterans Affairs

VA FORM 08-6231

S:\Engineering\PROJECTS\CAD_File\Temp_CAD_Floor_Plans\MPD\Bldg_331-Community_Center\ARCH\640.0000000.331-ARCH.MPD.Comm_Living_Ctr-First_Floor_Plan.01.dwg 1-09-14 11:02:14 AM vhapeltlost

one eighth inch = one foot; one quarter inch = one foot; three eighths inch = one foot; one half inch = one foot; three quarters inch = one foot; one inch = one foot; one and one half inches = one foot; three inches = one foot