AUDIT 1821
OVERLAY
%SCREEN /COLOR

one-quarter inch = one foot
three-eigths inch = one foot
one-half inch = one foot
three-quarters inch = one foot
one inch=one foot
one and one-half inches=one foot
three inches = one foot

VA FORM 08-6231A, JAN 1990 Date Plotted: 05/23/94

Revisions

	Date
1 AMENDMENT 1 DIMENSIONAL COORDINATION	01 NOV 93

Architect

Engineer

KEY PLAN

DAHL BRADEN PTM, INC.
F&S PARTNERS, INC.
A JOINT VENTURE
1825 MARKET CENTER BLVD. SUITE 520
DALLAS, TEXAS 75207-3332
(214) 748-7337 FAX (214)746-2284

STRUCTURAL ENGINEER M.E.P. AND CIVIL ENGINEERS
EDWARD L. WILSON, JR. YANDELL & HILLER, INC.
CONSULTING ENGINEERS 512 MAIN ST., SUITE 1500
2909 MAPLE AVENUE FORT WORTH, TEXAS 76102-3922
DALLAS, TEXAS 75201 (817) 335-3000
(214) 871-8801 FAX (817) 335-1025

AS-BUILT DRAWINGS

DRAWINGS HAVE BEEN REVISED TO AGREE WITH CENTRAL MEDICAL CONTRACTOR'S SUBMITTED AS-BUILT CONDITIONS

Drawing Title
REFLECTED CEILING PLAN 1/8" LEVEL ONE PLAN AREA B

Approved: Area Project Manager

Project Title
SPINAL CORD INJURY CENTER

Building Number 74
Checked MA
Drawn TMC
Date 07/20/93
Project No. 549-031
DRAWING NO. 74-35R
Dwg. Df
DB:PTM 2390.01 F3997

Location
VA MEDICAL CENTER DALLAS, TEXAS

Office of Facilities

Department of Veterans Affairs

74-35 01 REFLECTED CEILING PLAN - LEVEL ONE AREA B
SCALE 1/8" = 1'-0"

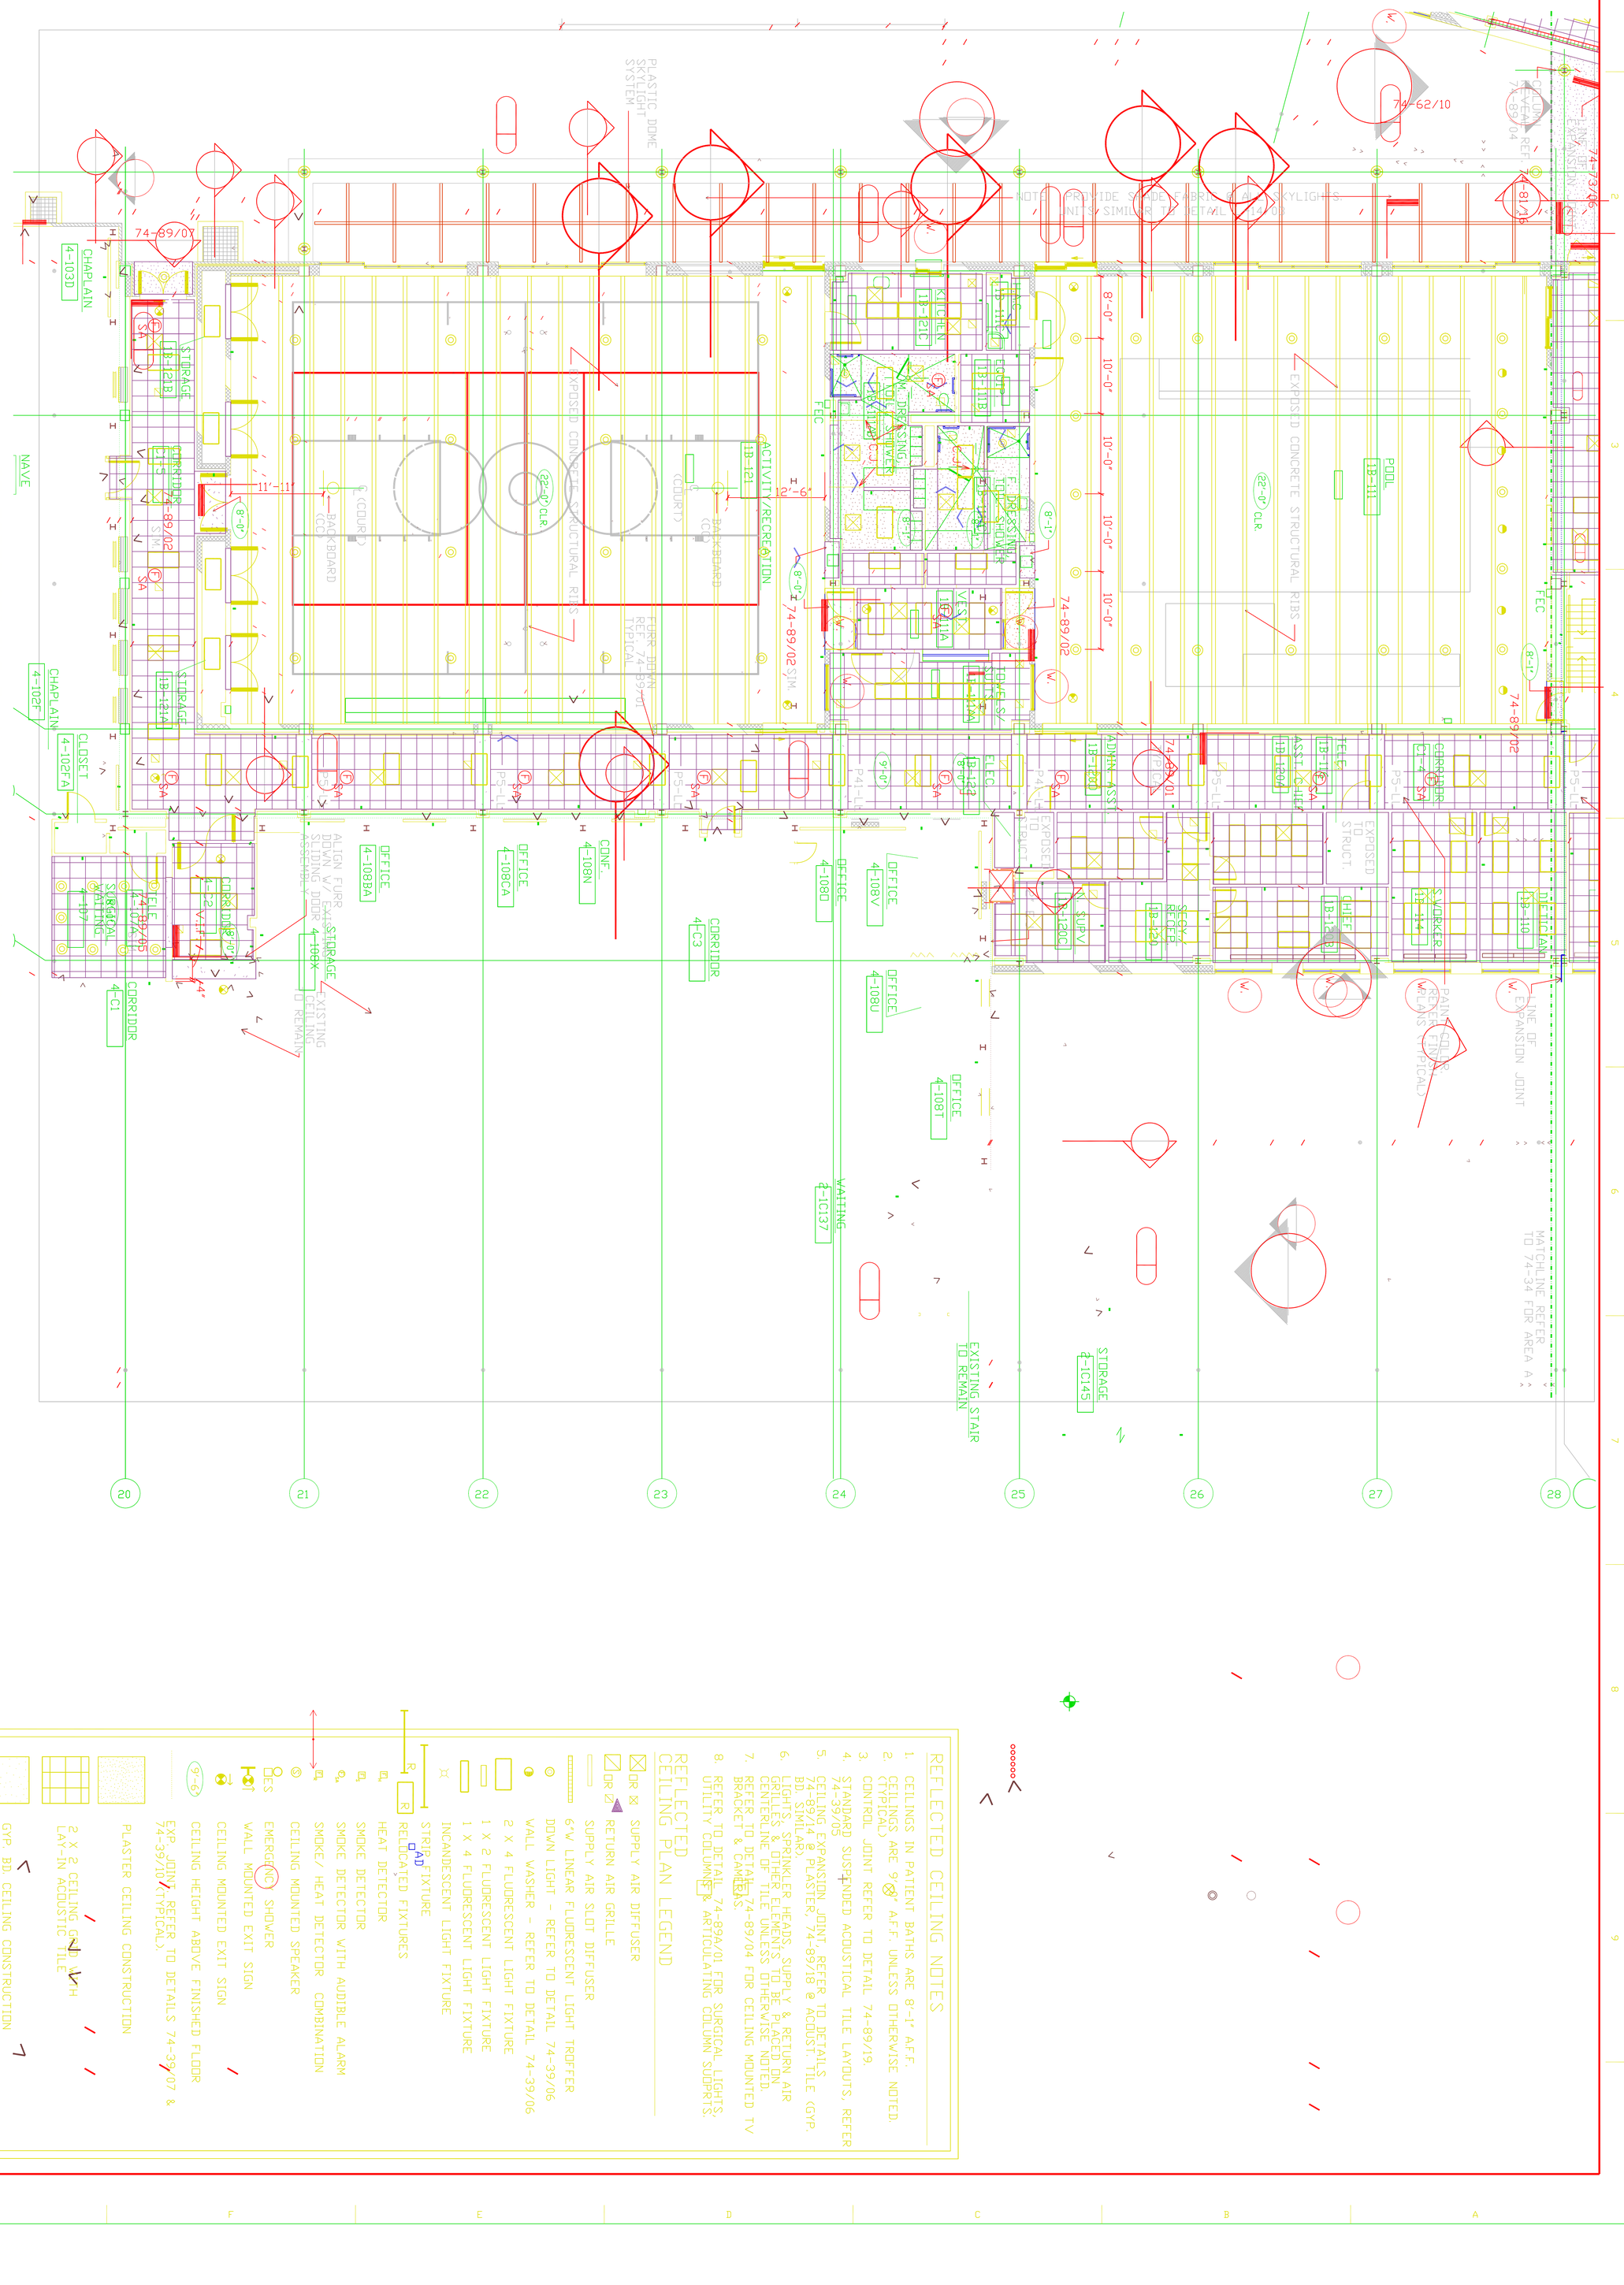

REFLECTED CEILING NOTES

1. CEILINGS IN PATIENT BATHS ARE 8'-1" A.F.F.
2. CEILINGS ARE 9'-0" A.F.F. UNLESS OTHERWISE NOTED. (TYPICAL)
3. CONTROL JOINT REFER TO DETAIL 74-89/19.
4. STANDARD SUSPENDED ACOUSTICAL TILE LAYOUTS, REFER 74-39/03
5. CEILING EXPANSION JOINT, REFER TO DETAILS 74-89/14 @ PLASTER, 74-89/18 @ ACOUST. TILE (GYP. BD. SIMILAR).
6. LIGHTS, SPRINKLER HEADS, SUPPLY & RETURN AIR GRILLES & OTHER ELEMENTS TO BE PLACED ON CENTERLINE OF TILE UNLESS OTHERWISE NOTED.
7. REFER TO DETAIL 74-89/04 FOR CEILING MOUNTED TV BRACKET & CAMERAS.
8. REFER TO DETAIL 74-89A/01 FOR SURGICAL LIGHTS, UTILITY COLUMNS & ARTICULATING COLUMN SUPPRTS.

REFLECTED CEILING PLAN LEGEND

- OR SUPPLY AIR DIFFUSER
- OR RETURN AIR GRILLE
- SUPPLY AIR SLOT DIFFUSER
- 6"W LINEAR FLUORESCENT LIGHT TROFFER
- DOWN LIGHT - REFER TO DETAIL 74-39/06
- WALL WASHER - REFER TO DETAIL 74-39/06
- 2 X 4 FLUORESCENT LIGHT FIXTURE
- 1 X 2 FLUORESCENT LIGHT FIXTURE
- 1 X 4 FLUORESCENT LIGHT FIXTURE
- INCANDESCENT LIGHT FIXTURE
- STRIP FIXTURE
- RELOCATED FIXTURES
- HEAT DETECTOR
- SMOKE DETECTOR
- SMOKE DETECTOR WITH AUDIBLE ALARM
- SMOKE/ HEAT DETECTOR COMBINATION
- CEILING MOUNTED SPEAKER
- EMERGENCY SHOWER
- WALL MOUNTED EXIT SIGN
- CEILING MOUNTED EXIT SIGN
- CEILING HEIGHT ABOVE FINISHED FLOOR
- EXP. JOINT, REFER TO DETAILS 74-39/07 & 74-39/10 (TYPICAL).
- PLASTER CEILING CONSTRUCTION
- 2 X 2 CEILING GRID WITH LAY-IN ACOUSTIC TILE
- GYP. BD. CEILING CONSTRUCTION