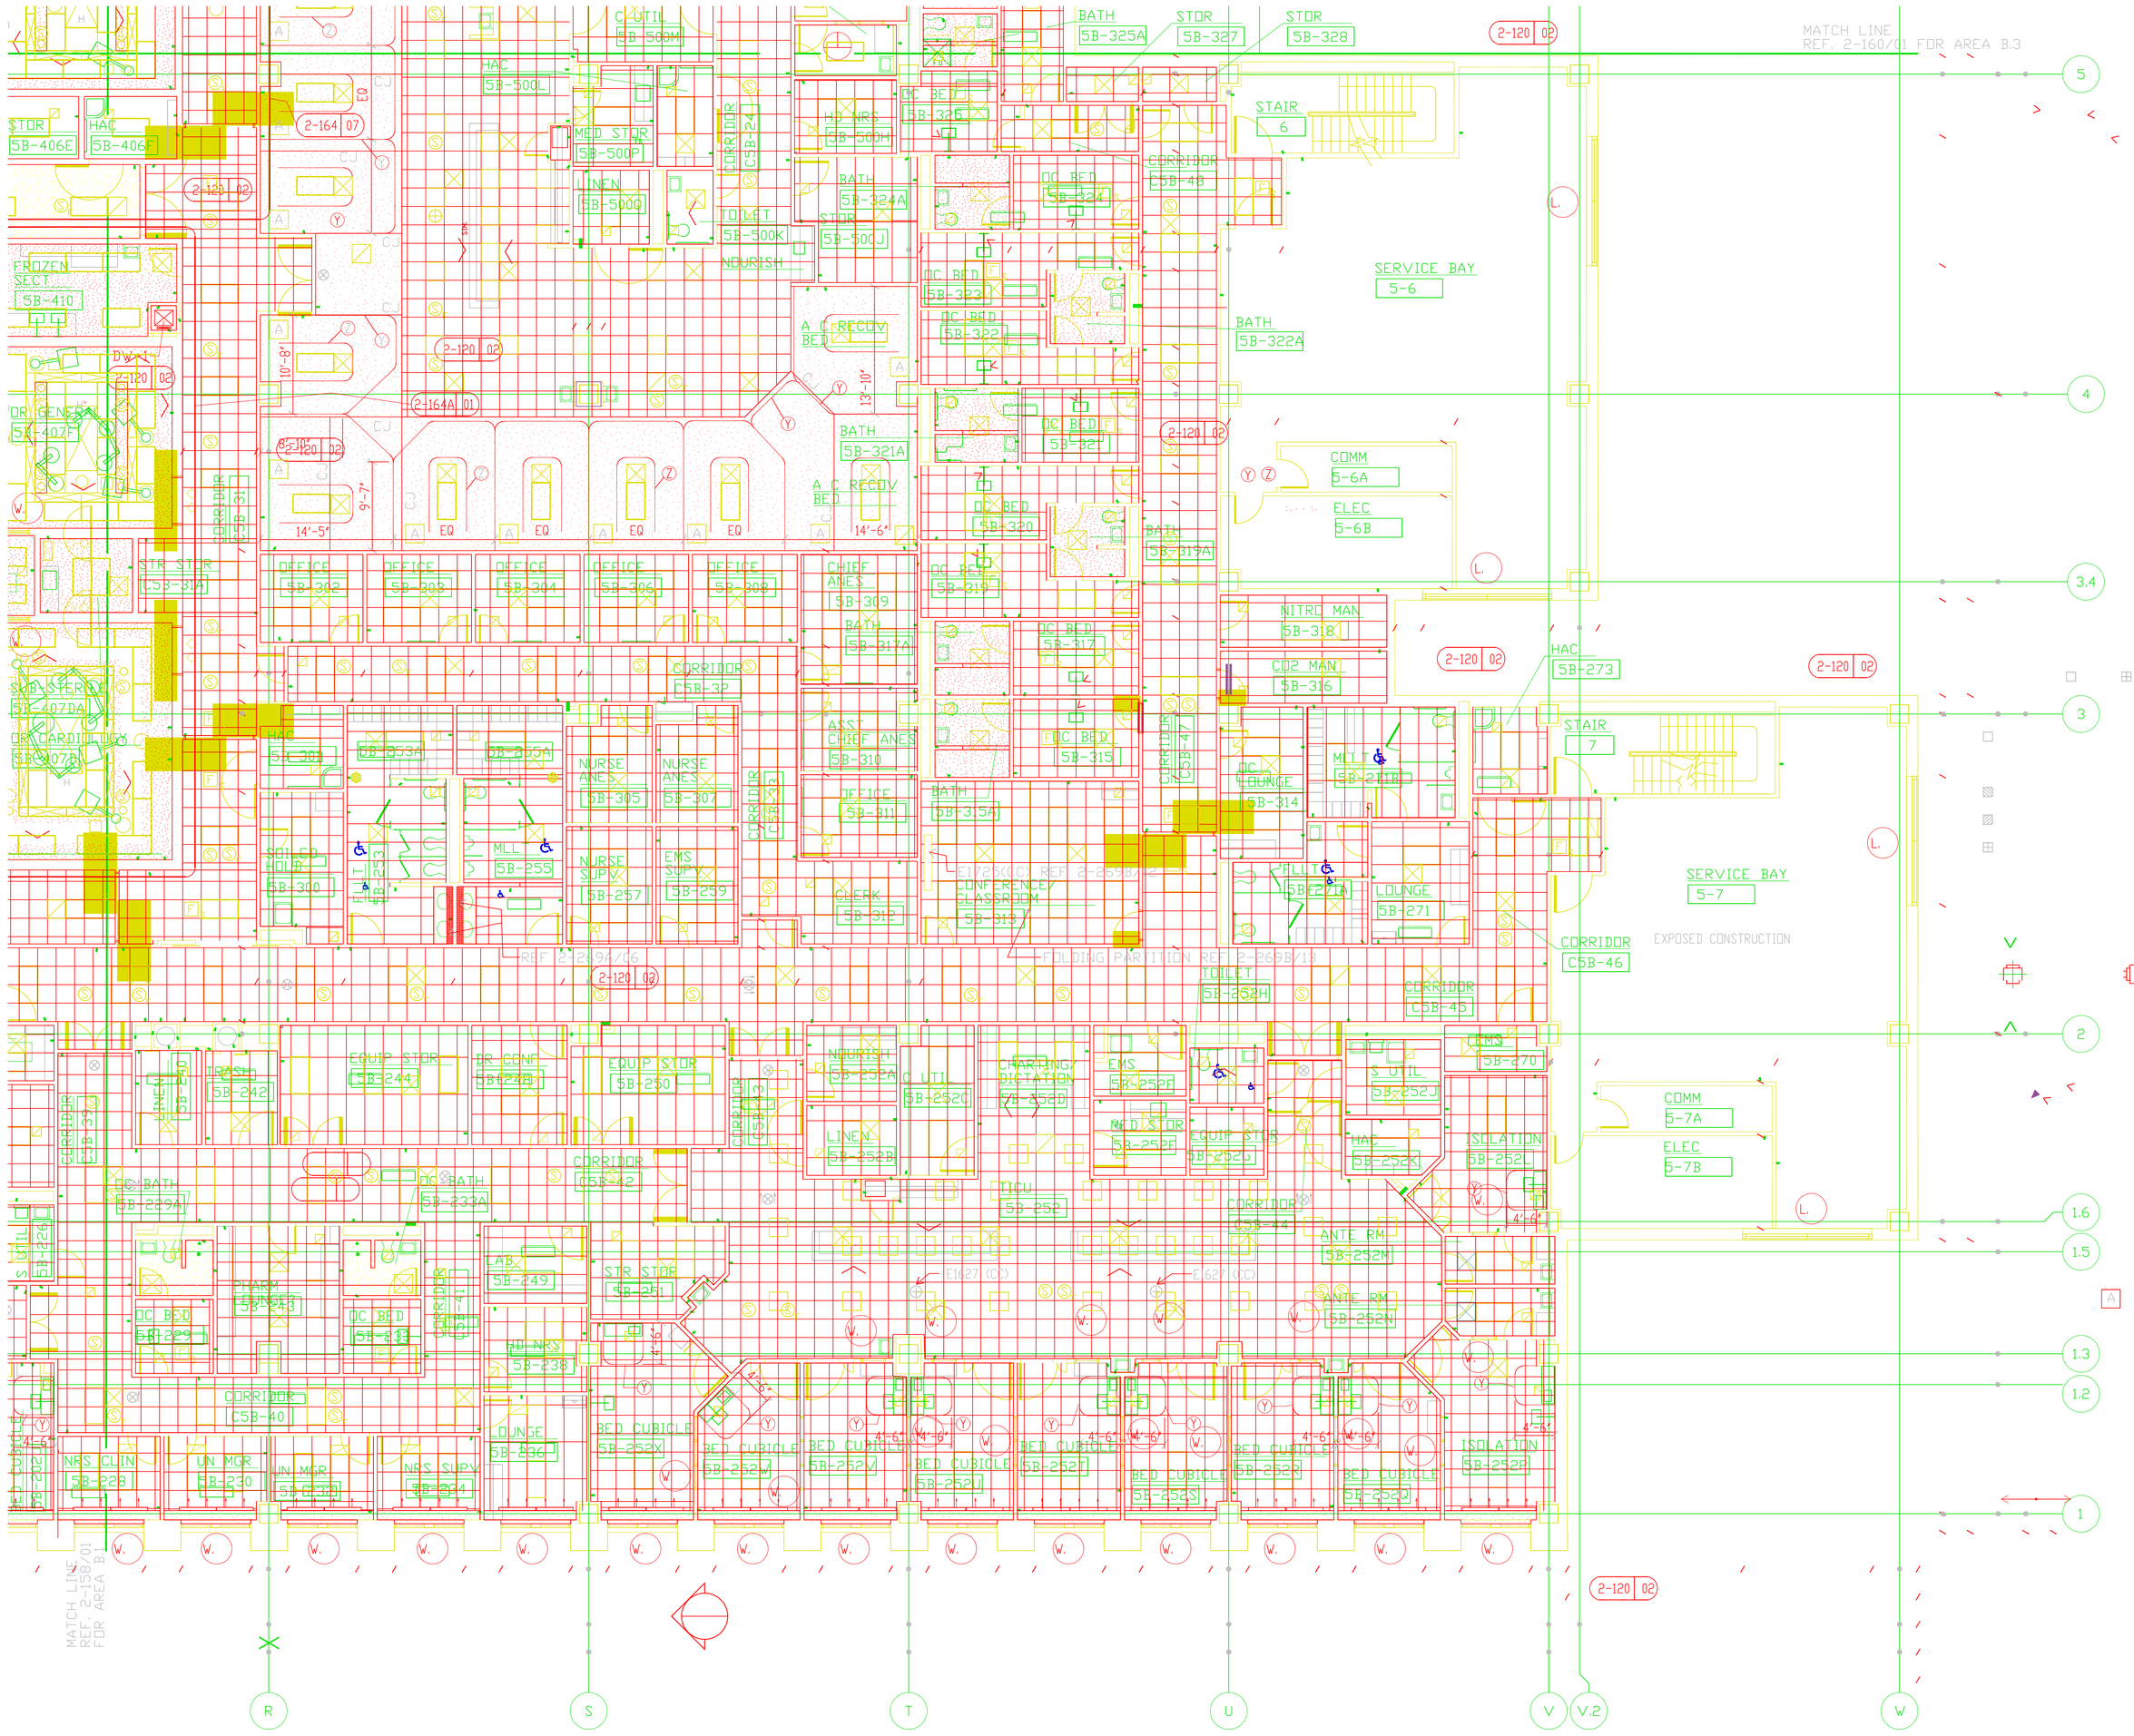

NOTES

1. SEE GENERAL ARCHITECTURAL NOTES, DRAWING 0-1.
2. ALL CEILINGS ARE 9'-0" AFF UNLESS NOTED OTHERWISE ON THE DRAWINGS.
3. SEE ENLARGED EQUIPMENT FLOOR PLANS, MECHANICAL AND ELECTRICAL DRAWINGS FOR ADDITIONAL INFORMATION ON CEILING MOUNTED EQUIPMENT.
4. SEE EQUIPMENT LEGEND, DRAWINGS 2-94 AND 2-95 AND ACCESSORY LEGEND, DRAWING 2-95 FOR DESCRIPTIONS OF CEILING MOUNTED EQUIPMENT AND ACCESSORIES.
5. REFER TO SHEET 2-269A FOR TYPICAL CEILING INSTALLATION PLANS AND DETAILS.
6. ALL TOILET AND LOCKER CEILINGS ARE 8'-1" AFF UNLESS NOTED OTHERWISE ON THE DRAWINGS.
7. ALL NEW CEILINGS IN EXISTING BUILDING 2 SHALL BE INSTALLED AT THE SAME HEIGHT ABOVE FINISH FLOOR AS PREVIOUSLY EXISTING CEILINGS UNLESS NOTED OTHERWISE ON THE DRAWINGS.
8. REFER TO SHEET 2-269B FOR TYPICAL CEILING AND ABOVE CEILING MOUNTED EQUIPMENT SUPPORT DETAILS
9. REFER TO SHEET 2-94 FOR LIST OF ROOMS SCHEDULED AS SHELLED SPACES.

REFLECTED CEILING PLAN LEGEND

NEW		EXISTING TO REMAIN
	MOTION DETECTOR	
	SUPPLY AIR DIFFUSER	
	RETURN AIR GRILLE	
	SUPPLY AIR LINEAR DIFFUSER	
	FLUORESCENT LIGHT FIXTURE	
	FLUORESCENT LIGHT FIXTURE	
	FLUORESCENT LIGHT FIXTURE	
	SURFACE MOUNTED FLUORESCENT FIXTURE	
	24"X24" ACCESS PANEL - COORDINATE LOCATION W/ HVAC	
	EXAM LIGHT	
	RECESSED LIGHT FIXTURE	
	SPEAKER	
	FIRE ALARM SPEAKER	
	SMOKE DETECTOR	
	CEILING MOUNTED EXIT SIGN	
9'-6"	CLG HT. ABOVE FIN. FLR.	
	2 X 2 CEILING GRID WITH LAY-IN ACOUSTIC TILE	
	2 X 4 CEILING GRID WITH LAY-IN ACOUSTIC TILE	
	LINEAR CEILING	
	LAYER W10,P4,P7	
	GYP. BD.	

2-161 01 LEVEL FIVE AREA B.4 REFLECTED CEILING PLAN

SCALE 1/8 "=1'-0"

Revisions	Date
2 COORDINATION	01 NOV 93
1 AMENDMENT NO. 1 - PLAN REVISIONS	01 NOV 93

AUDIT | OVERLAY | XSCREEN /COLOR

Architect

Engineer

PLAN NORTH
TRUE NORTH

KEY PLAN

DAHL BRADEN PTM, INC.
F&S PARTNERS INC.
A JOINT VENTURE
1825 MARKET CENTER BLVD., SUITE 520
DALLAS, TEXAS 75207-3332
(214) 748-7337 FAX (214) 748-2284

STRUCTURAL ENGINEER
EDWARD L. WILSON, JR
CONSULTING ENGINEERS
2909 MAPLE AVENUE
DALLAS, TEXAS 75201
(214) 871-8801

M.E.P. AND CIVIL ENGINEERS
YANDELL & HILLER, INC.
512 MAIN ST., SUITE 1500
FORT WORTH, TEXAS 76102-3922
(817) 335-3000
FAX (817) 335-1025

RECORD DRAWINGS

THE INFORMATION SHOWN ON THESE DRAWINGS HAS BEEN BASED ON DOCUMENTS PROVIDED BY THE VETERANS AFFAIRS RESIDENT ENGINEER OFFICE. THE ARCHITECT/ENGINEER OF RECORD HAS NOT VERIFIED THE ACCURACY AND/OR COMPLETENESS OF THIS INFORMATION AND SHALL NOT BE RESPONSIBLE FOR ANY ERRORS OR OMISSIONS WHICH MAY BE INCORPORATED HEREIN AS A RESULT.

Approved: Area Project Manager

Drawing Title: LEVEL FIVE - AREA B.4 REFLECTED CEILING PLAN

Project Title: CLINICAL ADDITION

Date: 7/20/93

DB/PTM 239.009
FS8917.00

Project No. 549-085

Building Number: 02

Checked: McF

Drawn: JDT

Location: VA MEDICAL CENTER DALLAS, TEXAS

DRAWING NO. 2-161R

Dwg. Of

Office of Facilities

Department of Veterans Affairs

VA FORM 08-6231A, JAN 1990 Date Plotted: JUNE 7, 1994
/usr/prch/vmc/vst04.dgn