AUDIT | OVERLAY | %SCREEN /COLOR

one-quarter inch = one foot (0 4 8) | three-eighths inch = one foot (0 4) | one-half inch = one foot (0 4) | three-quarters inch = one foot (6 0 2) | one inch=one foot (6 0 2) | one and one-half inches=one foot (6 0 1) | three inches = one foot (6 0)

VA FORM 08-6231a, JAN 1990 Date Plotted: JUNE 7, 1994
/usr/arCH/vamc/y5t83.dgn

Revisions

	Date
2 COORDINATION	01 NOV 93

Architect

Engineer

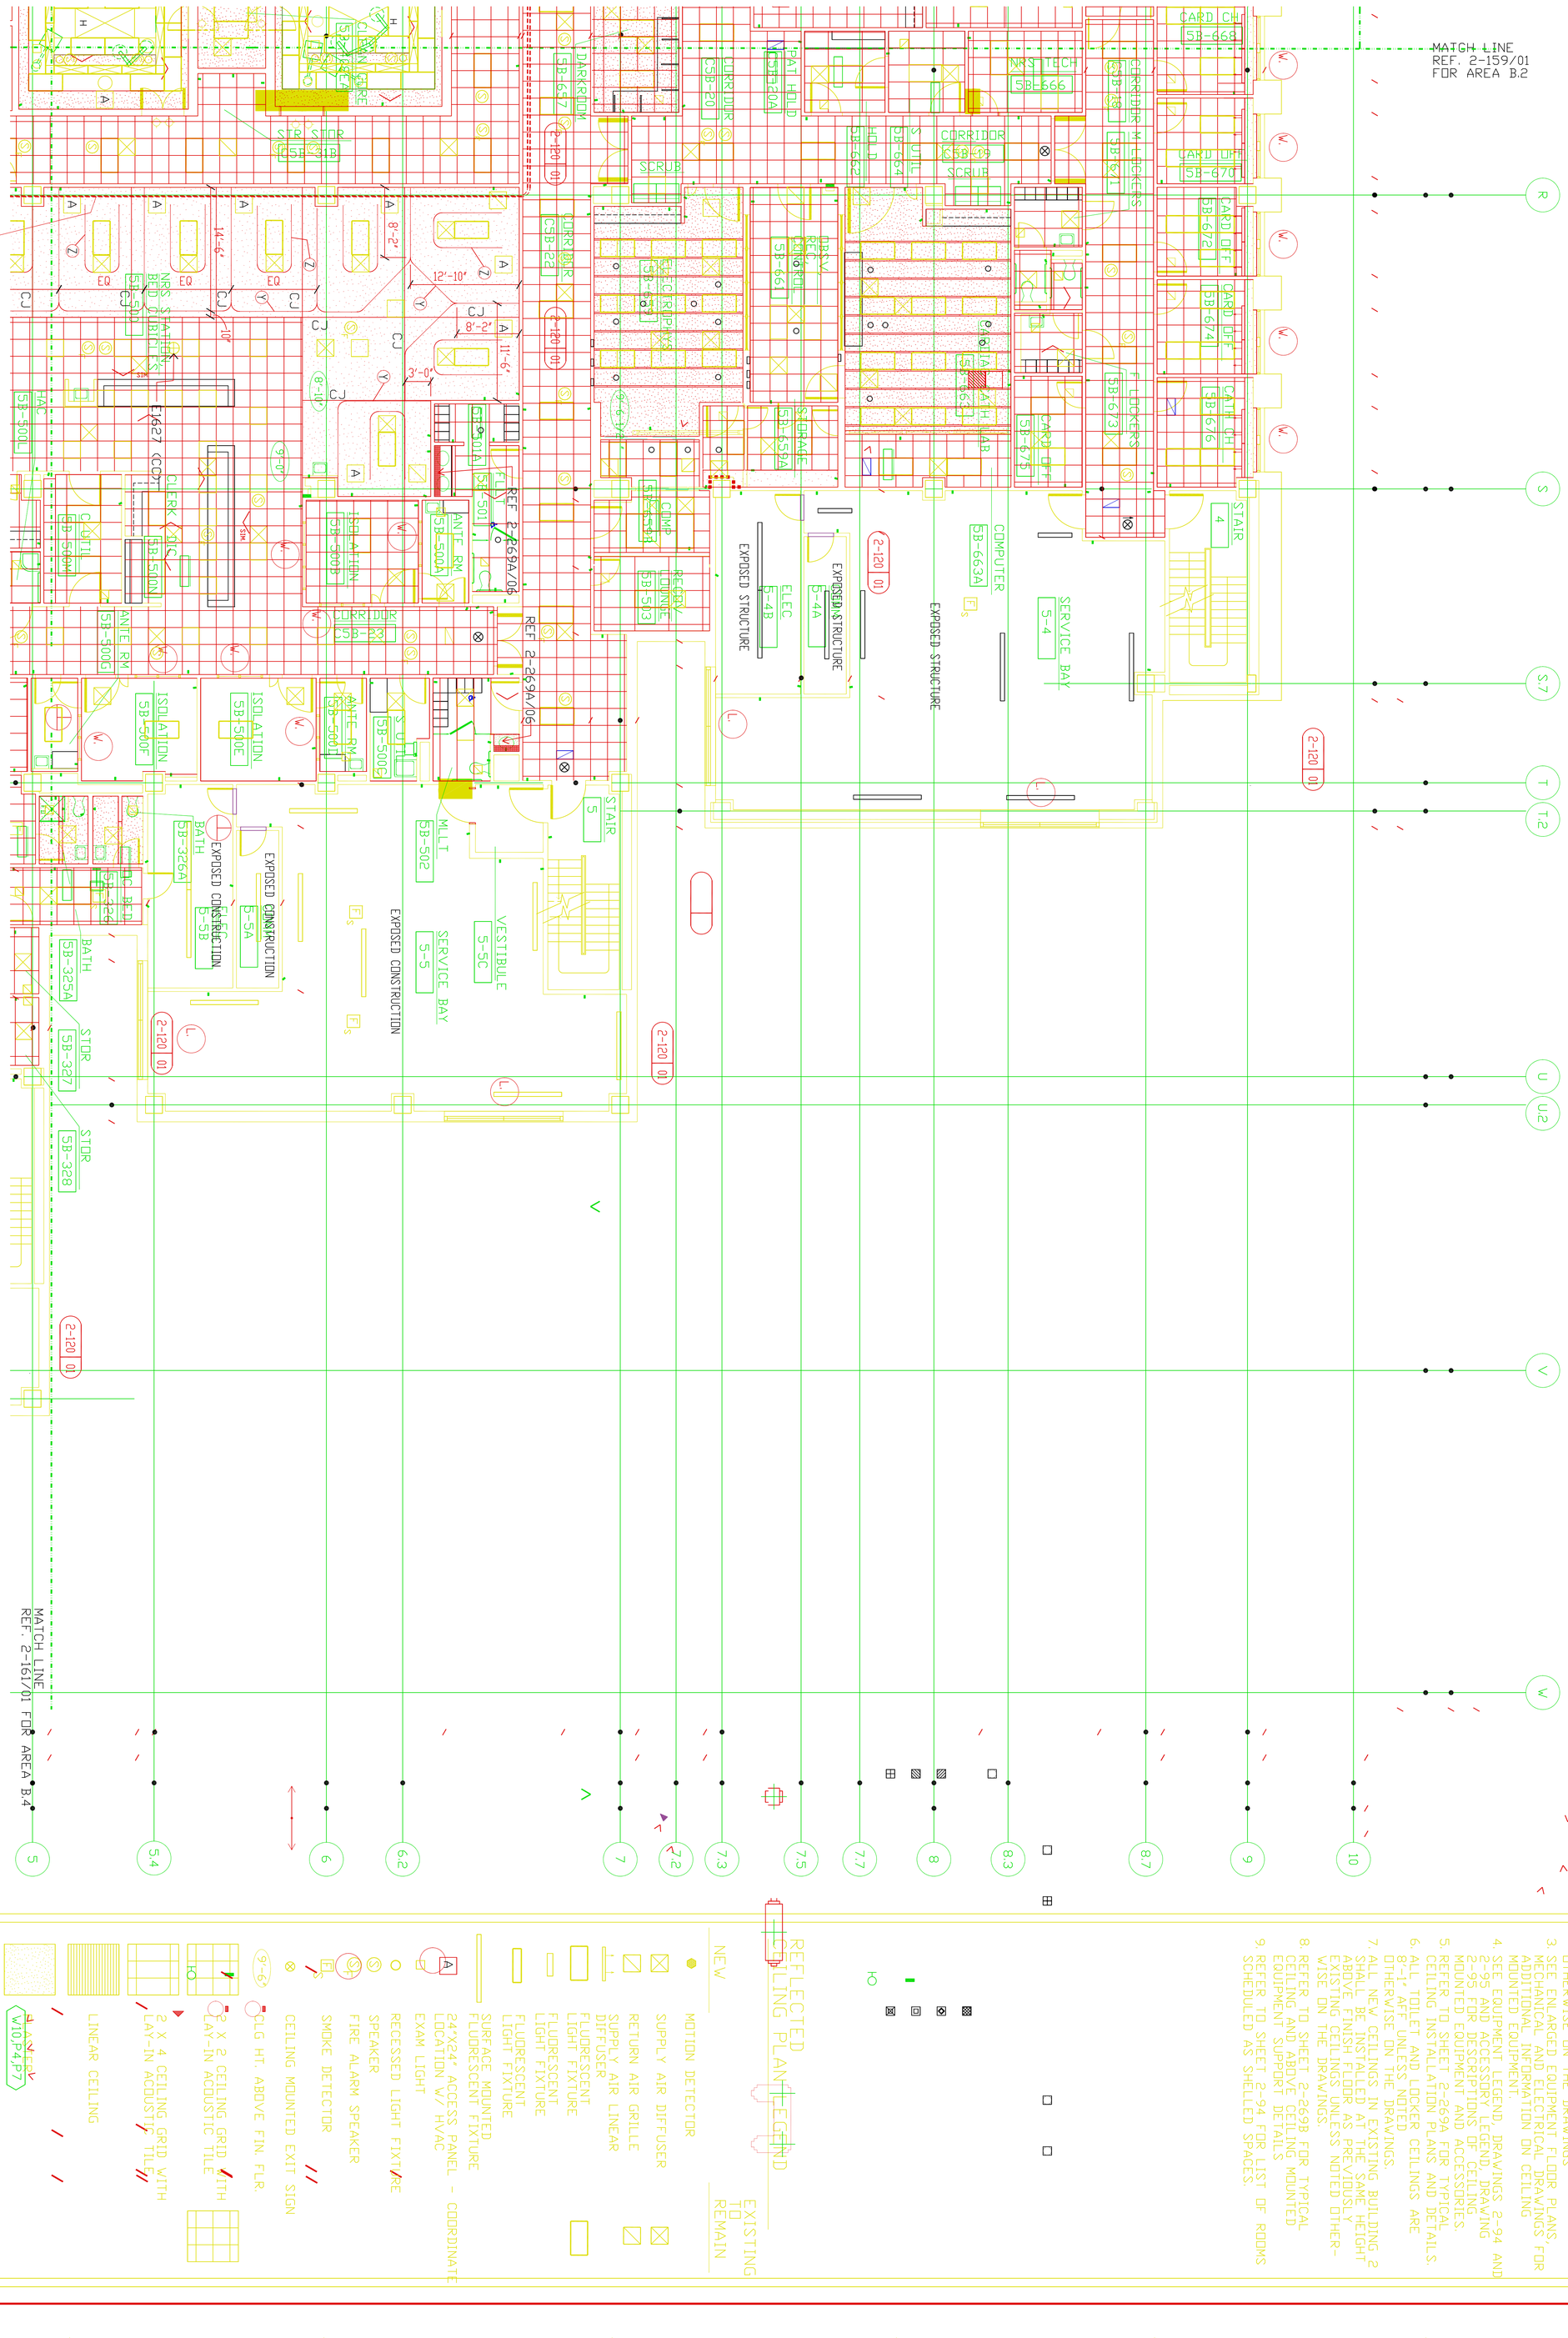

NOTES

1. SEE GENERAL ARCHITECTURAL NOTES, DRAWING 0-1.
2. ALL CEILINGS ARE 9'-0" AFF UNLESS NOTED OTHERWISE ON THE DRAWINGS
3. SEE ENLARGED EQUIPMENT FLOOR PLANS, MECHANICAL AND ELECTRICAL DRAWINGS FOR ADDITIONAL INFORMATION ON CEILING MOUNTED EQUIPMENT.
4. SEE EQUIPMENT LEGEND, DRAWINGS 2-94 AND 2-95 AND ACCESSORY LEGEND, DRAWING 2-95 FOR DESCRIPTIONS OF CEILING MOUNTED EQUIPMENT AND ACCESSORIES.
5. REFER TO SHEET 2-269A FOR TYPICAL CEILING INSTALLATION PLANS AND DETAILS.
6. ALL TOILET AND LOCKER CEILINGS ARE 8'-1" AFF UNLESS NOTED OTHERWISE ON THE DRAWINGS.
7. ALL NEW CEILINGS IN EXISTING BUILDING 2 SHALL BE INSTALLED AT THE SAME HEIGHT ABOVE FINISH FLOOR AS PREVIOUSLY EXISTING CEILINGS UNLESS NOTED OTHERWISE ON THE DRAWINGS.
8. REFER TO SHEET 2-269B FOR TYPICAL CEILING AND ABOVE CEILING MOUNTED EQUIPMENT SUPPORT DETAILS
9. REFER TO SHEET 2-94 FOR LIST OF ROOMS SCHEDULED AS SHELLED SPACES.

REFLECTED CEILING PLAN LEGEND

NEW

- MOTION DETECTOR
- SUPPLY AIR DIFFUSER
- RETURN AIR GRILLE
- SUPPLY AIR LINEAR DIFFUSER
- FLUORESCENT LIGHT FIXTURE
- FLUORESCENT LIGHT FIXTURE
- FLUORESCENT LIGHT FIXTURE
- SURFACE MOUNTED FLUORESCENT FIXTURE
- 24"X24" ACCESS PANEL - COORDINATE LOCATION W/ HVAC EXAM LIGHT
- RECESSED LIGHT FIXTURE
- SPEAKER
- FIRE ALARM SPEAKER
- SMOKE DETECTOR
- CEILING MOUNTED EXIT SIGN
- CLG HT. ABOVE FIN. FLR.
- 2 X 4 CEILING GRID WITH LAY-IN ACOUSTIC TILE
- 2 X 2 CEILING GRID WITH LAY-IN ACOUSTIC TILE
- LINEAR CEILING
- GYP. BD.

EXISTING TO REMAIN

DAHL, BRADEN PTM, INC.
F&S PARTNERS, INC.
A JOINT VENTURE
1825 MARKET CENTER BLVD., SUITE 520
DALLAS, TEXAS 75207-3332
(214) 748-7337 FAX (214) 748-2284

STRUCTURAL ENGINEER
EDWARD L. WILSON, JR
CONSULTING ENGINEERS
2909 MAPLE AVENUE
DALLAS, TEXAS 75201
(214) 871-8801

M.E.P. AND CIVIL ENGINEERS
YANDELL & HILLER, INC.
512 MAIN ST., SUITE 1500
FORT WORTH, TEXAS 76102-3922
(817) 335-3000
FAX (817) 333-1025

RECORD DRAWINGS

THE INFORMATION SHOWN ON THESE DRAWINGS HAS BEEN BASED ON DOCUMENTS PROVIDED BY THE VETERANS AFFAIRS RESIDENT ENGINEER OFFICE. THE A/E HAS NOT VERIFIED THE ACCURACY AND/OR COMPLETENESS OF THIS INFORMATION AND SHALL NOT BE RESPONSIBLE FOR ANY ERRORS OR OMISSIONS WHICH MAY BE INCORPORATED HEREIN AS A RESULT.

Drawing Title
LEVEL FIVE - AREA B.3
REFLECTED CEILING PLAN

Approved Area Project Manager

Project Title
CLINICAL ADDITION

Location
VA MEDICAL CENTER DALLAS, TEXAS

Building Number 02 | Checked McF | Drawn JDT

Date 7/20/93 | DD/PTM 239.009 | FS997.00

Project No. 549-085

DRAWING NO. 2-160R

Dwg. Of

Office of Facilities
Department of Veterans Affairs