AUDIT

OVERLAY

%SCREEN /COLOR

one-quarter inch = one foot

three-eigths inch = one foot

one-half inch = one foot

three-quarters inch = one foot

one inch=one foot

one and one-half inches=one foot

three inches = one foot

VA FORM 08-6231A, JAN 1990 Date Plotted: JUNE 7, 1994
/usr/arch/vamc/vsfa3.dgn

Revisions

	Date
2 COORDINATION	01 NOV 93

Architect

Engineer

PLAN NORTH

KEY PLAN

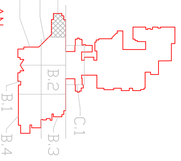

DAHL BRADEN PTM, INC.
F&S PARTNERS, INC.
A JOINT VENTURE
1825 MARKET CENTER BLVD, SUITE 520
DALLAS, TEXAS 75207-3332
(214) 748-7337 FAX (214) 748-2284

STRUCTURAL ENGINEER
EDWARD L. WILSON, JR
CONSULTING ENGINEERS
2999 MAPLE AVENUE
DALLAS, TEXAS 75201
(214) 871-8801

M.E.P. AND CIVIL ENGINEERS
YANDELL & HILLER, INC.
512 MAIN ST., SUITE 1500
FORT WORTH, TEXAS 76102-3922
(817) 335-3000
FAX (817) 335-1025

RECORD DRAWINGS

THE INFORMATION SHOWN ON THESE DRAWINGS HAS BEEN BASED ON DOCUMENTS PROVIDED BY THE VETERANS AFFAIRS RESIDENT ENGINEER OFFICE. WE HAVE NOT VERIFIED THE ACCURACY AND/OR COMPLETENESS OF THIS INFORMATION AND SHALL NOT BE RESPONSIBLE FOR ANY ERRORS OR OMISSIONS WHICH MAY BE INCORPORATED HEREIN AS A RESULT.

2-157 01

LEVEL FIVE - AREA A3
REFLECTED CEILING PLAN

SCALE 1/8 "=1'-0"

Drawing Title

Approved Area Project Manager

Project Title
CLINICAL ADDITION

Location
VA MEDICAL CENTER DALLAS, TEXAS

Building Number
02

Checked
MCF

Drawn
JDT

Date
7/20/93

DRAWING NO.
2-157R

Project No.
549-085

DB/PTM 239.009
FS9397.00

Dwg. 0F

Office of Facilities

Department of Veterans Affairs

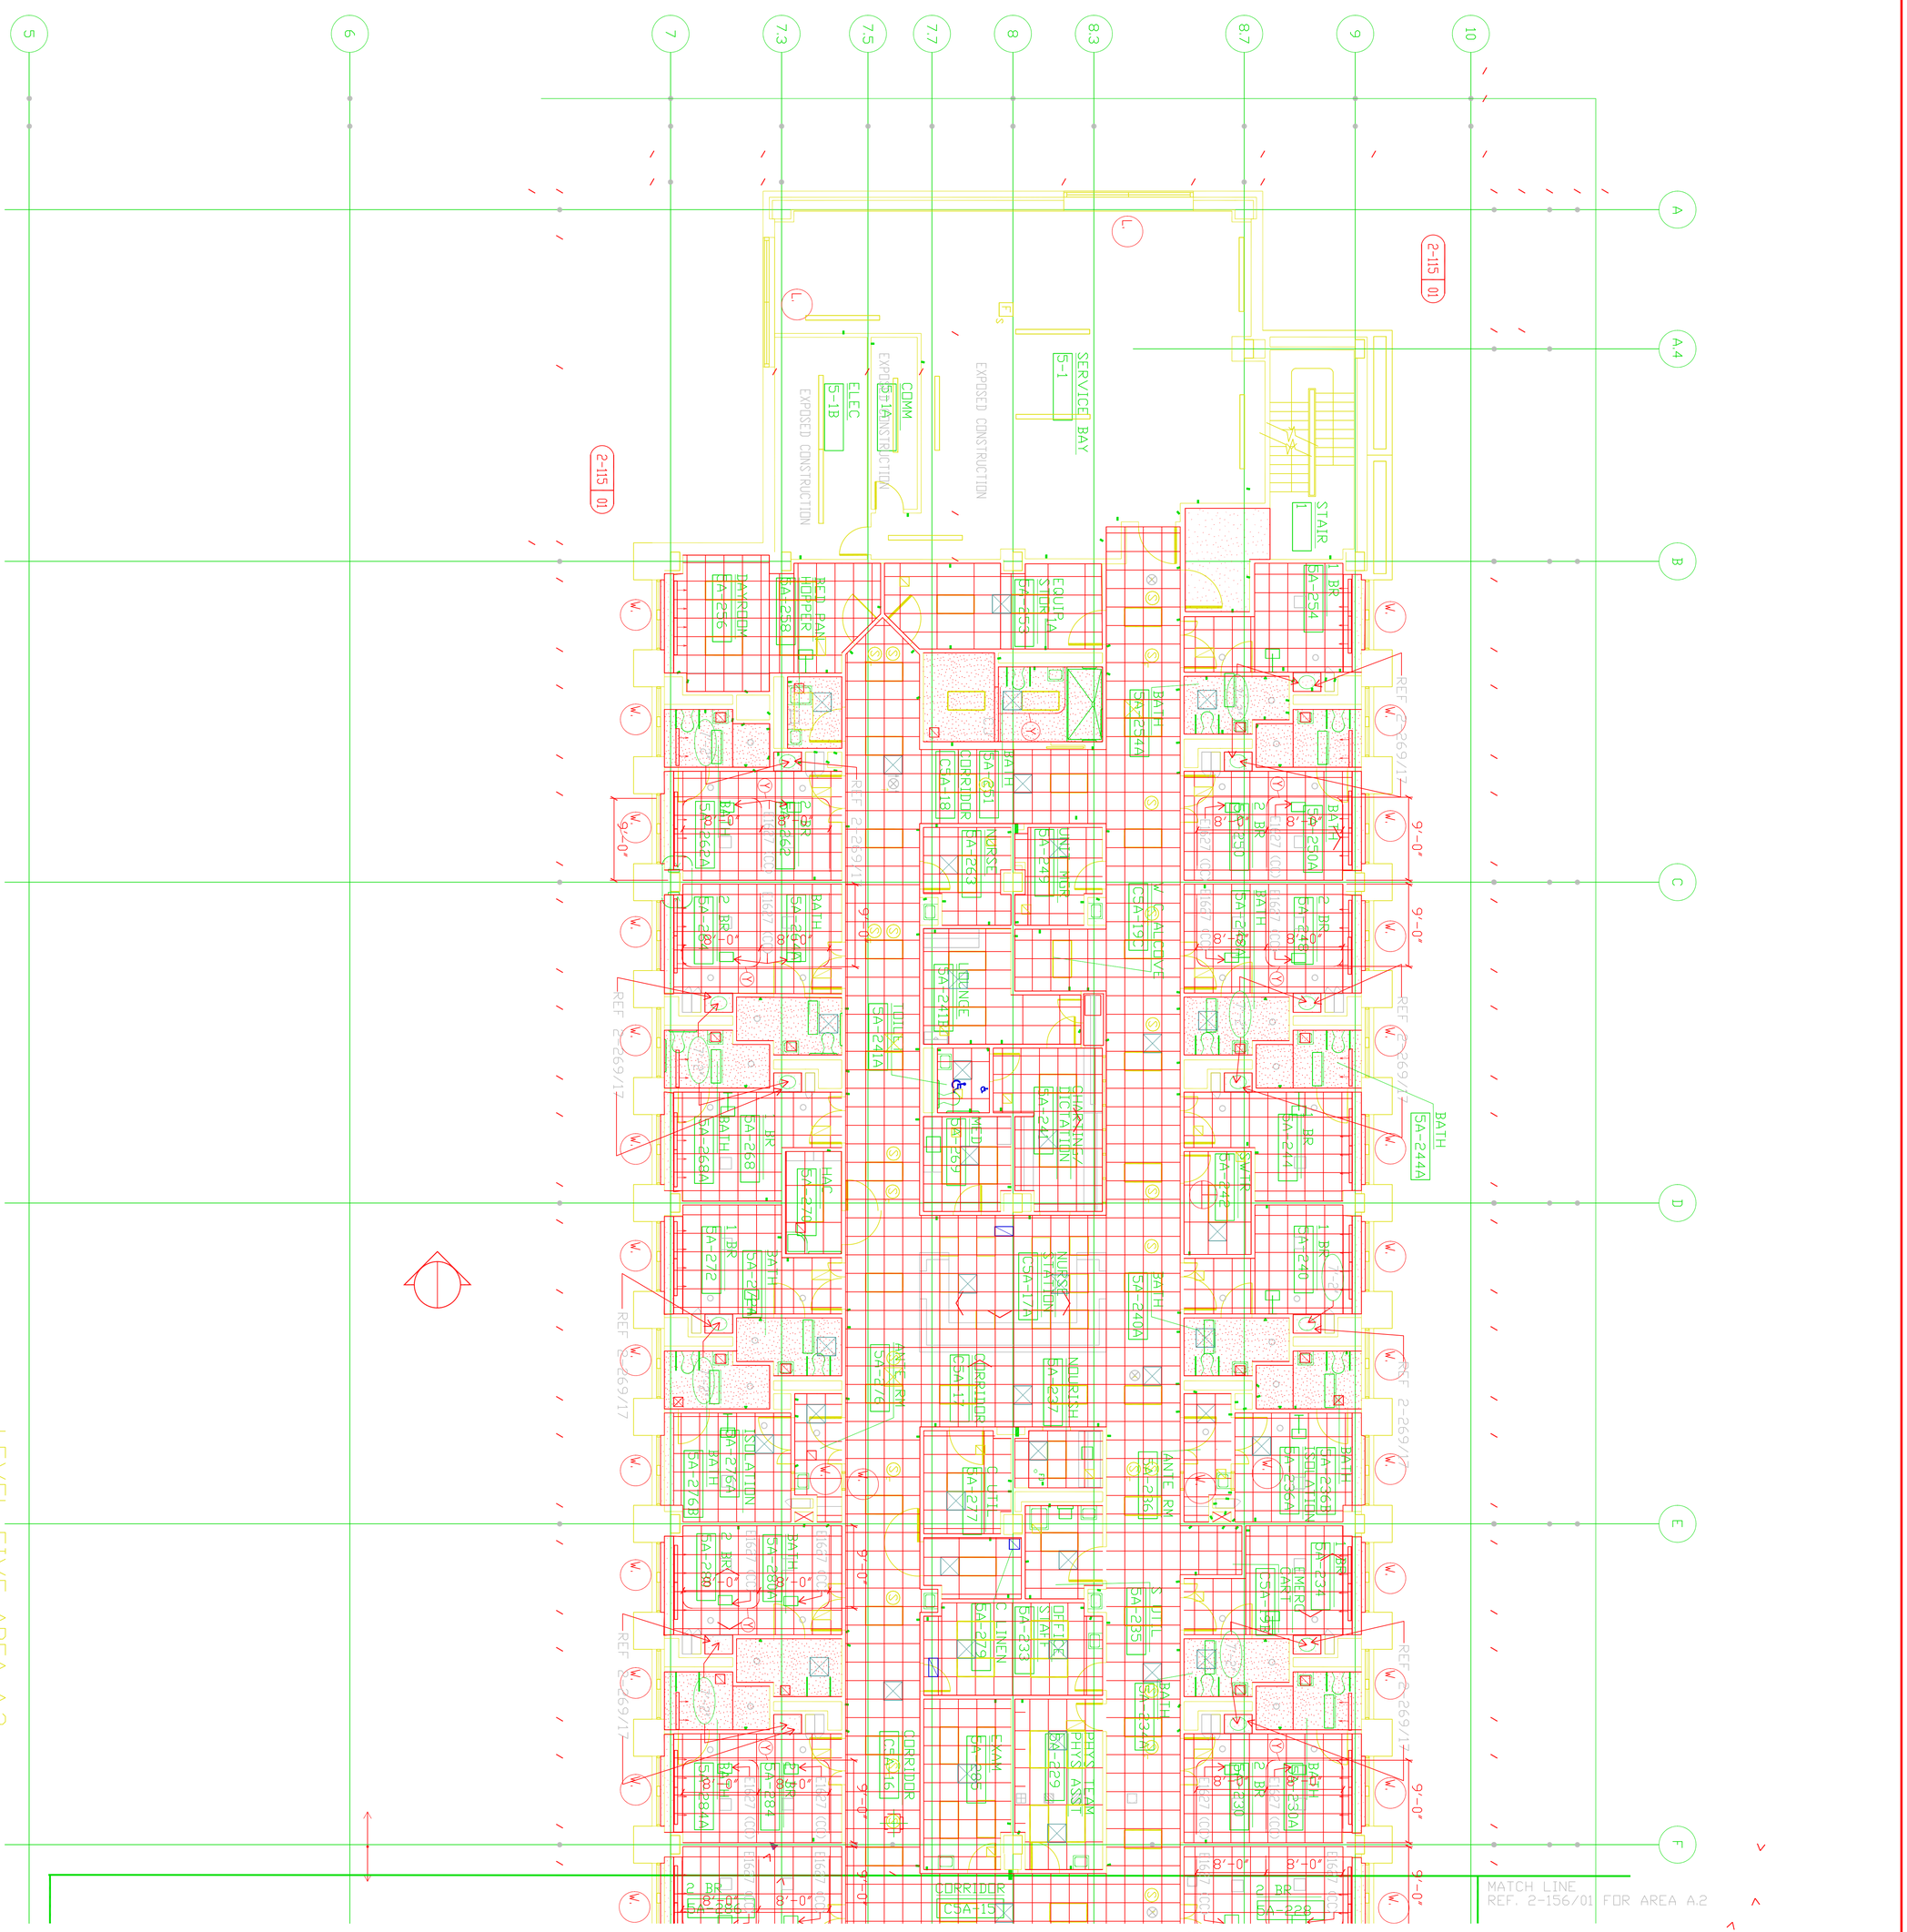

NOTES

1. SEE GENERAL ARCHITECTURAL NOTES, DRAWING 0-1.
2. ALL CEILINGS ARE 9'-0" AFF UNLESS NOTED OTHERWISE ON THE DRAWINGS
3. SEE ENLARGED EQUIPMENT FLOOR PLANS, MECHANICAL AND ELECTRICAL DRAWINGS FOR ADDITIONAL INFORMATION ON CEILING MOUNTED EQUIPMENT.
4. SEE EQUIPMENT LEGEND, DRAWINGS 2-94 AND 2-95 AND ACCESSORY LEGEND, DRAWING 2-95 FOR DESCRIPTIONS OF CEILING MOUNTED EQUIPMENT AND ACCESSORIES.
5. REFER TO SHEET 2-269A FOR TYPICAL CEILING INSTALLATION PLANS AND DETAILS.
6. ALL TOILET AND LOCKER CEILINGS ARE 8'-1" AFF UNLESS NOTED OTHERWISE ON THE DRAWINGS.
7. ALL NEW CEILINGS IN EXISTING BUILDING 2 SHALL BE INSTALLED AT THE SAME HEIGHT ABOVE FINISH FLOOR AS PREVIOUSLY EXISTING CEILINGS UNLESS NOTED OTHERWISE ON THE DRAWINGS.
8. REFER TO SHEET 2-269B FOR TYPICAL CEILING AND ABOVE CEILING MOUNTED EQUIPMENT SUPPORT DETAILS
9. REFER TO SHEET 2-94 FOR LIST OF ROOMS SCHEDULED AS SHELLED SPACES.

REFLECTED CEILING PLAN LEGEND

NEW

- MOTION DETECTOR
- SUPPLY AIR DIFFUSER
- RETURN AIR GRILLE
- SUPPLY AIR LINEAR DIFFUSER
- FLUORESCENT LIGHT FIXTURE
- FLUORESCENT LIGHT FIXTURE
- FLUORESCENT LIGHT FIXTURE
- SURFACE MOUNTED FLUORESCENT FIXTURE
- 24"X24" ACCESS PANEL - COORDINATE LOCATION W/ HVAC
- EXAM LIGHT
- RECESSED LIGHT FIXTURE
- SPEAKER
- FIRE ALARM SPEAKER
- SMOKE DETECTOR
- CEILING MOUNTED EXIT SIGN
- 9'-6" CLG HT. ABOVE FIN. FLR.
- GYP. BD.
- LAYER W10,P4,P7
- 2 X 4 CEILING GRID WITH LAY-IN ACOUSTIC TILE
- 2 X 2 CEILING GRID WITH LAY-IN ACOUSTIC TILE
- LINEAR CEILING

EXISTING TO REMAIN