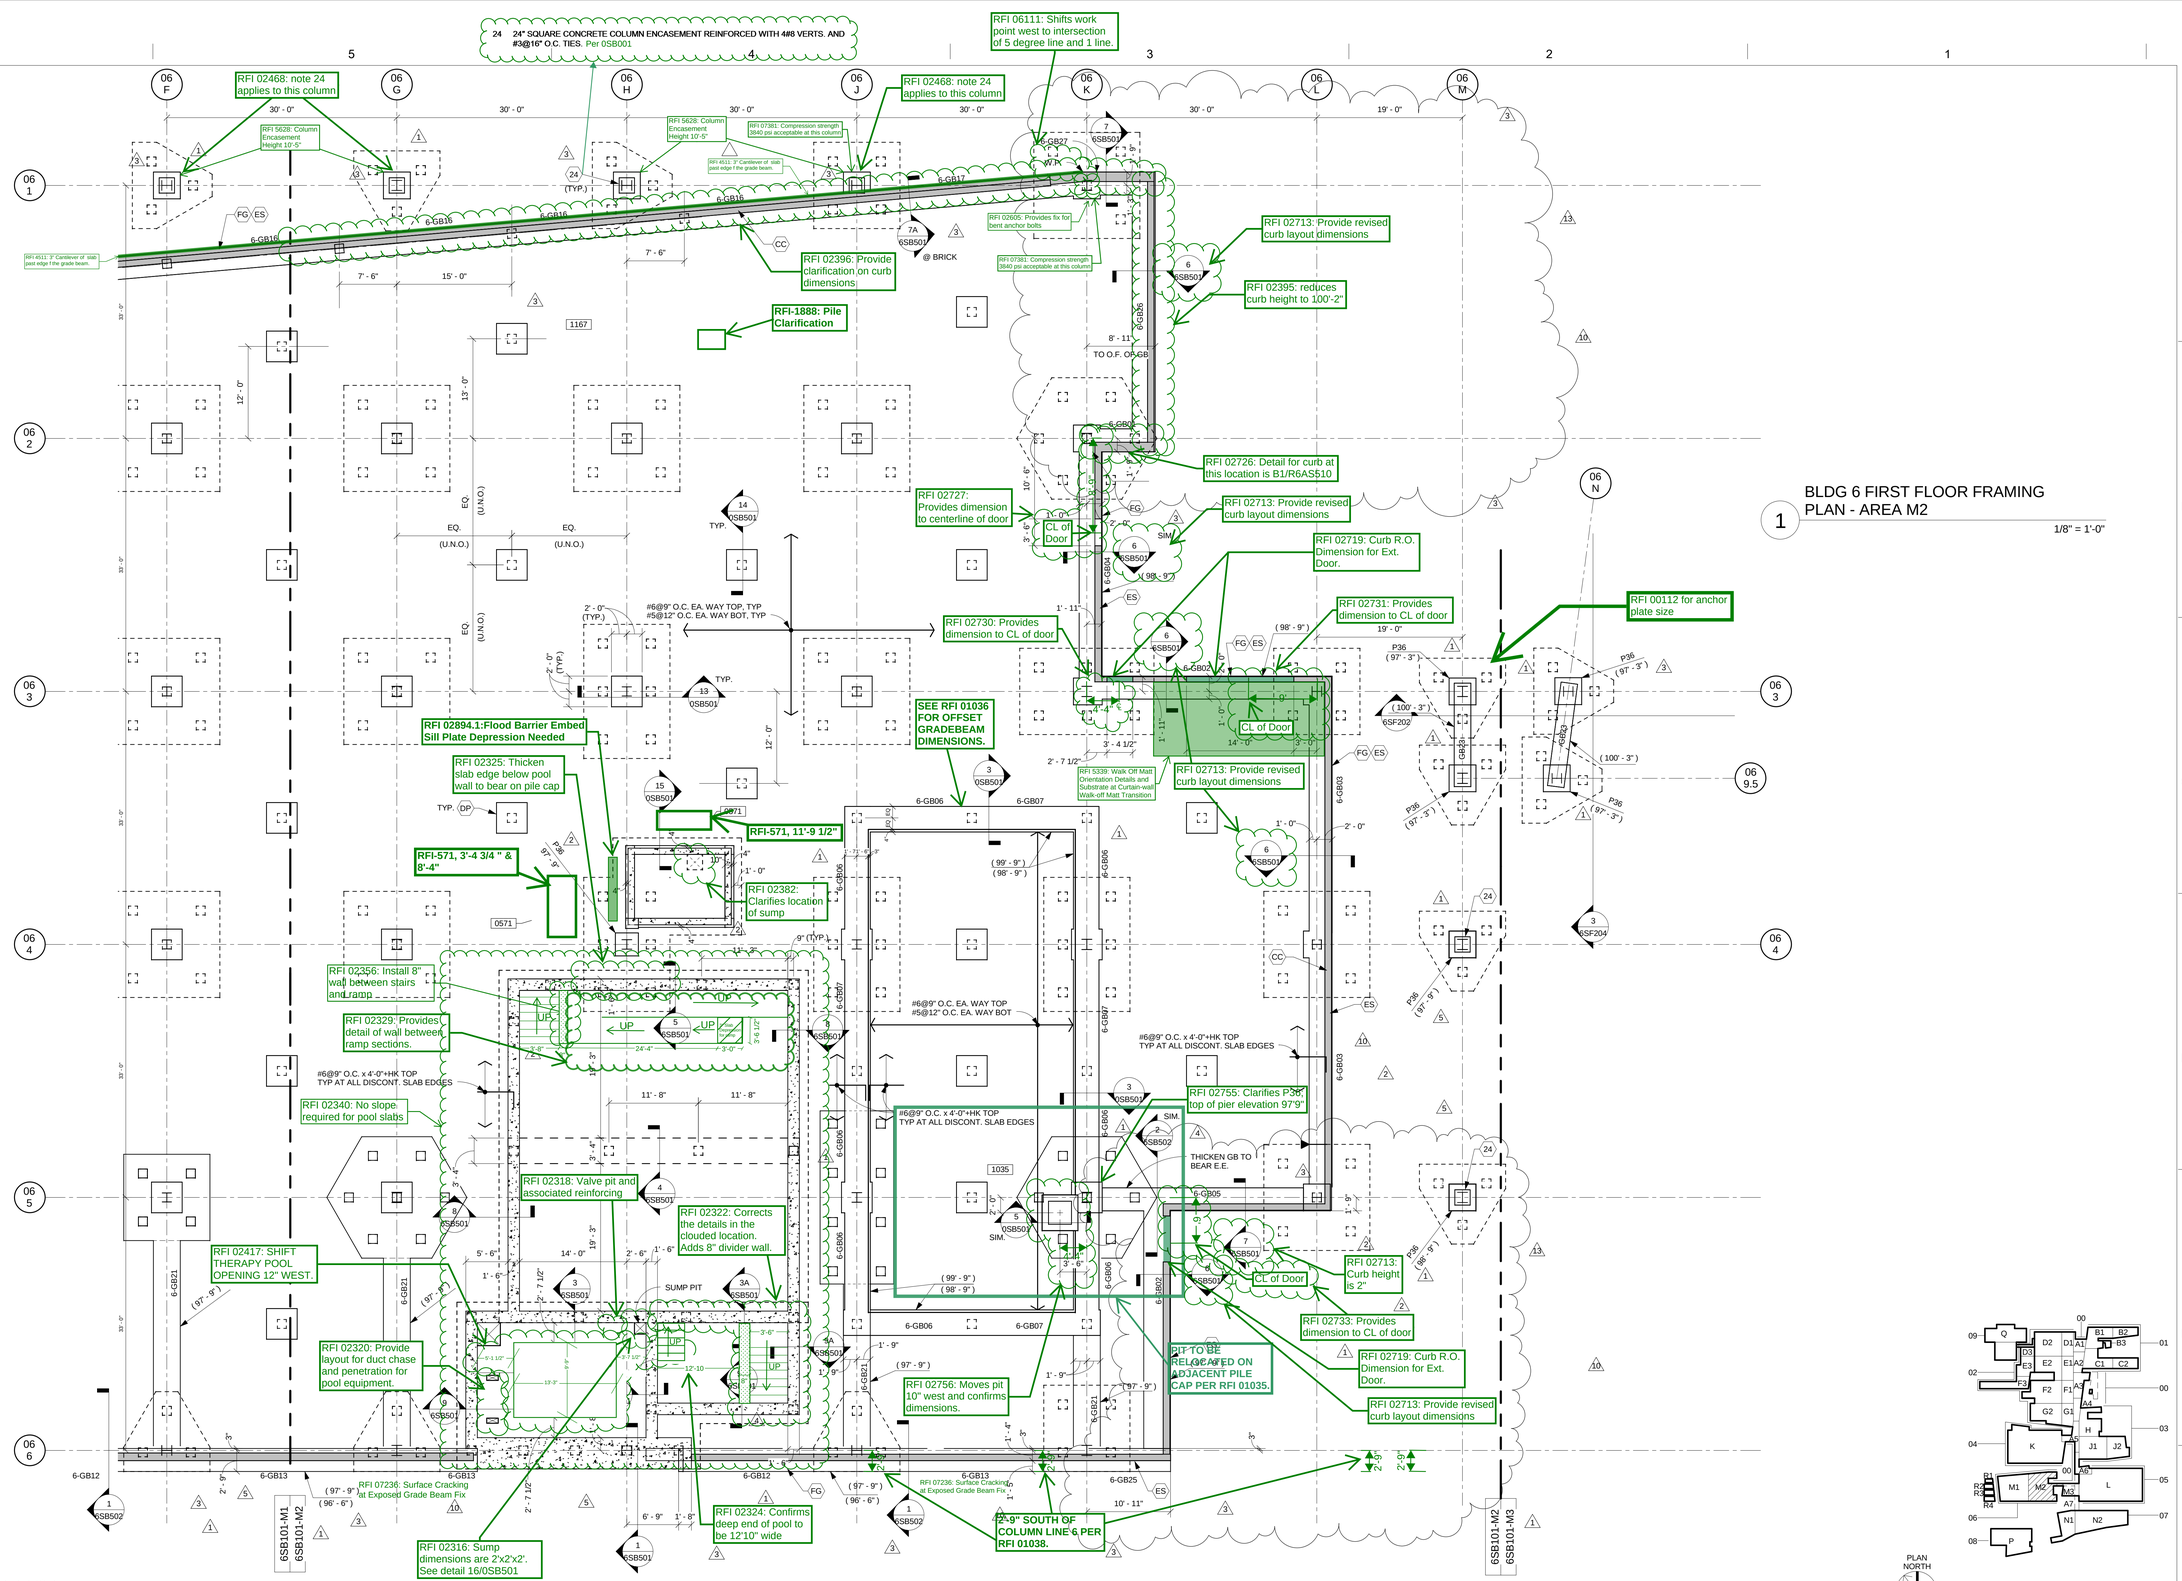

3 ALL FOUNDATION DRAWINGS WITH SB PREFIX IN EWP04 WERE REPLACED BY THE SHEETS OF THE SAME NAME AND NUMBER FROM EWP05 EFFECTIVE WITH ADDENDUM #5 TO EWP04.

FULLY SPRINKLERED

13	BULLETIN 012D	6/7/13
10	BULLETIN 009D	2/5/13
5	BULLETIN 004.1	5/25/12
4	ADDENDUM 4 - POST BID	12/21/11
3	ADDENDUM 3 - POST BID	12/2/11
2	ADDENDUM 2	8/24/11
1	ADDENDUM 1	8/24/11

REVISIONS: DATE

CONSULTANTS:

DESMAN ASSOCIATES / PARKING
CODE CONSULTANTS, INC. / CODE CONSULTANT
THE SEXTANT GROUP / AV & ACOUSTICAL
HAMMER DESIGN ASSOCIATES / FOOD SERVICE
PYBURN & ODOM / ABATEMENT
TATA & HOWARD / TANK CONSULTANT
I.S.C. GROUP, INC. / IRRIGATION
DAN EUSER WATER ARCHITECTURE, INC. / WATER FEATURE

STATE OF LOUISIANA — THOMAS M. HOYLE — LICENSE NO. 29591 — PROFESSIONAL ENGINEER IN STRUCTURAL/CIVIL ENGINEERING

ARCHITECT/ENGINEERS:

studioNOVA
SCHRENK & PETERSON CONSULTING ENGINEERS / CIVIL
KORDA/NEMETH ENGINEERING / STRUCTURAL
BR+A CONSULTING ENGINEERS / MECH, ELECT, PLUMBING, LOW VOLTAGE
ARCHITECTURAL ENGINEERING / PLUMBING
SCALES ASSOCIATES / FIRE PROTECTION
COMMUNICATIONS DESIGN GROUP / LOW VOLTAGE

DRAWING TITLE: BLDG 6 FIRST FLOOR FRAMING PLAN - AREA M2
PROJECT TITLE: SLVHCS REPLACEMENT MEDICAL CENTER PROJECT
PROJECT NUMBER: 629-HS2-401
BUILDING NUMBER: 6
DOCUMENT SET PACKAGE: EWP_5
APPROVED: PROJECT DIRECTOR
LOCATION: NEW ORLEANS, LOUISIANA
DATE: July 15, 2011
CHECKED: TMD
DRAWN: KMY
DRAWING NUMBER: 6SB101-M2

OFFICE OF CONSTRUCTION AND FACILITIES MAINTENANCE
Department of Veterans Affairs