


OFFICES 104, 105 & 106

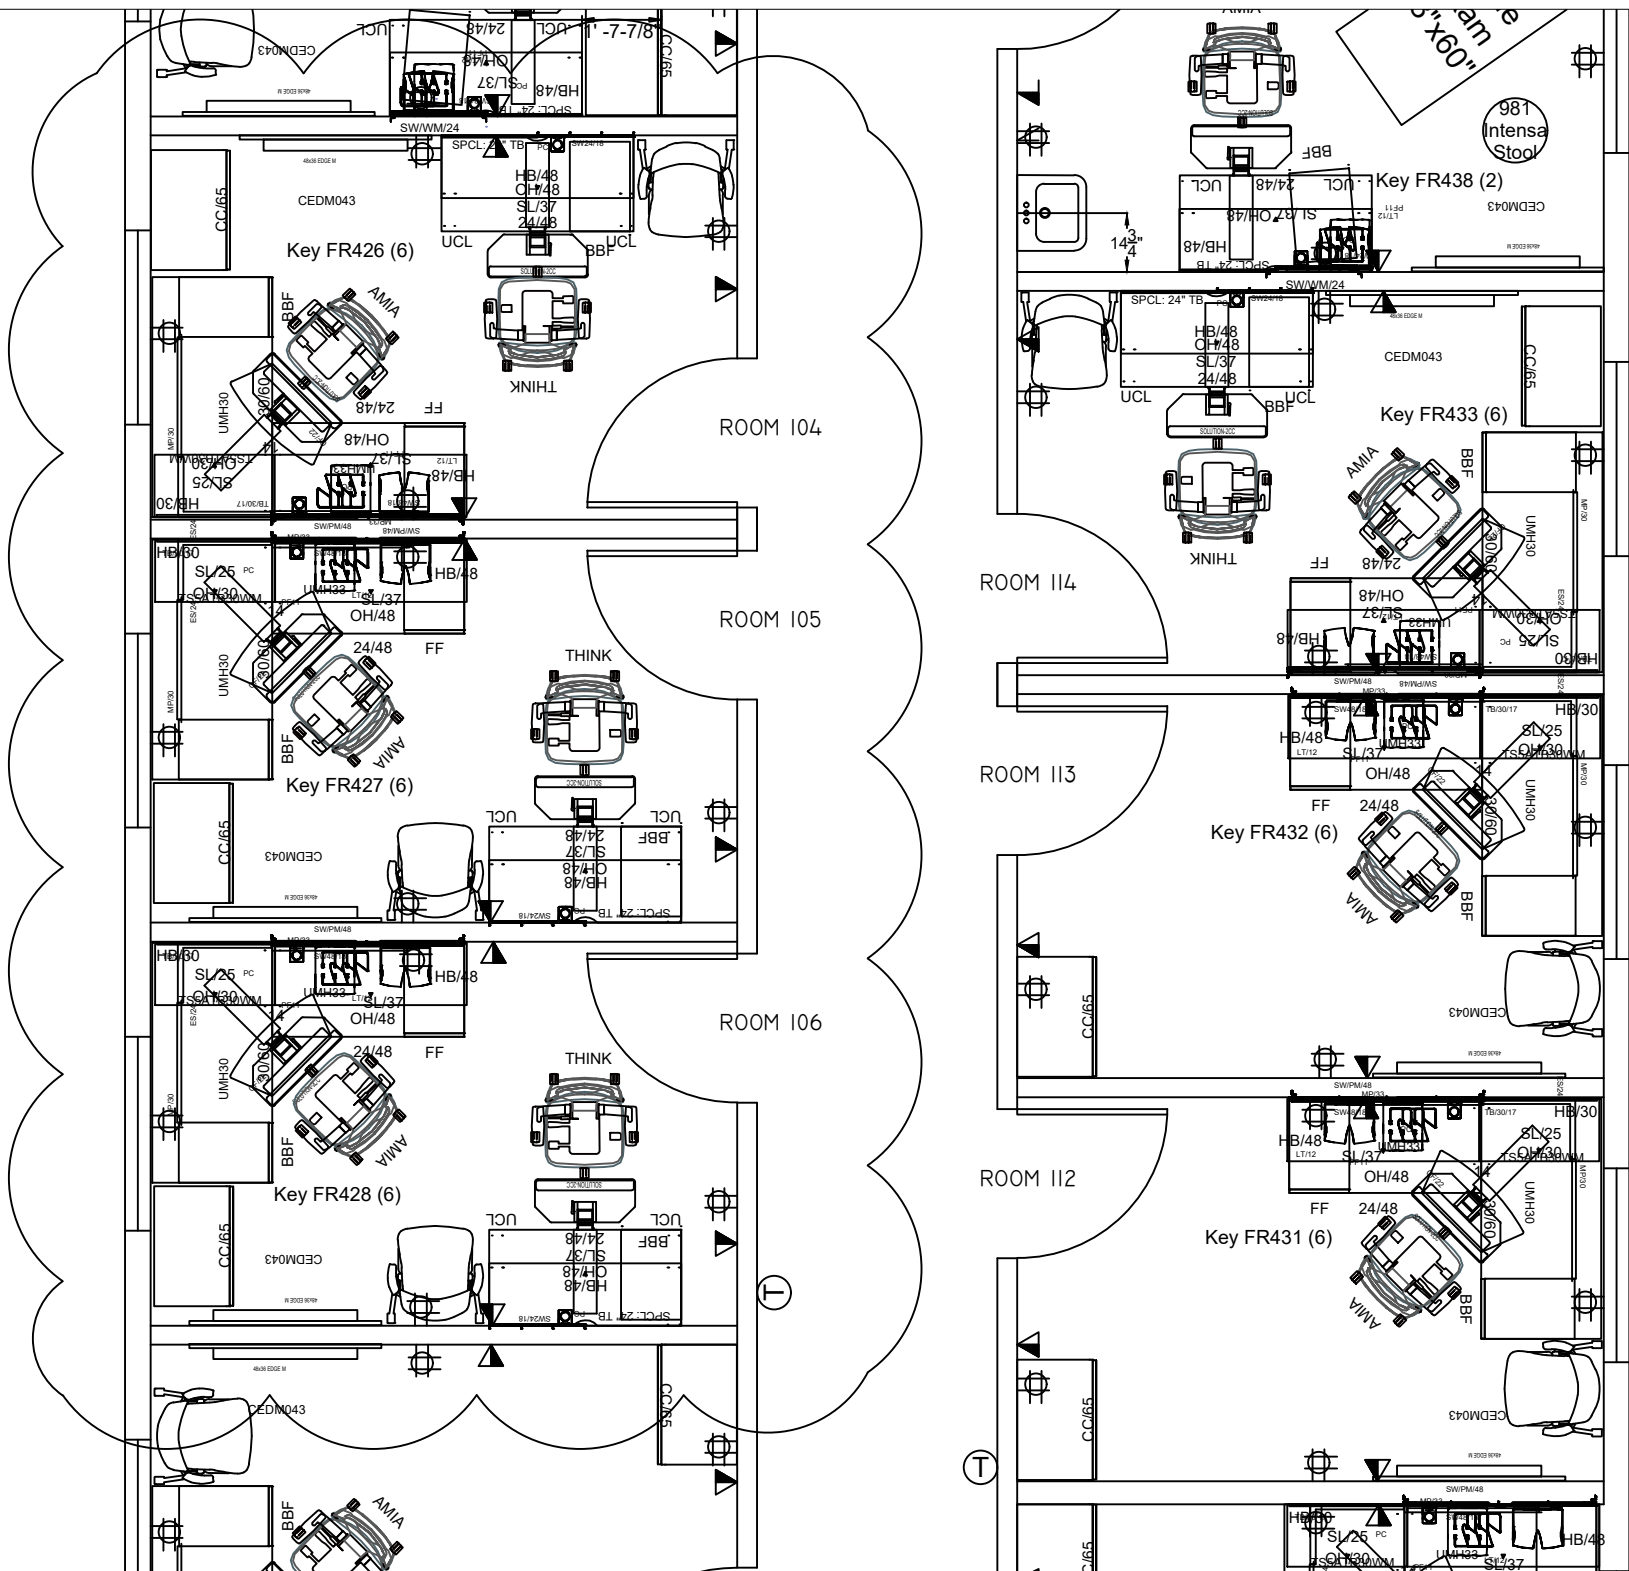

OFFICE 132

