

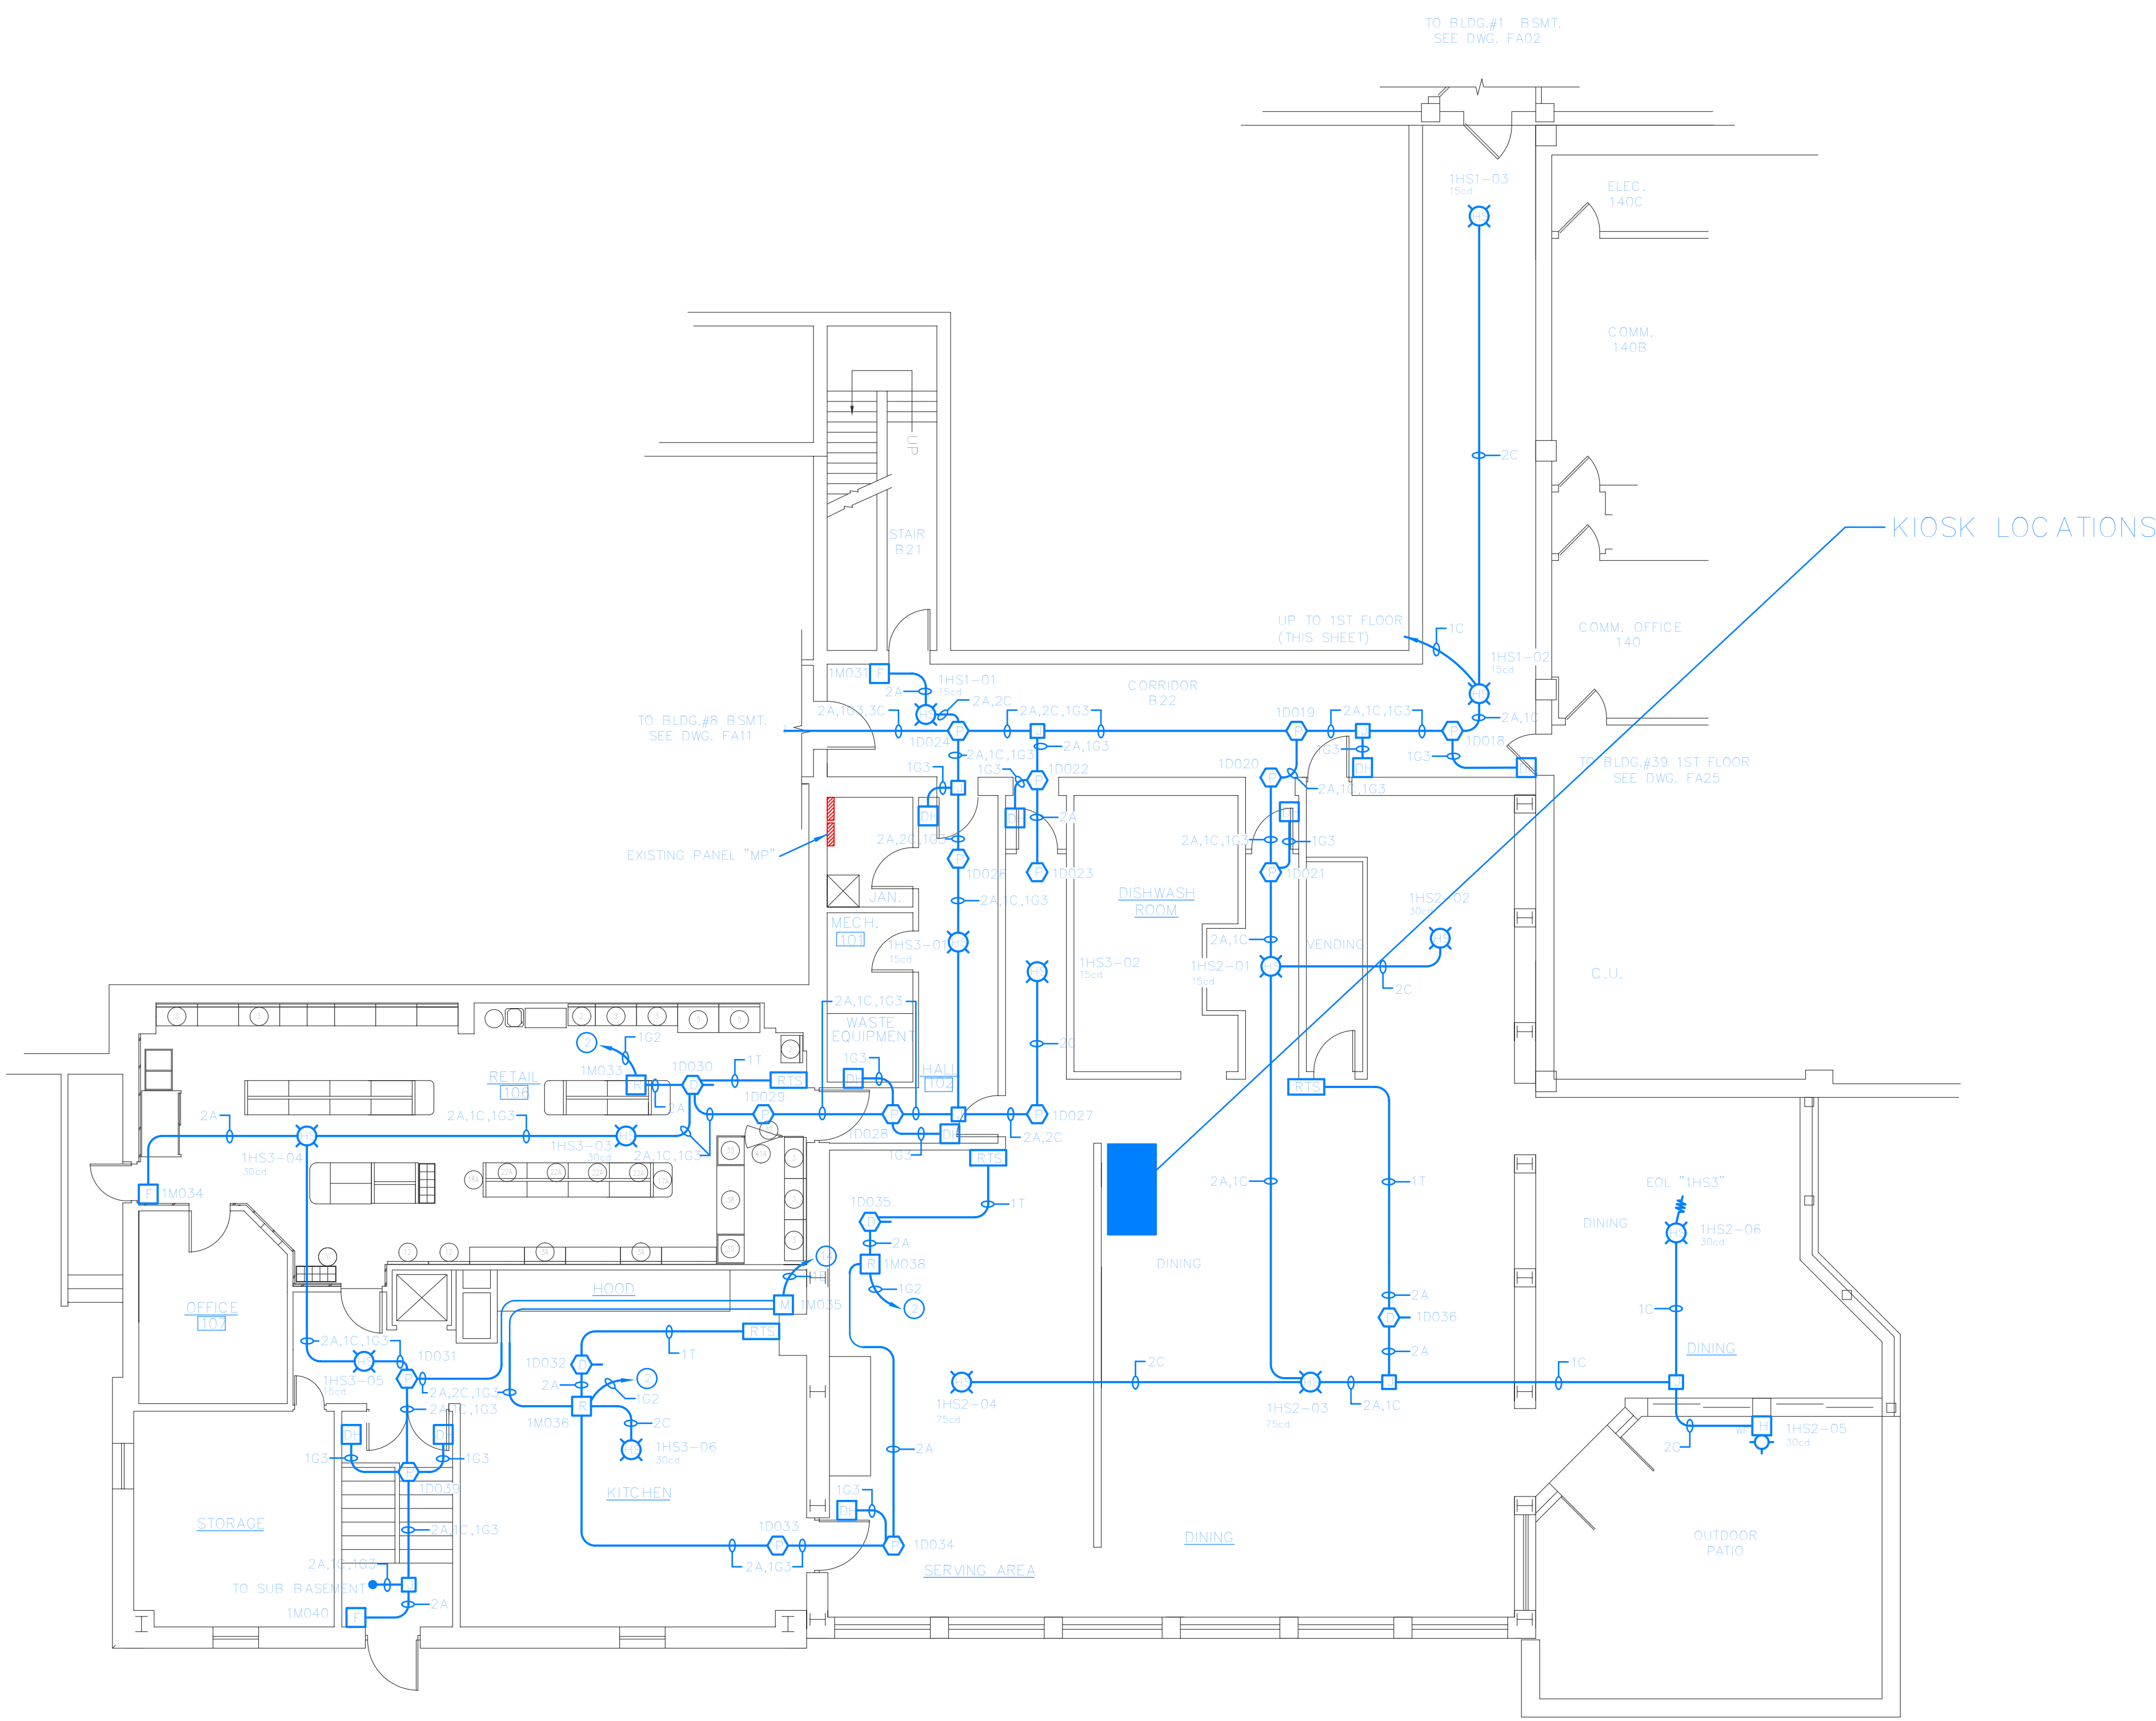



DEVICE LEGEND			
QTY	SYMBOL	DEVICE	PART NUMBER
10		CEILING MOUNTED HORN/STROBE	ES2W
2		CEILING MOUNTED STROBE LIGHT	ES2W
1		CONTROL MODULE	ESM-1
1		DUCT DETECTOR/SAMPLING TUBE	ESD-751PL/ST-10
AS REQD		INITIATION BOX	BY OTHERS
1		MAGNETIC DOOR HOLDER	ESM-998
1		MANUAL PULL STATION	ESM-120A
1		MONITOR MODULE	MM-1
10		PHOTOELECTRIC DETECTOR/BASE	ESD-B51/B710LP
1		RELAY MODULE	ESM-1
1		REMOTE POWER SUPPLY	ESPS-2428
1		REMOTE TEST STATION	ESRS451K1
1		WALL MOUNTED HORN/STROBE - WEATHERPROOF	ES2R
1		WALL MOUNTED HORN/STROBE	ES2R
		END OF LINE RESISTOR	AS REQUIRED

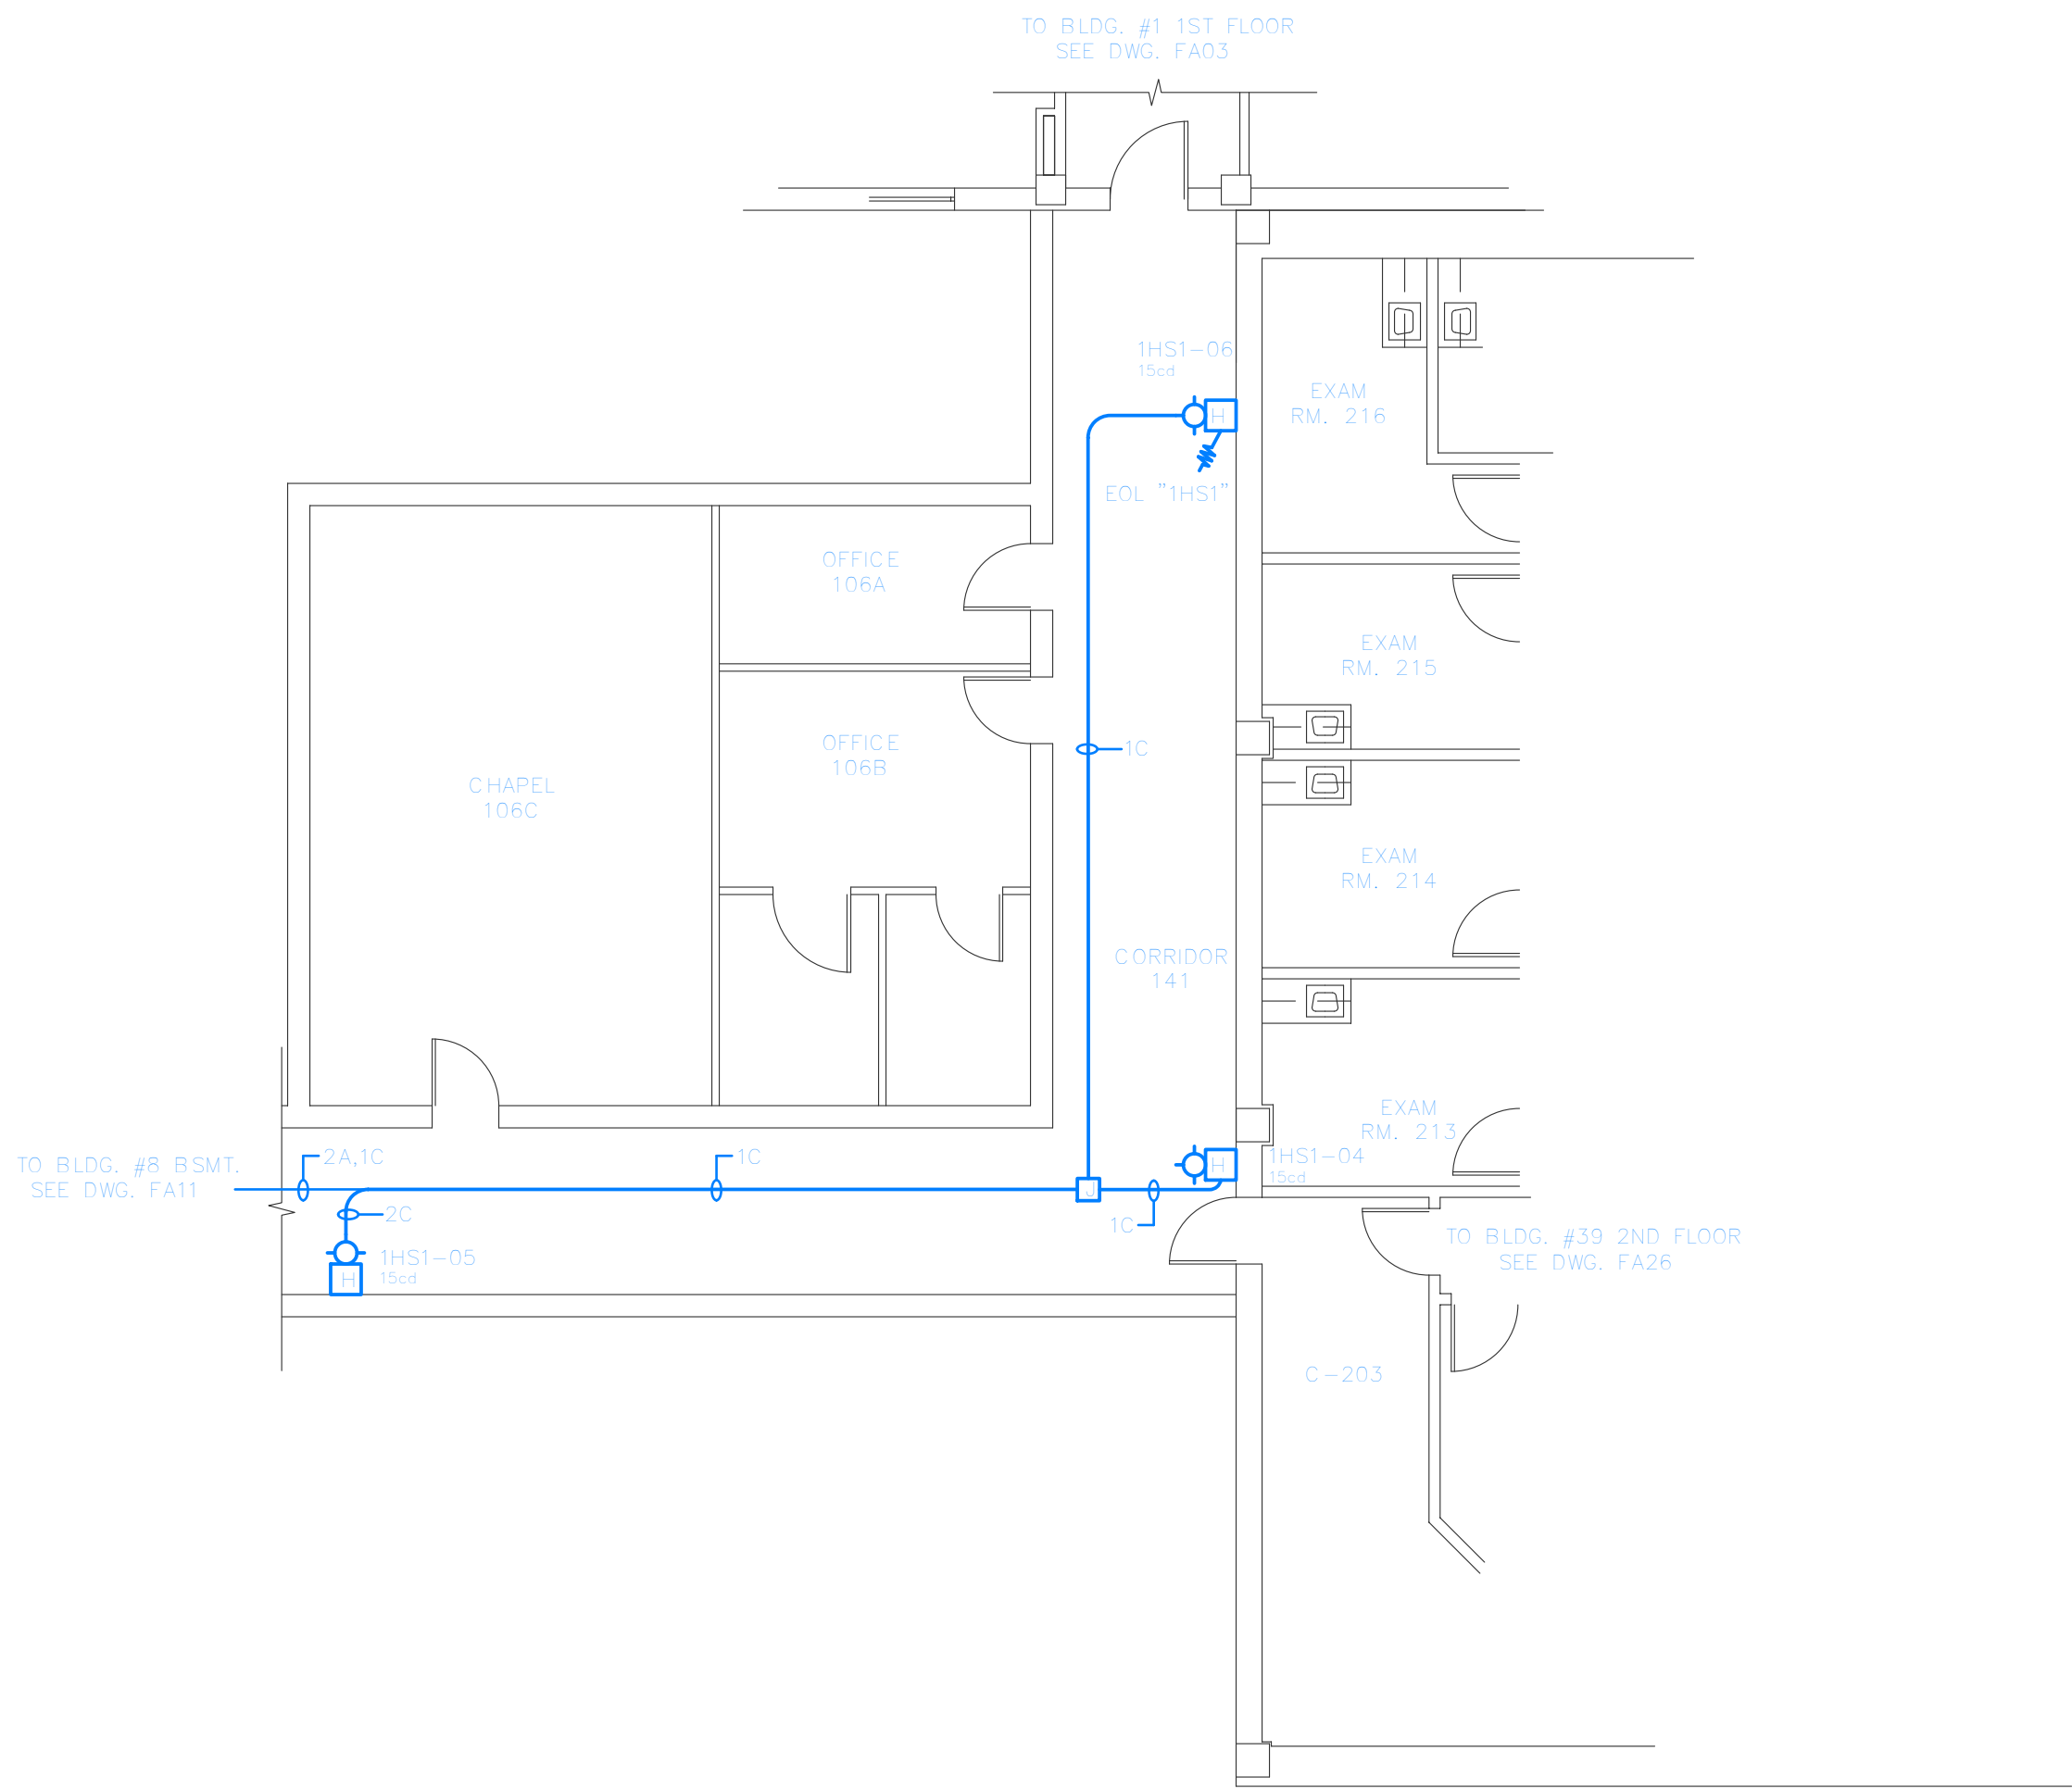


FIRE ALARM PLAN – BUILDING 8A – BASEMENT

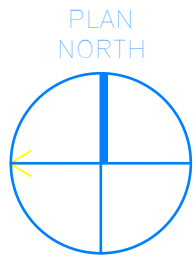

FIRE ALARM PLAN – BUILDING 8A – FIRST FLOOR

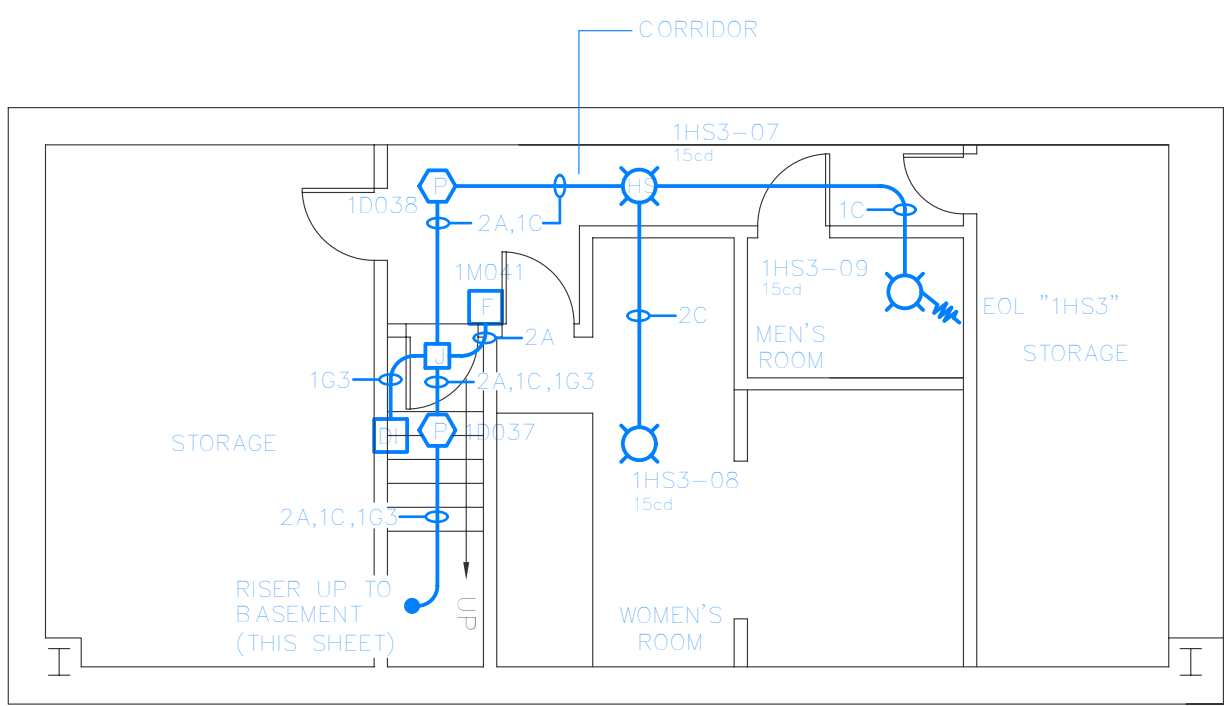

FIRE ALARM PLAN – BUILDING 8A – SUB-BASEMENT

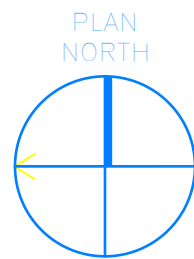

CLOUD INDICATES ADDITIONS/REVISIONS TO ORIGINAL BID DOCUMENTS TO MEET CODE REQUIREMENTS.