

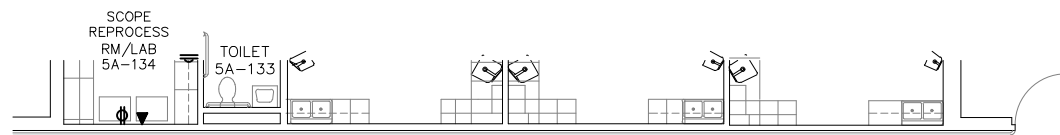


APPROVED  
PLANS

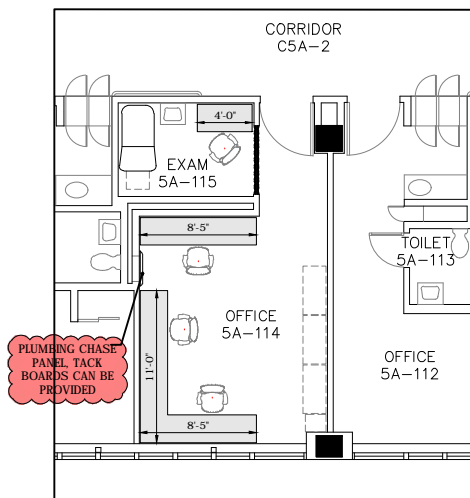

CORRIDOR C5A-2

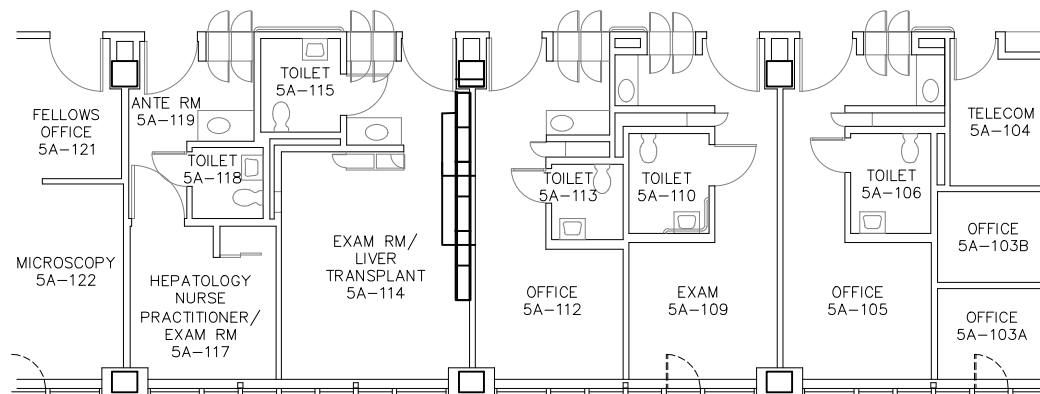

EXISTING