



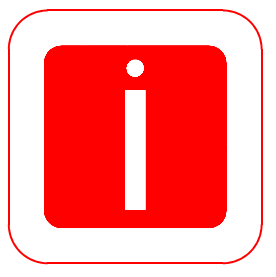

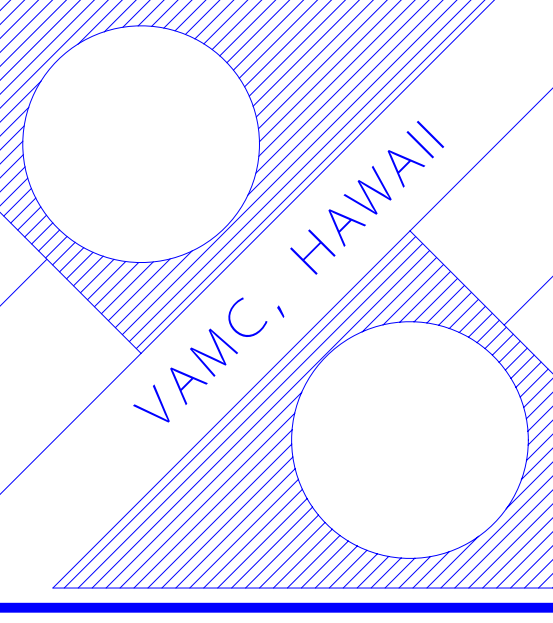

one eighth inch = one foot  
one quarter inch = one foot  
three eighths inch = one foot  
one half inch = one foot  
three quarters inch = one foot  
one inch = one foot  
one and one half inches = one foot  
three inches = one foot

Revisions		Date		Professional Seal		 <b>Indus Systems, Inc.</b> 2352, Main Street, Concord MA 01742 Tel: 978 - 461 - 0555 www.indus - systems.com		Drawing Title FIRST FLOOR PLAN ARCHITECTURAL		Project Title AS - BUILT Drawings		Date 04 - 28 - 2016 Project No.		 VAMC, HAWAII		Department of Veterans Affairs VA	
Site: HAWAII		Building: ACC		Drawn:		Checked:		Approved:		Drawing No.							
Location: VAMC, HAWAII				Approved:													