


three inches = one foot
One and one-half inches = one foot
one inch = one foot
three-quarters inch = one foot
one-half inch = one foot
three-eighths inch = one foot
one-quarter inch = one foot
eighth inch = one foot

J.P. VA
Soil samples
KMD/KH
1/5/16

Drawing Title BUILDING-1B	Project Title ASBESTOS SURVEY	DATE MARCH 2010	
Floor BASEMENT FLOOR	PROJ. NO. 2009023.004	DWG. NO. 1	
Building Number 1B	CHECKED DRAWN PAL	Dwg. 1 OF 1	
SCALE: NOT TO SCALE	Location JAMAICA PLAIN		


S

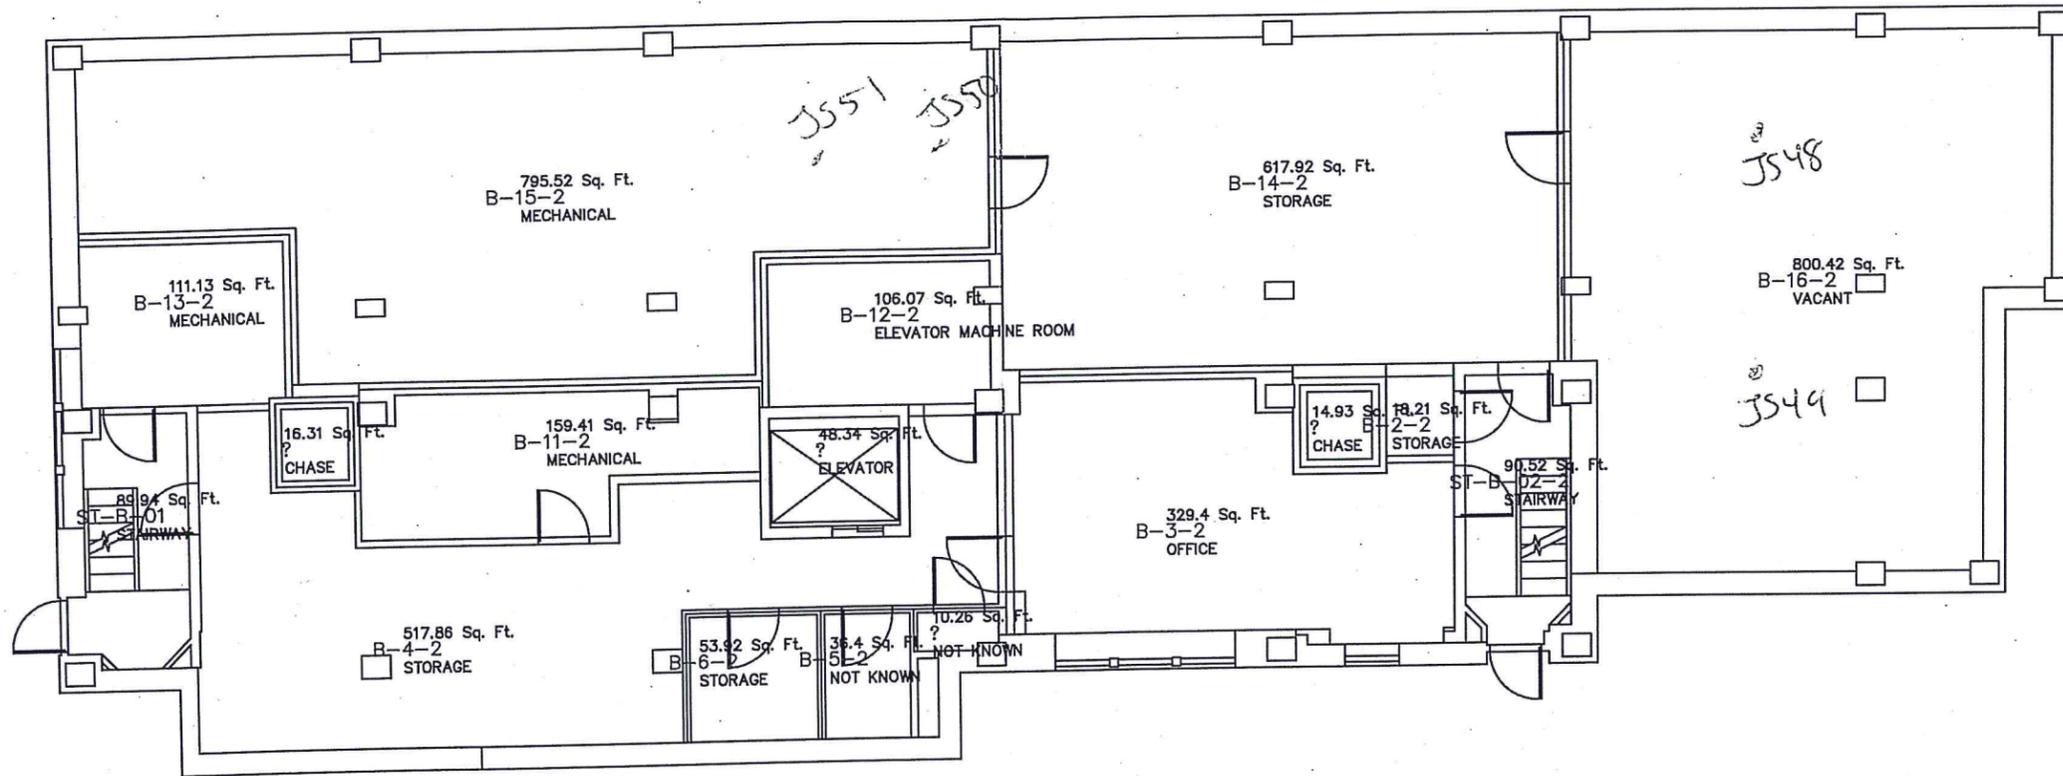

J.P. VA
 Soil samples
 KMD/KH
 1/5/16

3

Drawing Title BUILDING-2	Project Title ASBESTOS SURVEY		DATE MARCH 2010
Floor BASEMENT			PROJ. NO. 2009023.004
Building Number 2	CHECKED PAL	DRAWN PAL	DWG. NO. 1
Location JAMAICA PLAIN			Dwg. 1 OF 1

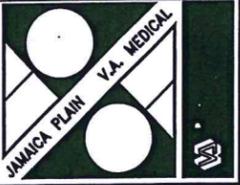

three-eighths inch = one foot
 one-half inch = one foot
 three-quarters inch = one foot
 one inch = one foot
 one and one-half inches = one foot
 three inches = one foot