




Equipment Management Rail System

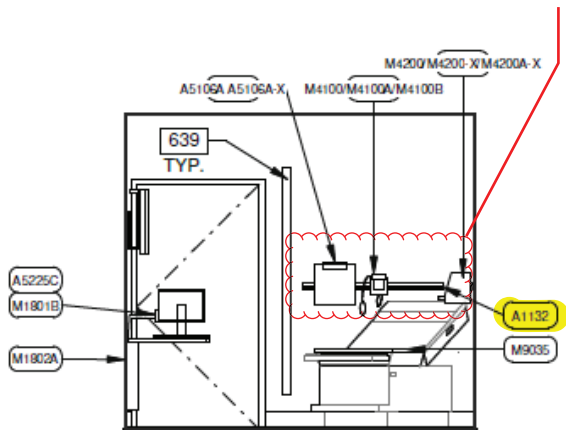


- 5B -

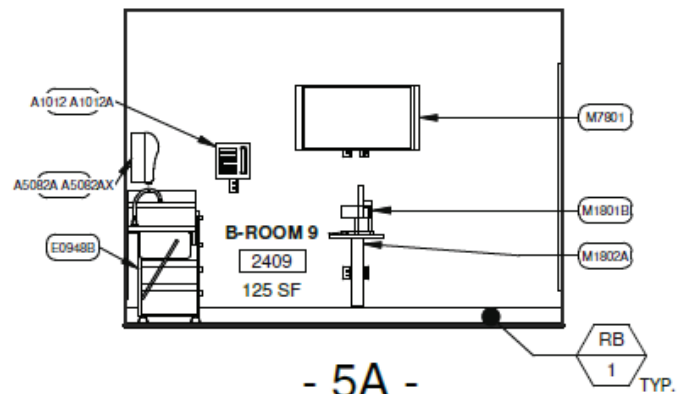

- 5A -

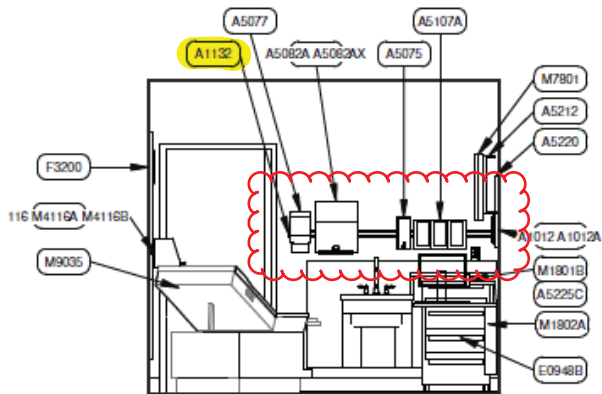

- 5D -

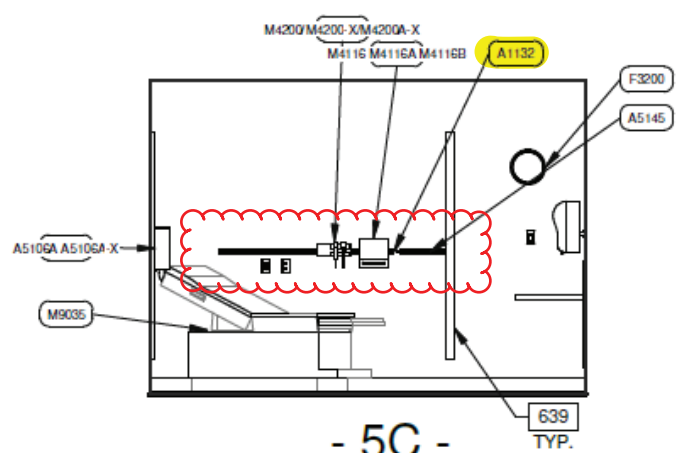

- 5C -