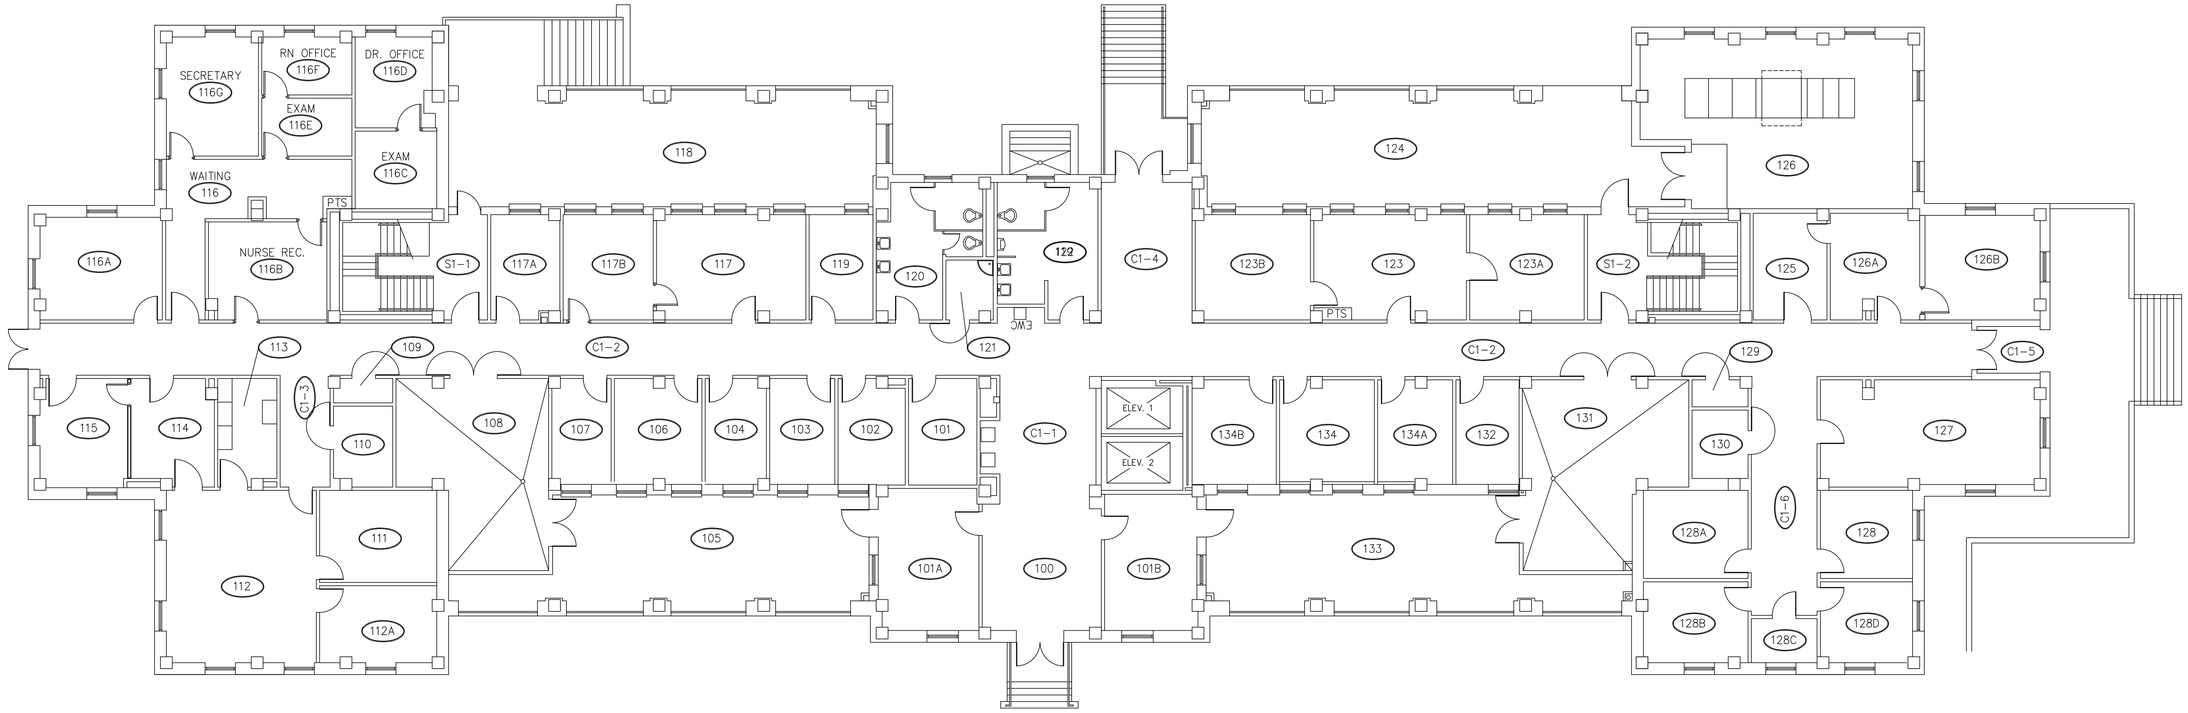

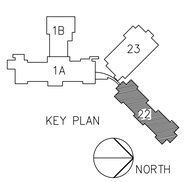

Drawing Title: FIRST FLOOR PLAN SCALE: 1/8" = 1'-0"	Project Title: UPDATE AS-BUILTS		Date: 9/14/04
			Project No.: .
Approved: Division Chief	Building Number: 22	Checked: --	Drawn: MAKI
			DRAWING NO.: 22-9
Approved: Service Director	Location: V.A.M.C. BAY PINES, FLORIDA		Dwg. 80 of 284

BAY PINES MEDICAL CENTER

Department of Veterans Affairs

Revisions | Date

VA FORM 08-6231, DEC 1989

U.S. GOVERNMENT PRINTING OFFICE: 1993-400-283

three inches = one foot
one and one-half inches = one foot
one inch = one foot
three-quarters inch = one foot
one-half inch = one foot
three-eighth inch = one foot
one-quarter inch = one foot
one-eighth inch = one foot