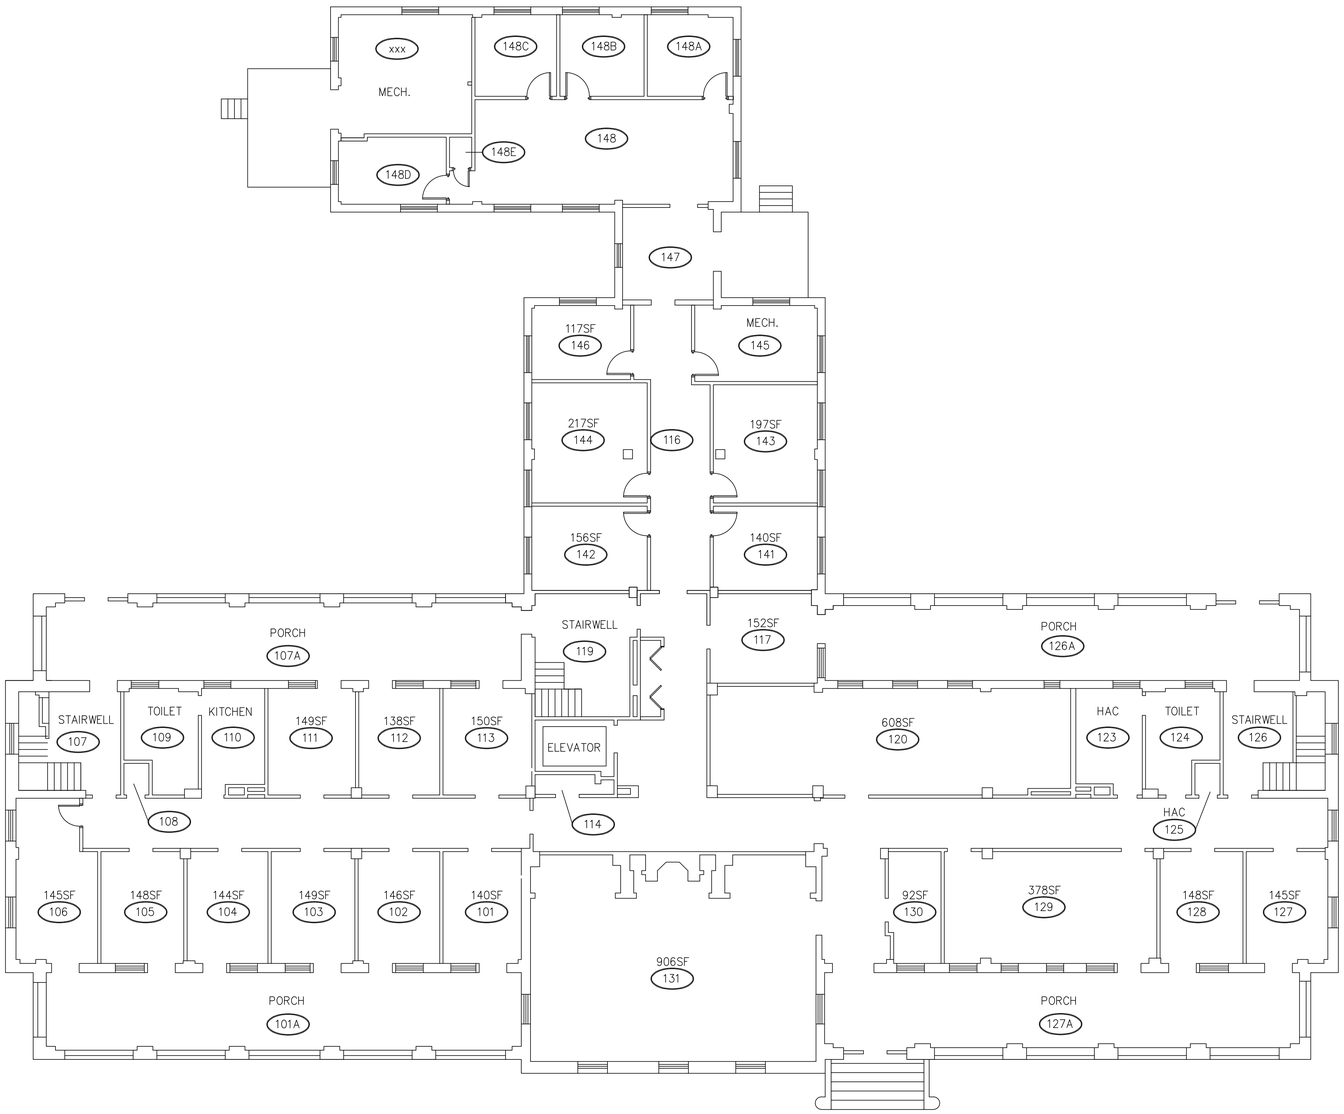

Drawing Title	Project Title	Date
FIRST FLOOR PLAN SCALE: 1/8" = 1'-0"	UPDATE AS-BUILTS	9/14/04
Approved: Division Chief	Building Number: 24 / Checked: -- / Drawn: MAKI	Project No.: .
Approved: Service Director	Location: V.A.M.C. BAY PINES, FLORIDA	DRAWING NO.: 24-1 Dwg. --Of ---

BAY PINES MEDICAL CENTER

Department of Veterans Affairs

Revisions	Date

VA FORM 08-6231, DEC 1989

U.S. GOVERNMENT PRINTING OFFICE: 1993-400-285