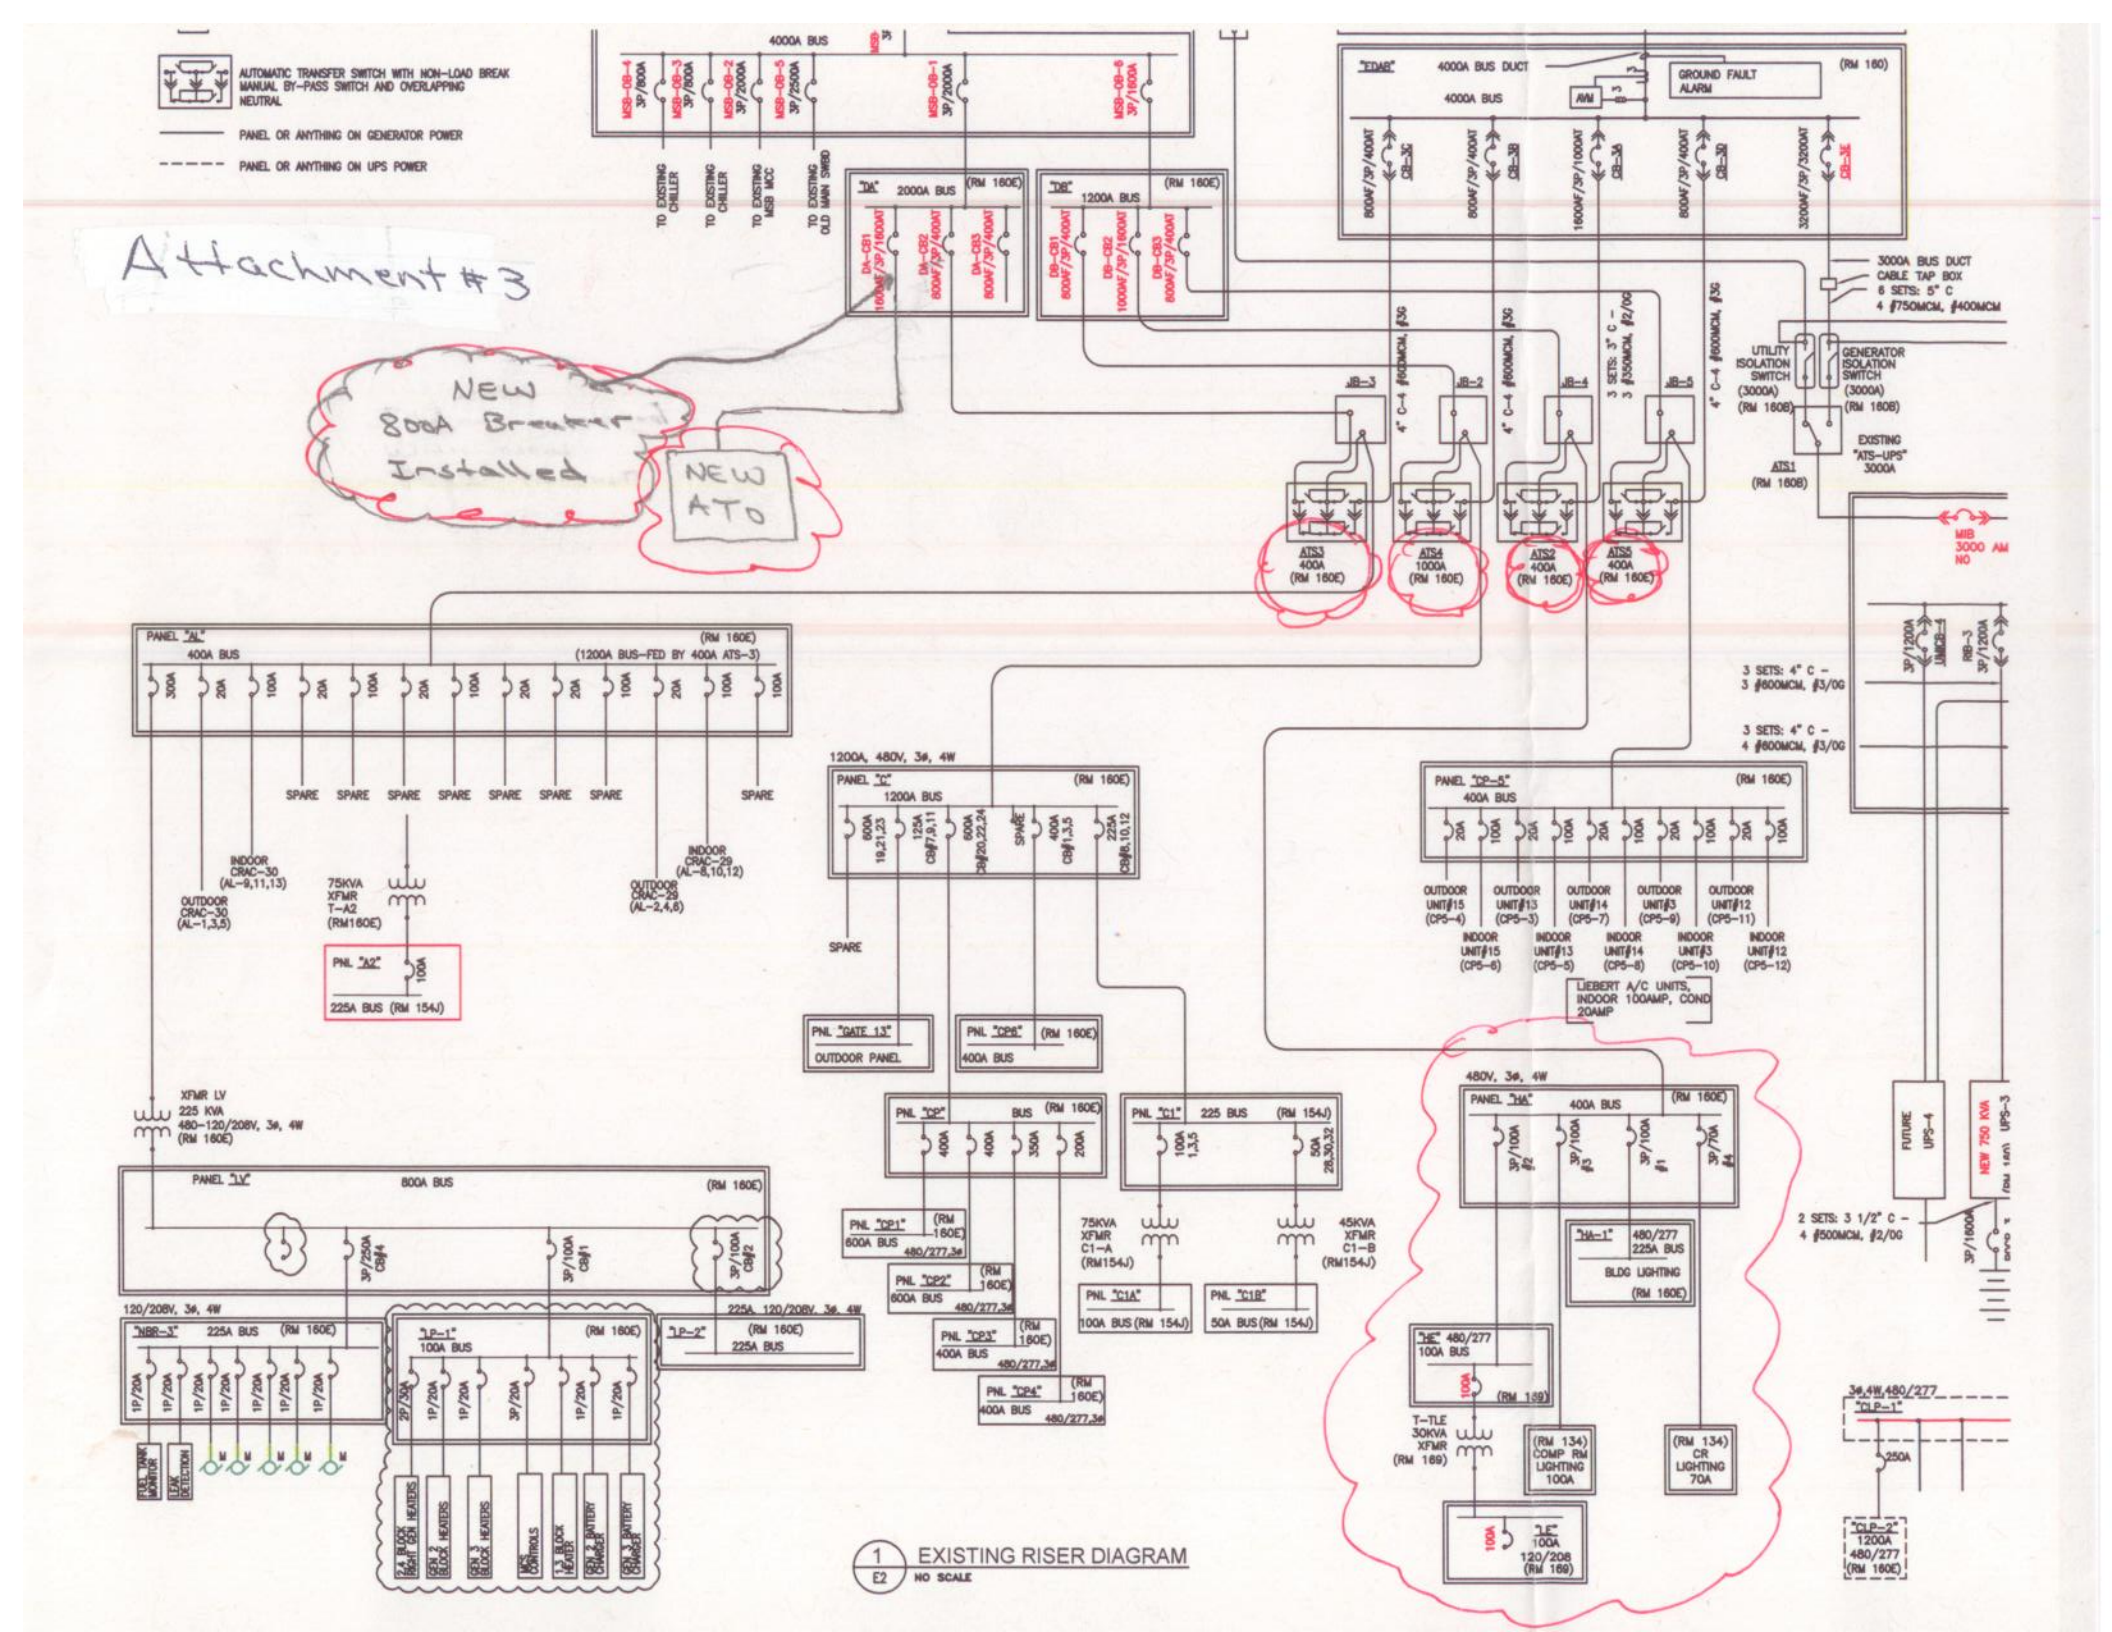
AUTOMATIC TRANSFER SWITCH WITH NON-LOAD BREAK MANUAL BY-PASS SWITCH AND OVERLAPPING NEUTRAL
PANEL OR ANYTHING ON GENERATOR POWER
PANEL OR ANYTHING ON UPS POWER
Attachment #3
NEW 800A Breaker Installed
NEW ATO
4000A BUS
"EDAB" 4000A BUS DUCT
GROUND FAULT ALARM
(RM 160)
"DA" 2000A BUS (RM 160E)
"DB" 1200A BUS (RM 160E)
TO EXISTING CHILLER
TO EXISTING MSB MCC
TO EXISTING OLD MAIN SWBD
3000A BUS DUCT
CABLE TAP BOX
6 SETS: 5" C
4 #750MCM, #400MCM
UTILITY ISOLATION SWITCH (3000A) (RM 160B)
GENERATOR ISOLATION SWITCH (3000A) (RM 160B)
EXISTING "ATS-UPS" 3000A
ATS1 (RM 160B)
ATS3 400A (RM 160E)
ATS4 1000A (RM 160E)
ATS2 400A (RM 160E)
ATS5 400A (RM 160E)
MIB 3000 AM NO
PANEL "AL" 400A BUS (1200A BUS-FED BY 400A ATS-3) (RM 160E)
SPARE
INDOOR CRAC-30 (AL-9,11,13)
OUTDOOR CRAC-30 (AL-1,3,5)
75KVA XFMR T-A2 (RM160E)
PNL "A2" 225A BUS (RM 154J)
INDOOR CRAC-29 (AL-8,10,12)
OUTDOOR CRAC-29 (AL-2,4,8)
1200A, 480V, 3ø, 4W
PANEL "C" 1200A BUS (RM 160E)
SPARE
PNL "GATE 13" OUTDOOR PANEL
PNL "CP6" (RM 160E) 400A BUS
PANEL "CP-5" 400A BUS (RM 160E)
OUTDOOR UNIT#15 (CP5-4)
OUTDOOR UNIT#13 (CP5-3)
OUTDOOR UNIT#14 (CP5-7)
OUTDOOR UNIT#3 (CP5-9)
OUTDOOR UNIT#12 (CP5-11)
INDOOR UNIT#15 (CP5-6)
INDOOR UNIT#13 (CP5-5)
INDOOR UNIT#14 (CP5-8)
INDOOR UNIT#3 (CP5-10)
INDOOR UNIT#12 (CP5-12)
LIEBERT A/C UNITS, INDOOR 100AMP, COND 20AMP
3 SETS: 4" C - 3 #600MCM, #3/0G
3 SETS: 4" C - 4 #600MCM, #3/0G
XFMR LV 225 KVA 480-120/208V, 3ø, 4W (RM 160E)
PANEL "1V" 800A BUS (RM 160E)
PNL "CP2" BUS (RM 160E)
PNL "C1" 225 BUS (RM 154J)
PNL "DP1" (RM 160E) 600A BUS 480/277,3ø
PNL "CP2" (RM 160E) 600A BUS 480/277,3ø
PNL "CP3" (RM 160E) 400A BUS 480/277,3ø
PNL "CP4" (RM 160E) 400A BUS 480/277,3ø
75KVA XFMR C1-A (RM154J)
45KVA XFMR C1-B (RM154J)
PNL "C1A" 100A BUS (RM 154J)
PNL "C1B" 50A BUS (RM 154J)
480V, 3ø, 4W
PANEL "1A" 400A BUS (RM 160E)
"1A-1" 480/277 225A BUS BLDG LIGHTING (RM 160E)
"1E" 480/277 100A BUS (RM 169)
T-TLE 30KVA XFMR (RM 169)
(RM 134) COMP RM LIGHTING 100A
(RM 134) CR LIGHTING 70A
120/208V, 3ø, 4W
"NBR-3" 225A BUS (RM 160E)
"LP-1" 100A BUS (RM 160E)
"LP-2" (RM 160E) 225A BUS
225A 120/208V, 3ø, 4W
FUEL TANK MONITOR
LEAK DETECTION
GEN 2A BLOCK HEATER
GEN 2 BLOCK HEATERS
GEN 3 BLOCK HEATERS
MCC CONTROLS
1-3 BLOCK HEATER
GEN 2 BATTERY CHARGER
GEN 3 BATTERY CHARGER
FUTURE UPS-4
NEW 750 KVA UPS-3
2 SETS: 3 1/2" C - 4 #500MCM, #2/0G
3ø,4W,480/277 "DLP-1"
"DLP-2" 1200A 480/277 (RM 160E)
1 E2 EXISTING RISER DIAGRAM
NO SCALE