REVISIONS				
LET	DESCRIPTION	PREP'D BY	DATE	APPROVED
REV. A →	AS-BUILT DRWG. NO CORRECTIONS	GREG	40CT82	MURDOCK

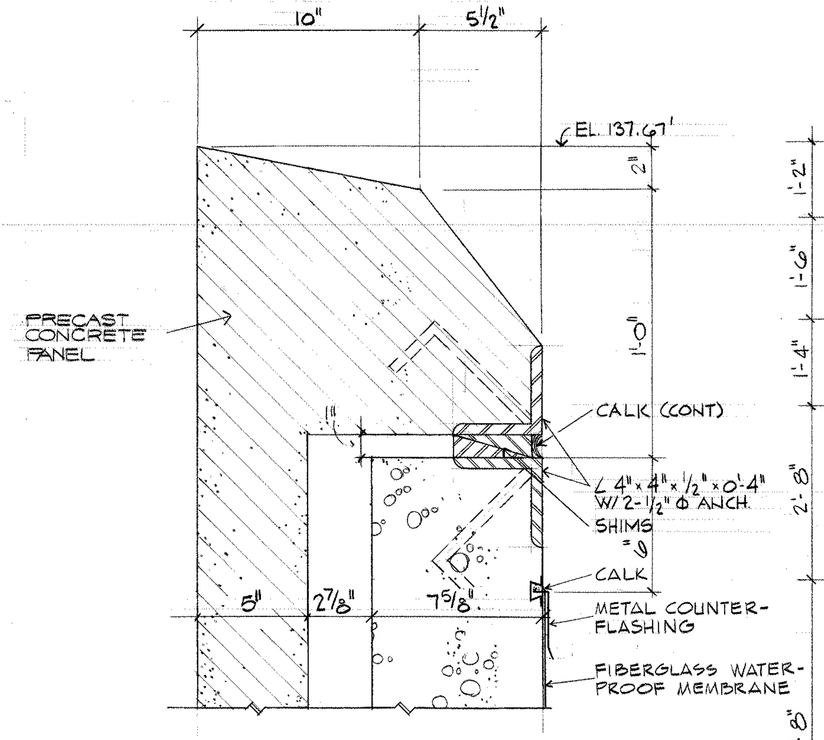

4 BGA6 **DETAIL**
SCALE: 3"=1'0"

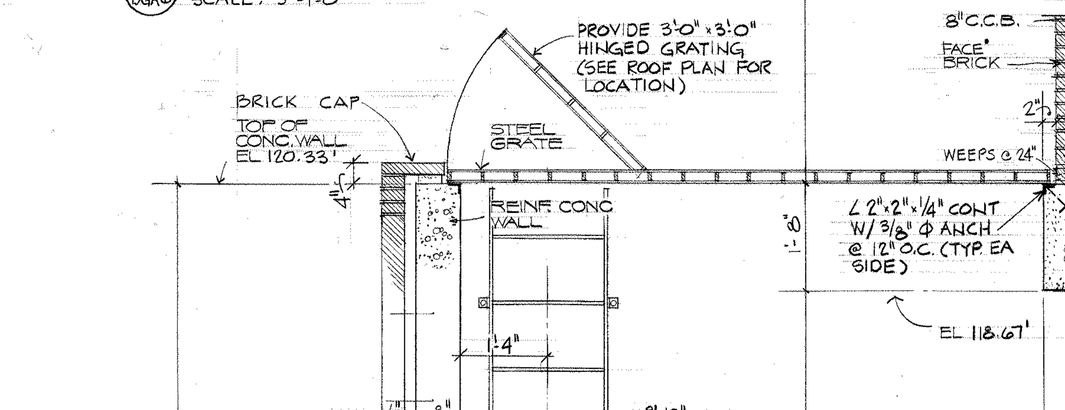

1 BGA6 **SECTION THRU COOLING TOWER**
SCALE 3/4"=1'-0" BGA1 BGA2

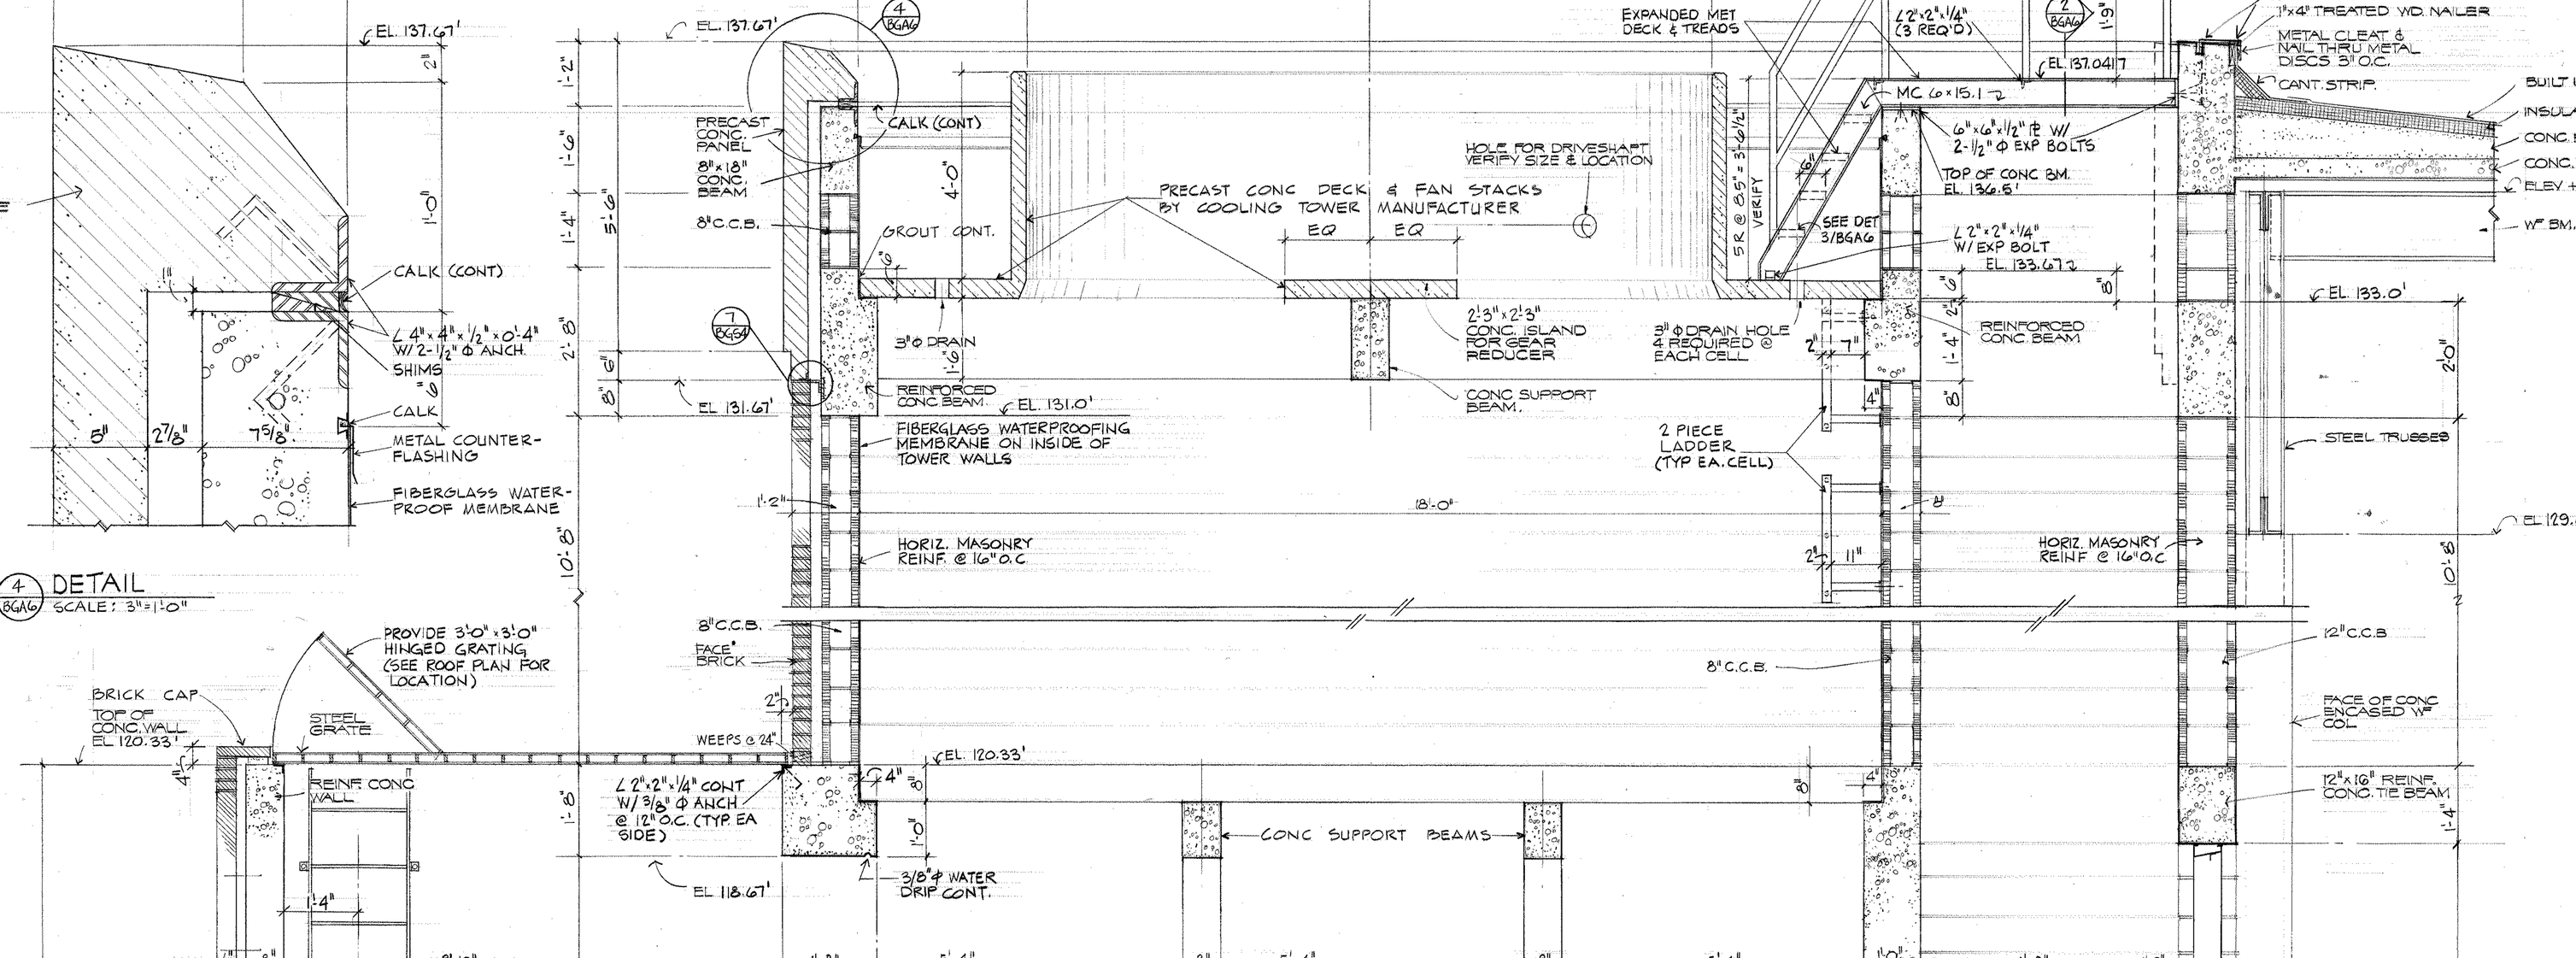

2 BGA6 **SECTION @ BRIDGE**
SCALE: 3"=1'0" BGA6

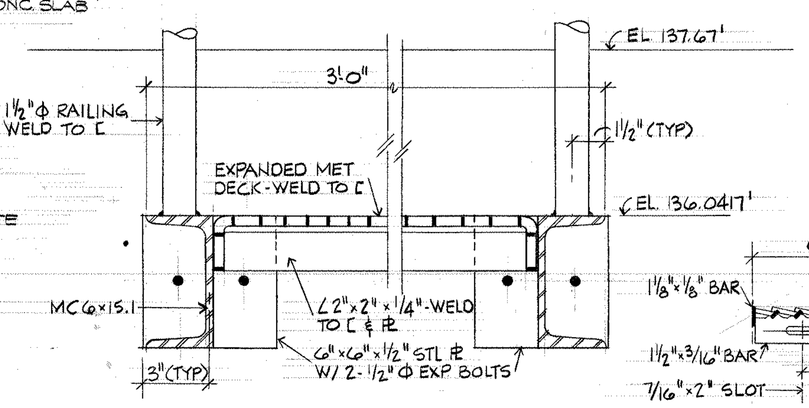

3 BGA6 **TREAD DET.**
N.T.S. BGA6

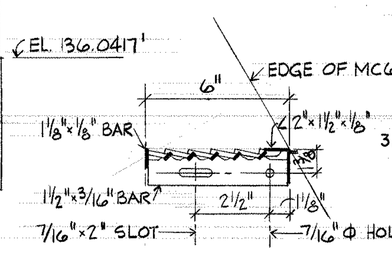

GRAPHIC SCALES
3/4"=1'-0" 12" 0 1' 2' 3'
3"=1'-0" 6" 0 6"

RECORD DRAWING
DATE 11-1-82

ROGERS, LOVELOCK, FRITZ, ROGERS & BUTLER
LOPATKA, MCGUIRE & WALL, CORPORATION
ARCHITECTS-ENGINEERS-PLANNERS
WINTER PARK, FLORIDA 32789

DEPARTMENT OF THE NAVY NAVAL FACILITIES ENGINEERING COMMAND
SOUTHERN DIVISION
CHARLESTON, S. C.

NAVAL REGIONAL MEDICAL CENTER ORLANDO, FLORIDA

DSGN: MURDOCK DR: MURDOCK CHK: MURDOCK
SUPV: MURDOCK CH ENGR: MARTIN
SUBMITTED BY: DATE: 28 Feb 77
FIRM MEMBER OF JOINT VENTURE
SOUTHERN DIV — DESIGN DIVISION
PDE: DIR

HOSPITAL REPLACEMENT

BOILER/GENERATOR BUILDING
COOLING TOWER SECTIONS - SHEET 2 OF 2

APPROVED DATE
OFFICER IN CHARGE

APPROVED DATE
EFD FOR COMMANDER, NAVFAC

BGA 6

SIZE	CODE IDENT NO.	NAVFAC DRAWING NO.
F	80091	5046991
SCALE AS SHOWN		CONSTR CONTR NO. N62467-75-C-0340
		SPEC 06-75-0340 SHEET 400 OF

502

K&E 19 1183 10-75 W3251 6ND-SOUTH DIV-4-11012-15 CAROLINA EXP Print