REVISIONS				
LET	DESCRIPTION	PREP'D BY	DATE	APPROVED
REV. A	AS-BUILT DRWG. NO CORRECTIONS	LOPATKA	40CT82	MURDOCK

DOOR SCHEDULE

LOCATION	NO.	PAIR	DOUBLE EGRESS	SIZE WIDTH	SIZE HEIGHT	SIZE THICKNESS	DOOR TYPE	DOOR MATERIAL	DOOR GLASS	DOOR LOUVER	FRAME MATERIAL	FRAME HEAD	FRAME JAMB	FRAME THRESHOLD	HARDWARE SET	U.L. LABEL	REMARKS
BOILER/GENERATOR BLDG	1			3-0	7-0	1¾	A	1	-	-	1	8/BGA1	9&10/BGA1	5/BGA1	14		
	2	X		3-0	7-0	1¾	B	1		2	1	15&21 BGA1	10/BGA1	5/BGA1	6		
	3			3-0	7-0	1¾	C	1	3		1	1/BGA1	2/BGA1	4/BGA1	122		
	4			2-8	7-0	1¾	A	1	-	-	1	3/BGA1	7/BGA1	4/BGA1	174		UNDER-CUT 1"
	5			2-8	7-0	1¾	A	1	-	-	1	3/BGA1	7/BGA1	4/BGA1	122		
	6			3-0	7-0	1¾	A	1	-	-	1	3/BGA1	7/BGA1	5/BGA1	14		
	7			3-0	7-0	1¾	A	1	-	-	1	3/BGA1	7/BGA1	NONE	122		
	8			3-0	7-0	1¾	A	1	-	-	1	3/BGA1	7/BGA1	5/BGA1	14		
	9			3-0	7-0	1¾	A	1			1	3/BGA1	7/BGA1	NONE	122		UNDER-CUT 1"
	10			14-0	12-0	—	D	1	-	-	—	2/BGA3	7/BGA3	2/BGA3	5		WEATHER SEAL
	11			14-0	12-0	—	D	1	-	-	—	2/BGA3	7/BGA3	2/BGA3	5		WEATHER SEAL
	12			3-0	7-0	1¾	A	1	-	-	1	8/BGA1	10/BGA1	5/BGA1	14		
	13			3-0	7-0	1¾	A	1	-	-	1	8/BGA1	10/BGA1	5/BGA1	14		

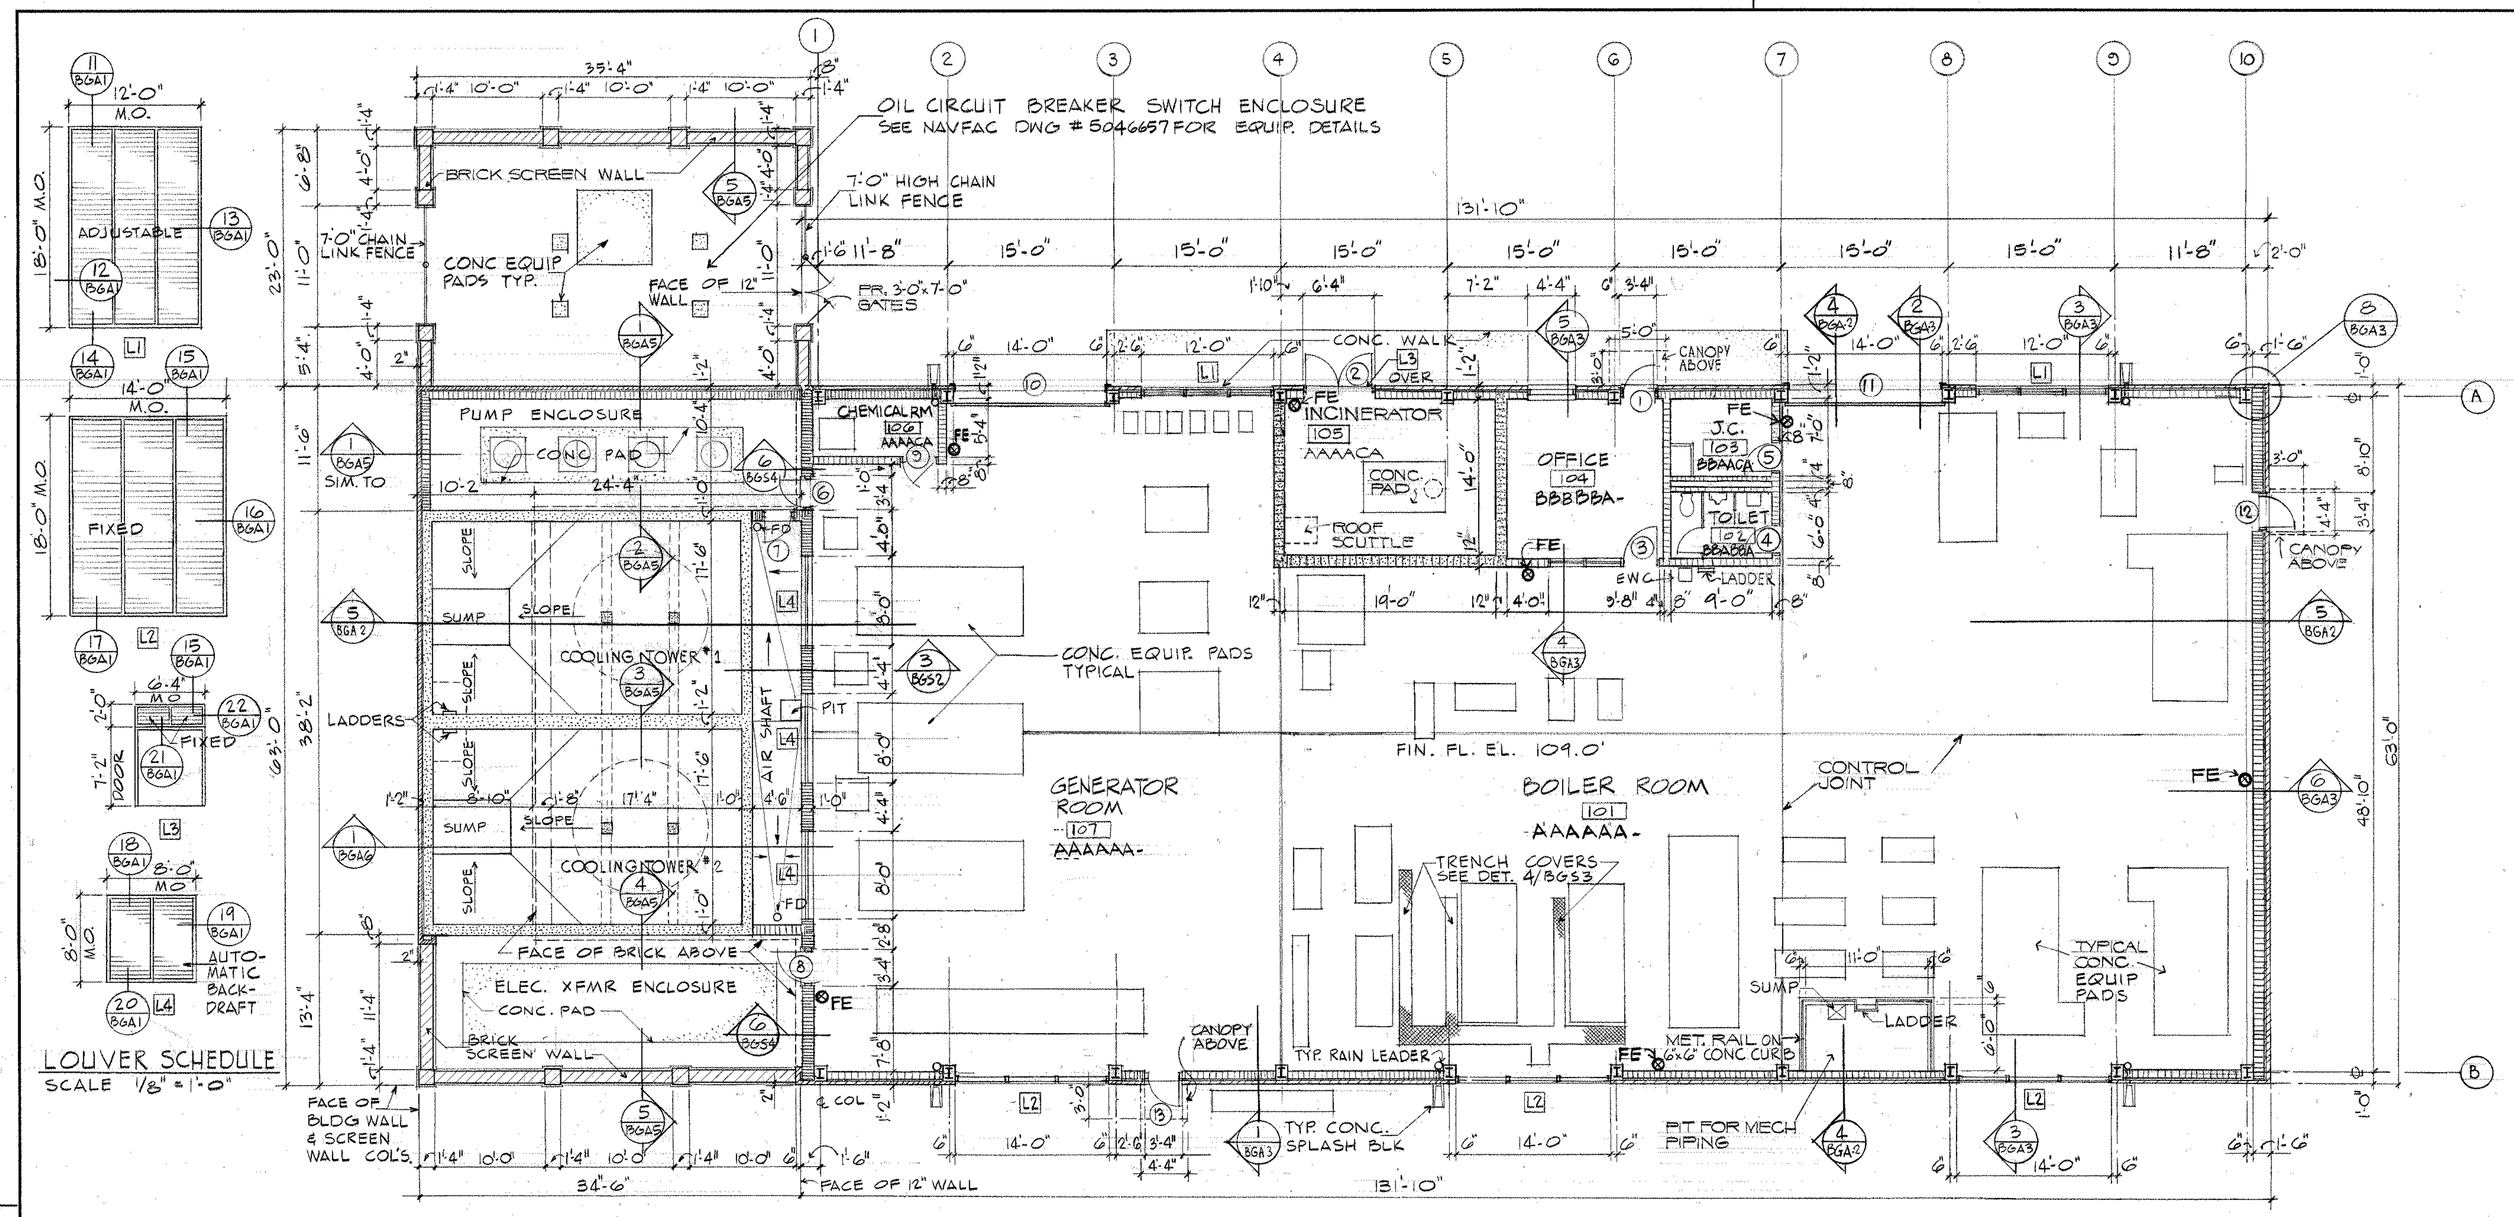

LOUVER SCHEDULE

SCALE 1/8" = 1'-0"

LEGEND

1- HOLLOW METAL
2. FULL LOUVER WEATHERPROOF W/ SCREEN
3- WIRE GLASS

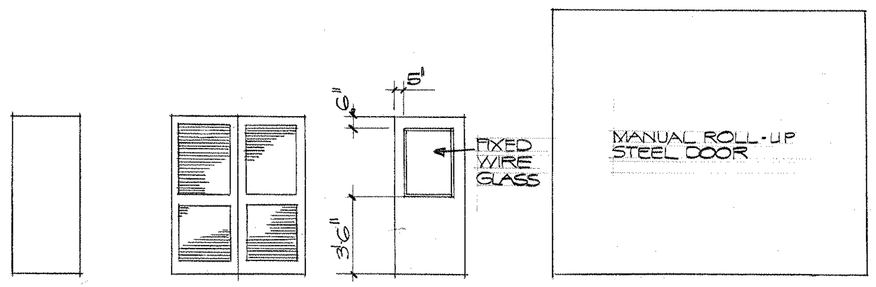

A B C D

DOOR TYPES

ROOM FINISH SCHEDULE

MARK	FLOOR	BASE	WALLS	CEILING	CLG HT	REMARKS
A	CONC	NONE	CCB/PTD	EXP/PTD	VARIES	NONE
B	VAT	VINYL	GWB/PTD	ATC	8'-0"	
C					10'-0"	

EXAMPLE:

OFFICE 104

B B B B B B A

FLOOR ← BASE ← WALLS ← CEILING ← CLG HT. ← REMARKS ←

COLOR NOTES:

1. VAT FLOOR COLOR TO BE VAT-2 WHITE
2. VINYL BASE COLOR TO BE BLACK
3. WALL COLOR TO BE P-1 WHITE
4. CEILING COLOR TO BE P-1 WHITE
5. INTERIOR DOORS & FRAMES TO BE P-1 WHITE
6. EXTERIOR SIDE OF EXTERIOR DOORS, FRAMES, & LOUVERS TO BE DARK BRONZE TO MATCH ANODIZED DARK BRONZE ALUM. WINDOW TRIM.
7. TOILET PARTITION COLOR TO BE S-1-18 TERRA COTTA (SANYMETAL CO. COLOR FOR EXAMPLE ONLY.)
8. ALL PAINT FINISHES TO BE SEMI-GLOSS
9. SEE NAVFAC DWG. 5046775 FOR COLOR SYMBOL DESIGNATIONS.
10. EXPOSED EXTERIOR CCB & CONCRETE TO BE PAINTED TO MATCH BRICK COLOR.
11. PRECAST CONC. FASCIA PANELS SHALL BE FINISHED TO MATCH HOSPITAL BLDG PANELS.

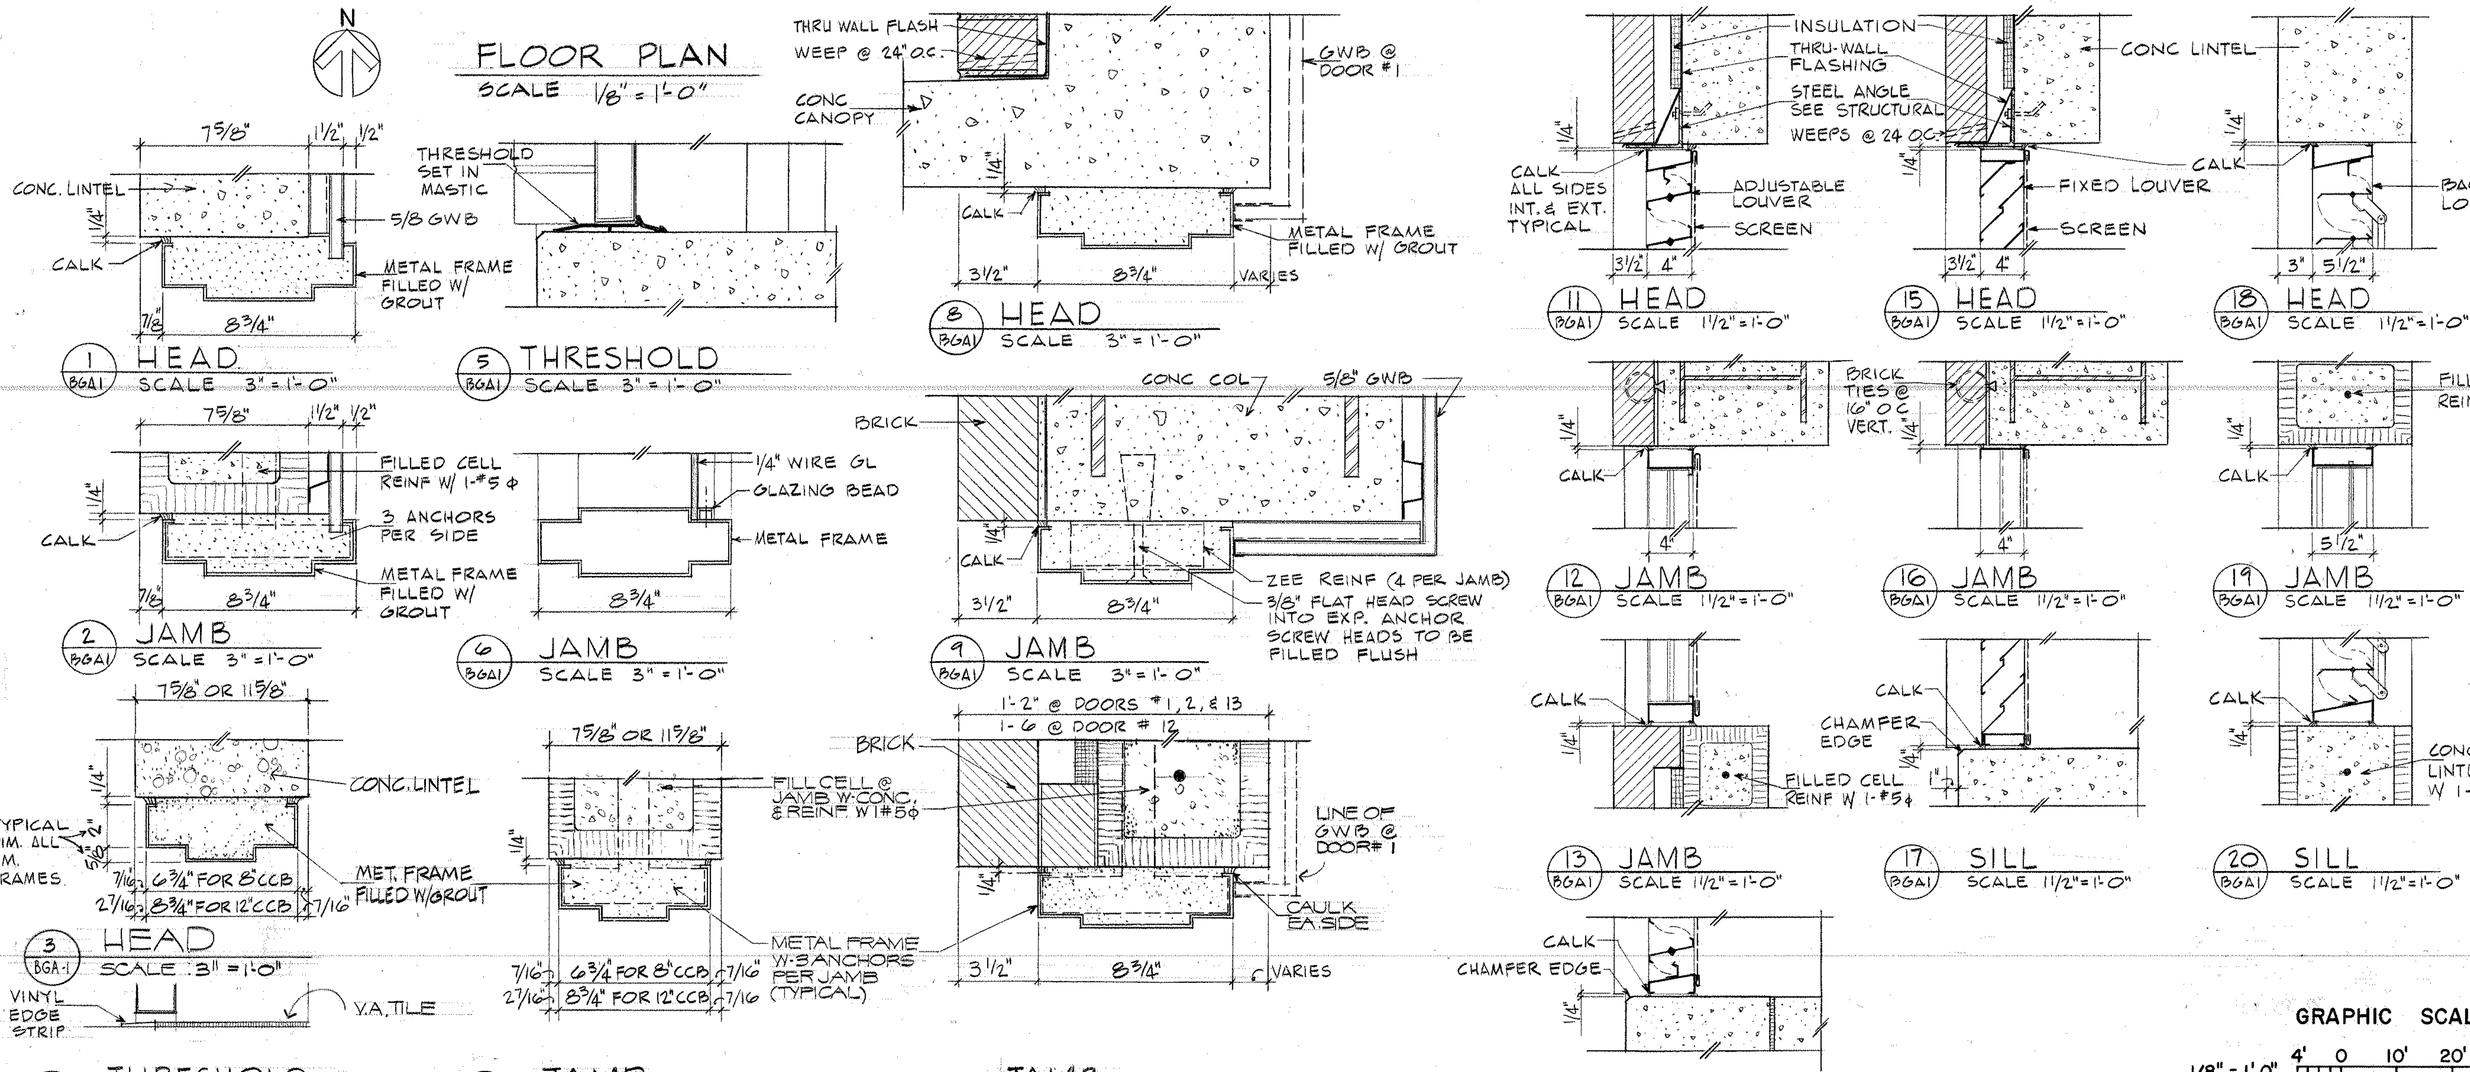

GRAPHIC SCALES

1/8" = 1'-0" 4' 0 10' 20' 30' 40'

1 1/2" = 1'-0" 12" 0 1'

3" = 1'-0" 6" 0 6"

RECORD DRAWING DATE 11-1-82

ROGERS, LOVELOCK, FRITZ, ROGERS & BUTLER LOPATKA, McQUAIG & WALL CORPORATION ARCHITECTS - ENGINEERS - PLANNERS WINTER PARK, FLORIDA 32789	DEPARTMENT OF THE NAVY NAVAL FACILITIES ENGINEERING COMMAND SOUTHERN DIVISION CHARLESTON, S. C.	
DSGN JAM/MAL DR HUMPHREY CHK MURDOCK	NAVAL REGIONAL MEDICAL CENTER ORLANDO, FLORIDA	
SUPV MURDOCK CH. ENGR MARTIN	HOSPITAL REPLACEMENT	
SUBMITTED BY [signature] DATE 20 DEC 71 FIRM MEMBER / TITLE / PARTNER	BOILER/GENERATOR BUILDING FLOOR PLAN & DETAILS	
SOUTHERN DIV. - DESIGN DIVISION - PDE [signature] DIR	APPROVED DATE	SIZE F; CODE IDENT NO. 80091; NAVFAC DRAWING NO. 5046986
OFFICER IN CHARGE	APPROVED [signature] DATE 3/21/72	CONSTR CONTR NO. N62467-75-C-0340
BGA 1	FOR COMMANDER, NAVFAC	SCALE AS SHOWN; SPEC 06-75-0340; SHEET 395 OF

KAE 19 1183 10-79 W3256• 6ND-SOUTH DIV-6-11012-13 CAROLINA E&P P452