


FORT HARRISON
PHARMACY

169

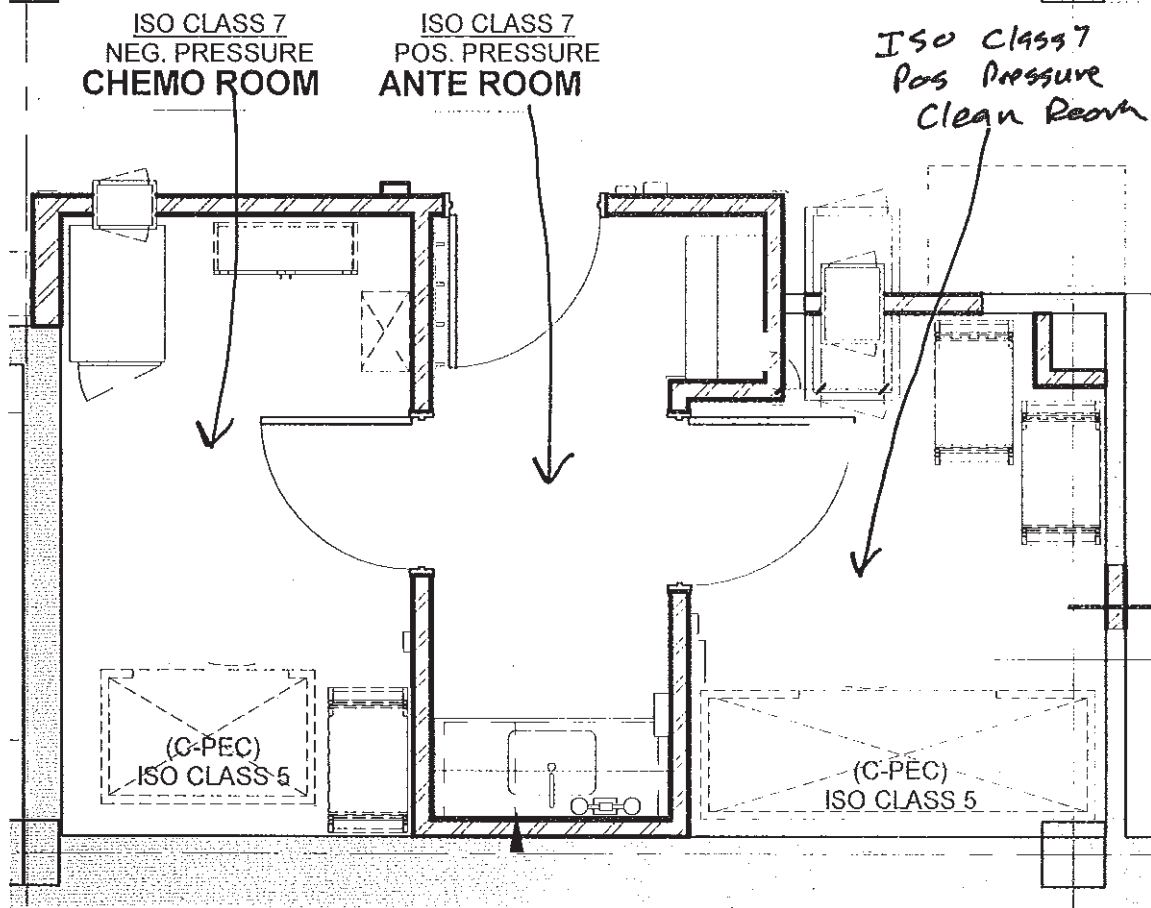

CAI - Glovebox in
unclassified room

