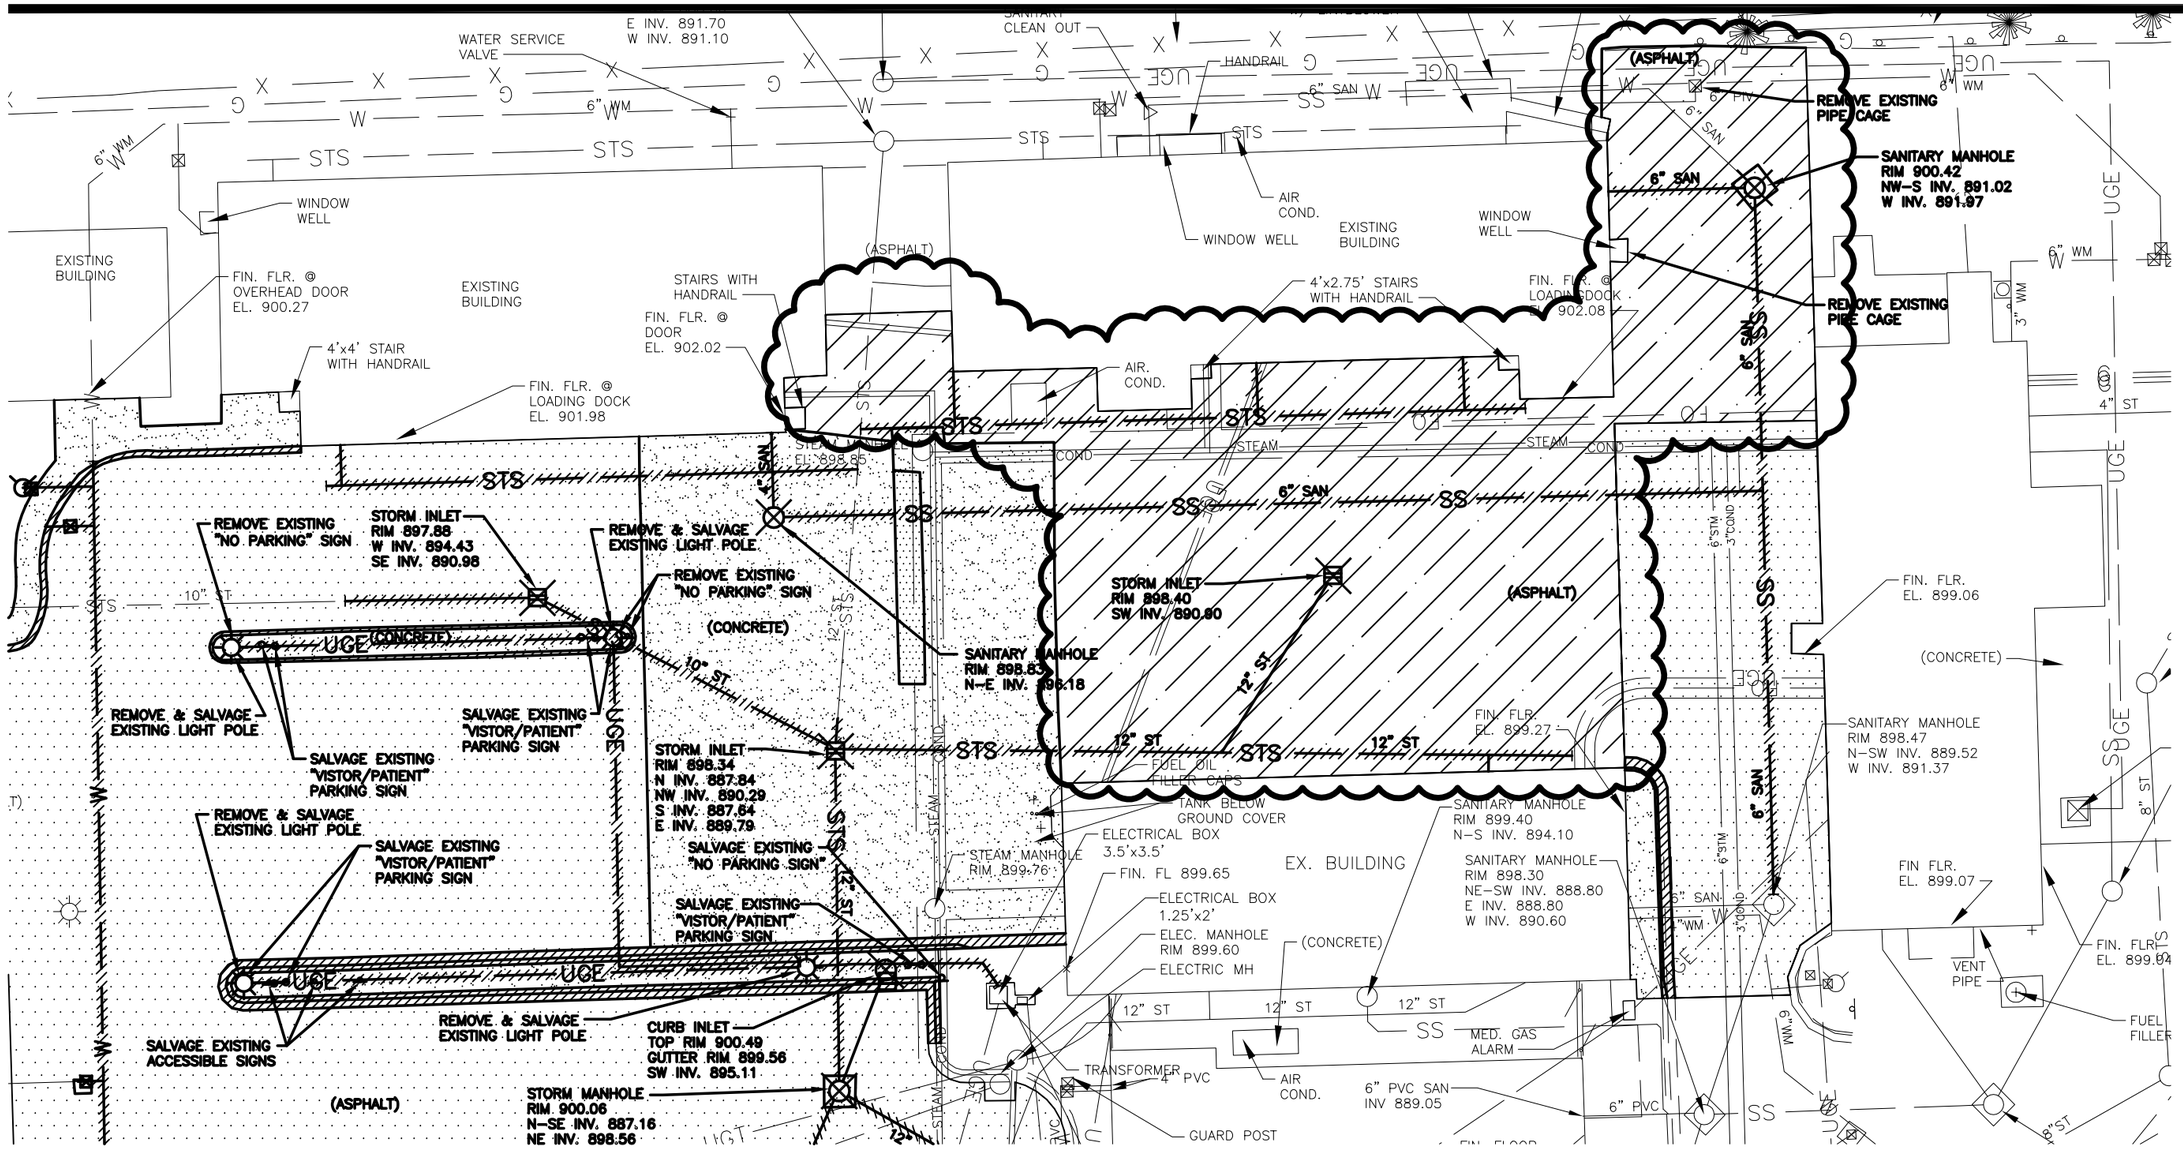

REMOVE EXISTING CONCRETE PAVEMENT W/ ASPHALT OVERLAY

0 15 30 60

SCALE: 1 INCH = 30 FEET

MBN ENGINEERING

MECHANICAL * ELECTRICAL * CIVIL

VA MEDICAL CENTER
REPLACE UTILITY MAINS & ASPHALT
PHASE 2 DEMOLITION REVISIONS

FARGO, NORTH DAKOTA

MBN JOB #: 11-110
REVISION DATE: 12-4-12

R1
C2.1