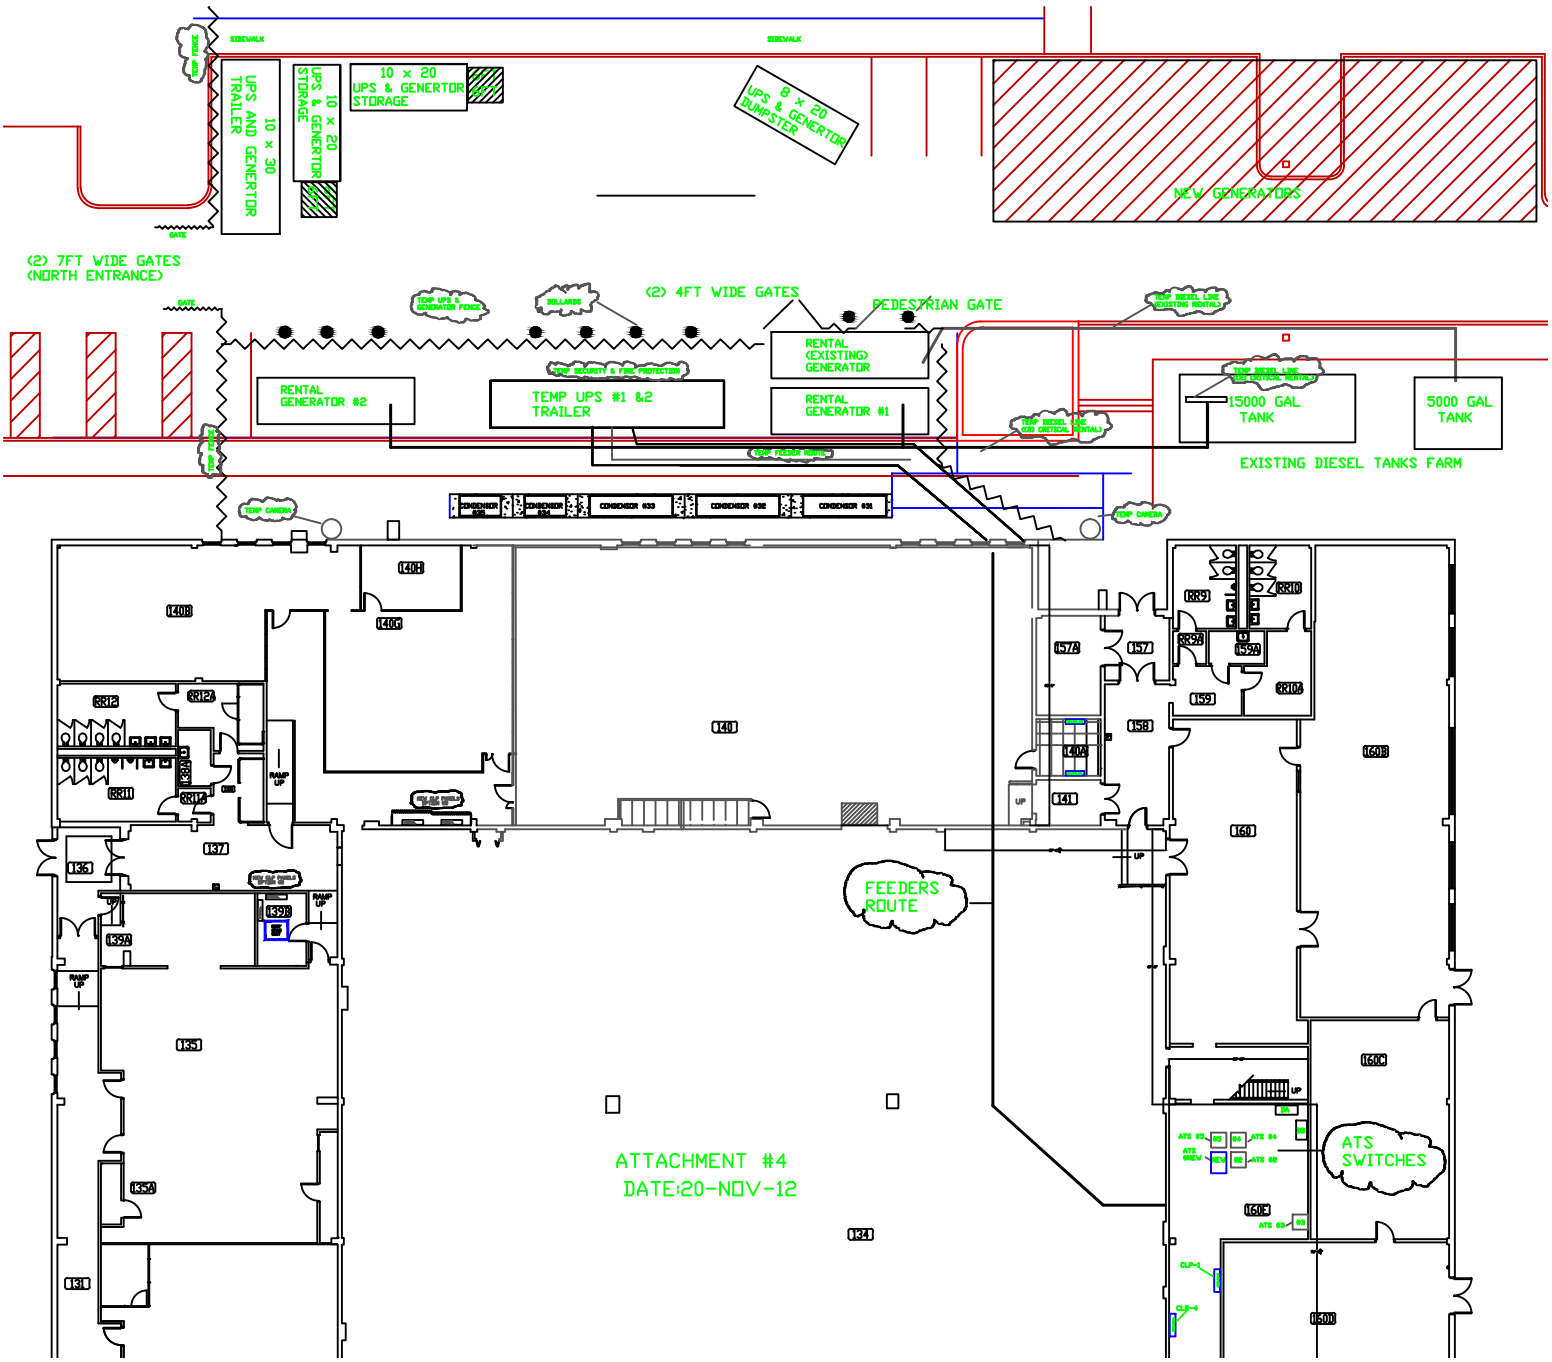

SIDEWALK
SIDEWALK
TEMP FENCE
10 x 30
UPS AND GENERTOR
TRAILER
10 x 20
UPS & GENERTOR
STORAGE
10 x 20
UPS & GENERTOR
STORAGE
8 x 20
UPS & GENERTOR
DUMPSTER
NEW GENERATORS
GATE
(2) 7FT WIDE GATES
(NORTH ENTRANCE)
GATE
TEMP UPS & GENERATOR FENCE
BOLLARDS
(2) 4FT WIDE GATES
PEDESTRIAN GATE
TEMP DIESEL LINE (EXISTING RENTAL)
RENTAL
(EXISTING)
GENERATOR
TEMP SECURITY & FIRE PROTECTION
RENTAL
GENERATOR #2
TEMP UPS #1 &2
TRAILER
RENTAL
GENERATOR #1
TEMP DIESEL LINE (OR CRITICAL RENTAL)
15000 GAL
TANK
5000 GAL
TANK
EXISTING DIESEL TANKS FARM
TEMP FEEDER ROUTE
TEMP CAMERA
TEMP CAMERA
CONDENSER #35
CONDENSER #34
CONDENSER #33
CONDENSER #32
CONDENSER #31
140H
140G
140B
RR12
RR12A
RR11
RR11A
138A
RAMP UP
137
136
139B
139A
RAMP UP
RAMP UP
135
135A
131
140
FEEDERS
ROUTE
ATTACHMENT #4
DATE:20-NOV-12
134
157A
157
RR9
RR10
RR9A
159A
159
RR10A
158
140A
141
UP
160B
160
UP
160C
UP
ATS SWITCHES
160E
160D