Heat Exchanger 3rd Floor

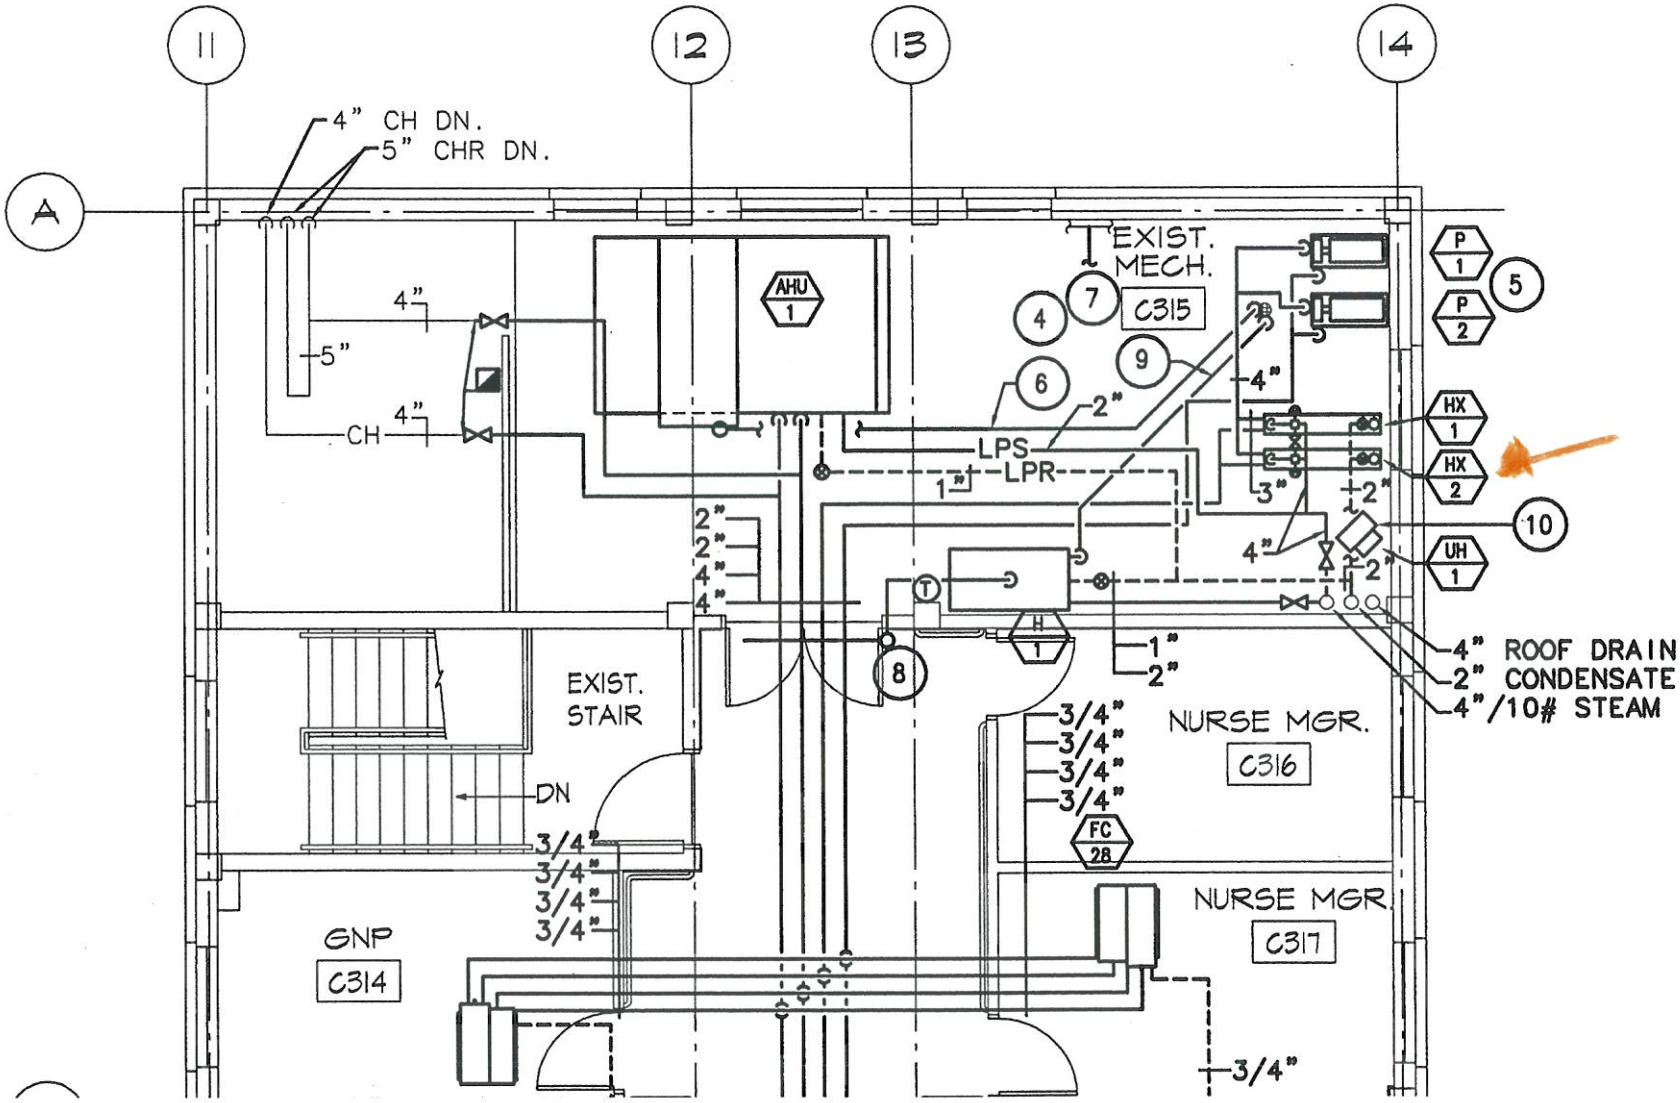

GENERAI

A. C
I
T

B. E
B
B

C. H
P
D

SPECIF

1. 3/
AB

2. 1"
AB

3. OF
FL
RE-
CH
WI