REVISION	DESCRIPTION	CHECKED BY:	DATE:
1	ADD ONE-LINE, CORRECT HEADEND ROOM NUMBER	KJS	12/6/2007

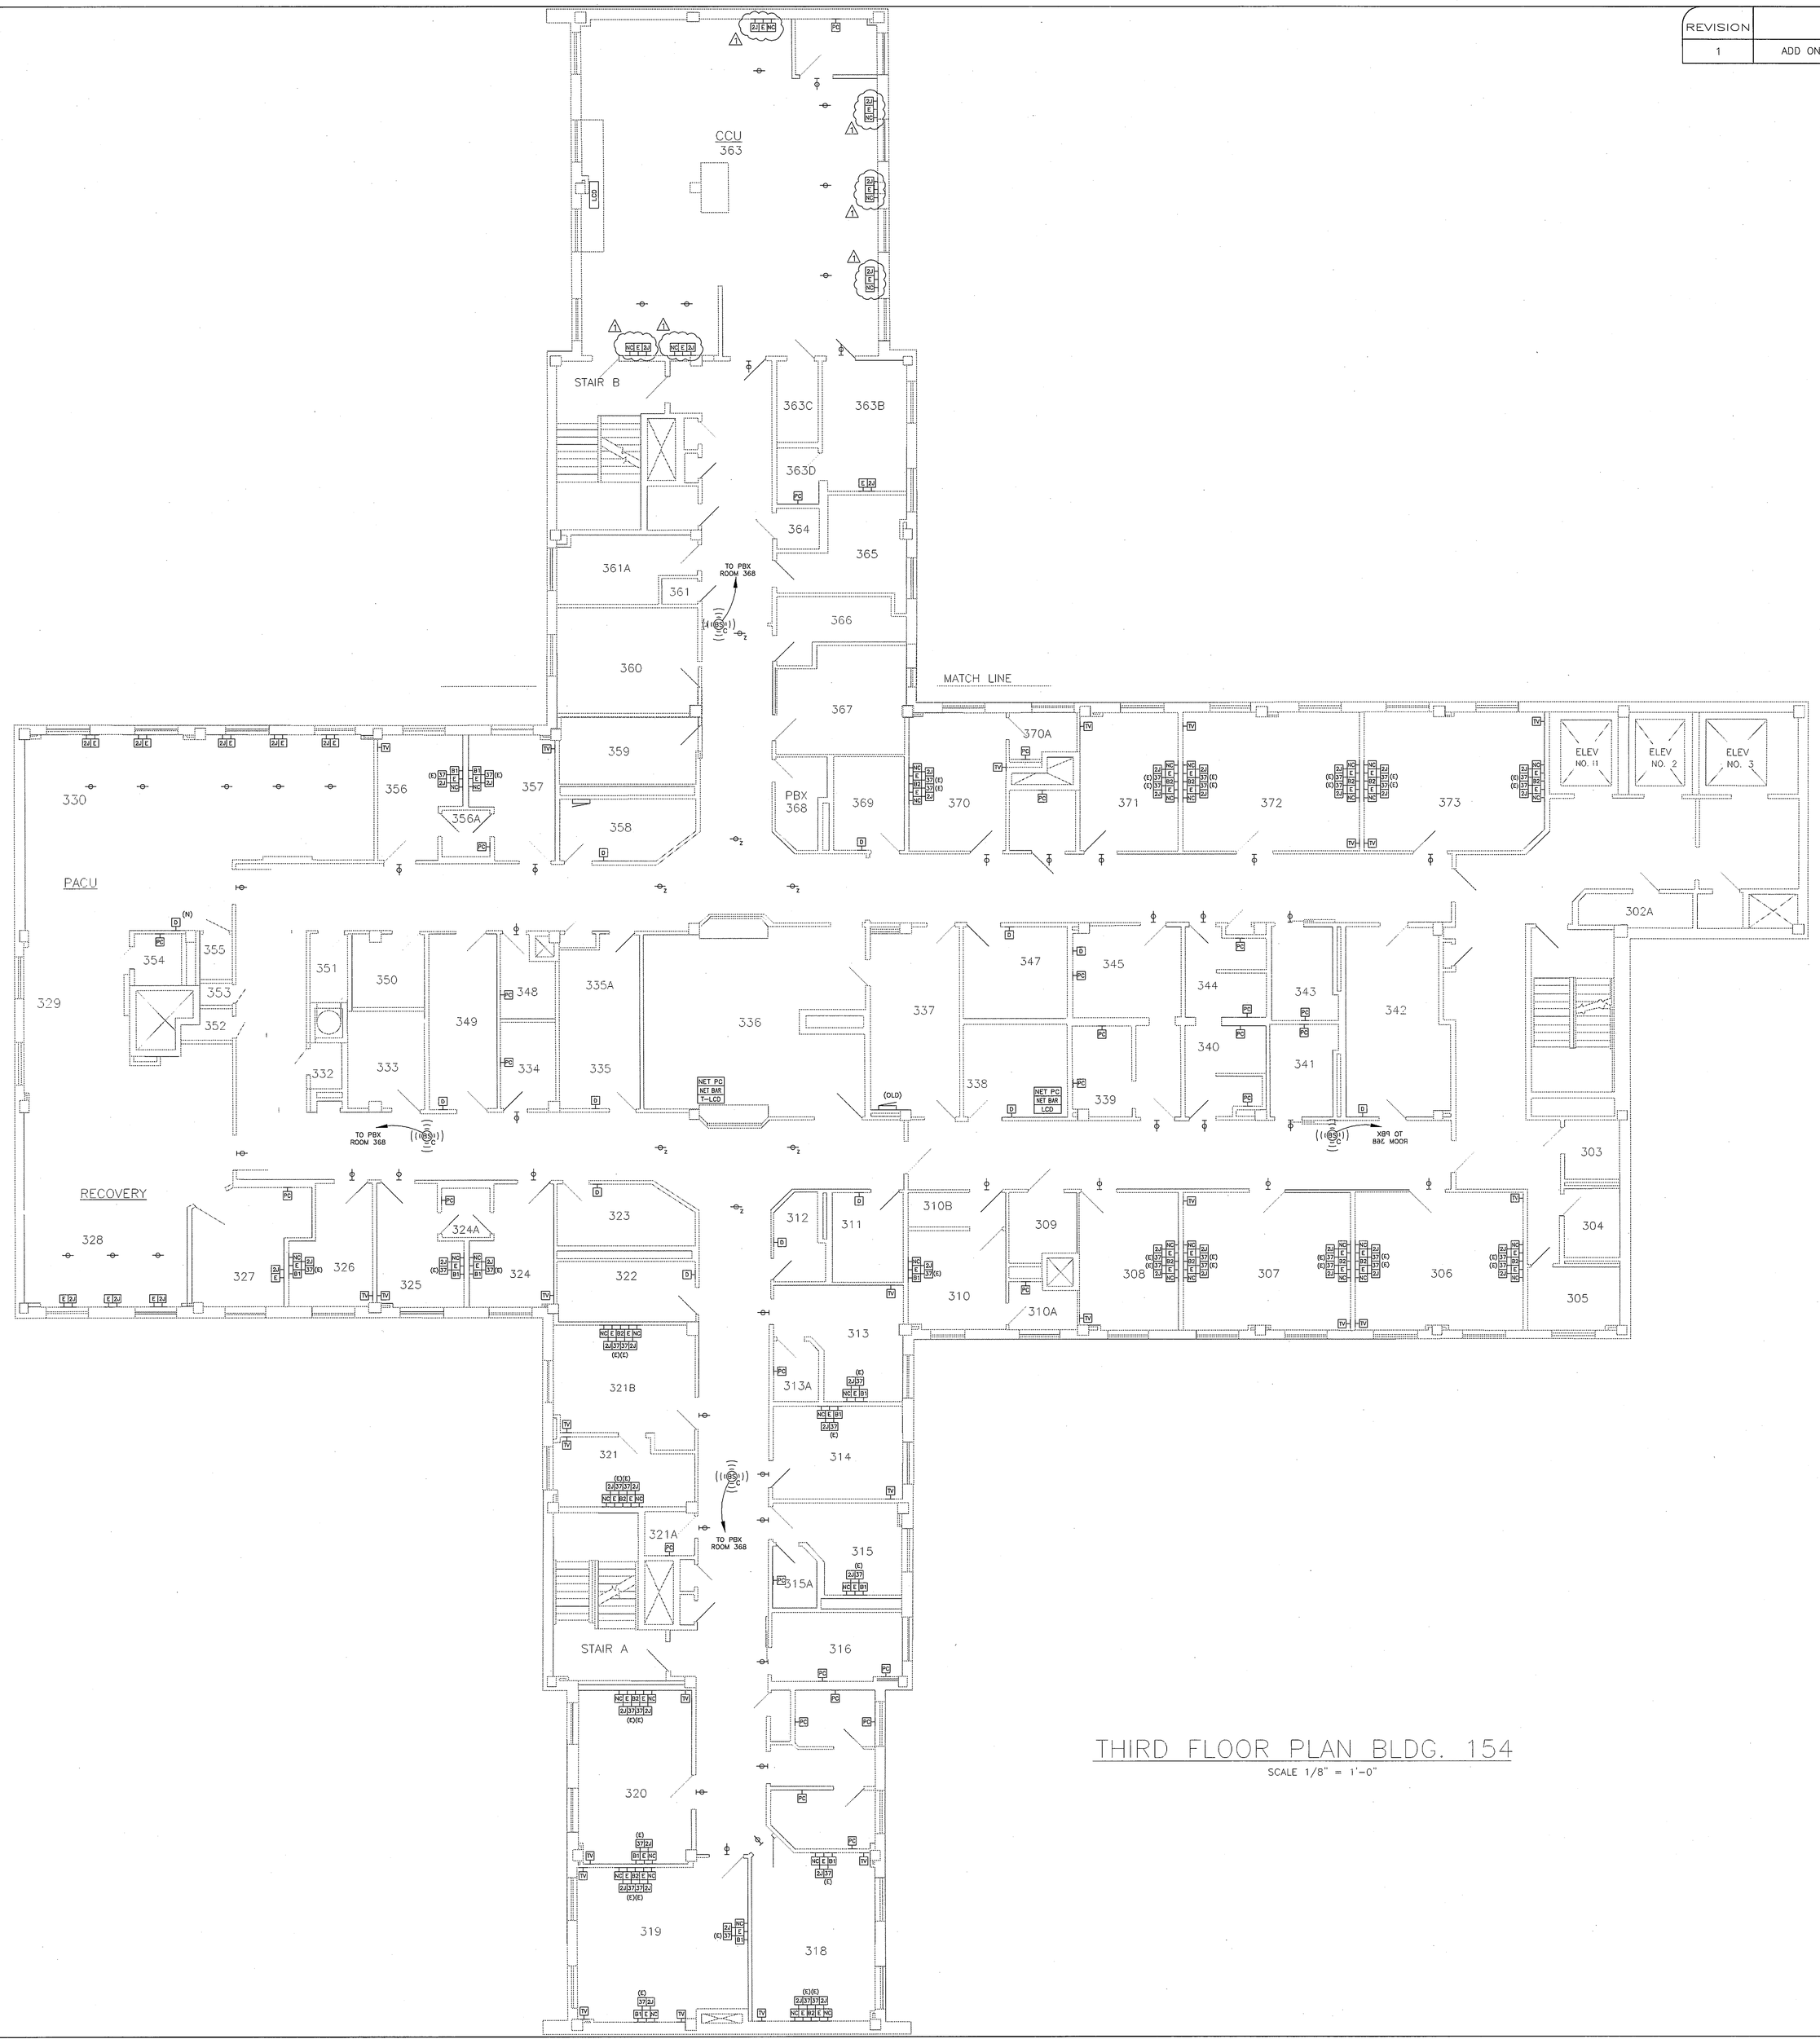

THIRD FLOOR PLAN BLDG. 154

SCALE 1/8" = 1'-0"

NURSE CALL SYSTEM
FLOOR PLAN
SHOP DRAWING

HELENA VA HOSPITAL

HELENA, MT

Since 1949 EVCO inc.
N. 218 LEE STREET
SPOKANE, WA. 99202
(509) 535-8718
FAX: 534-2795

JOB NUMBER:	07-266
DRAWN BY:	KJS
CHECKED BY:	DTM
DATE:	10/02/2007
SCALE:	1/8" = 1'-0"
FILE NAME:	07-266-3rd.dwg
NC3-4	EVCO SHEET NO.
	REFERENCE BID DOCUMENT SHEET