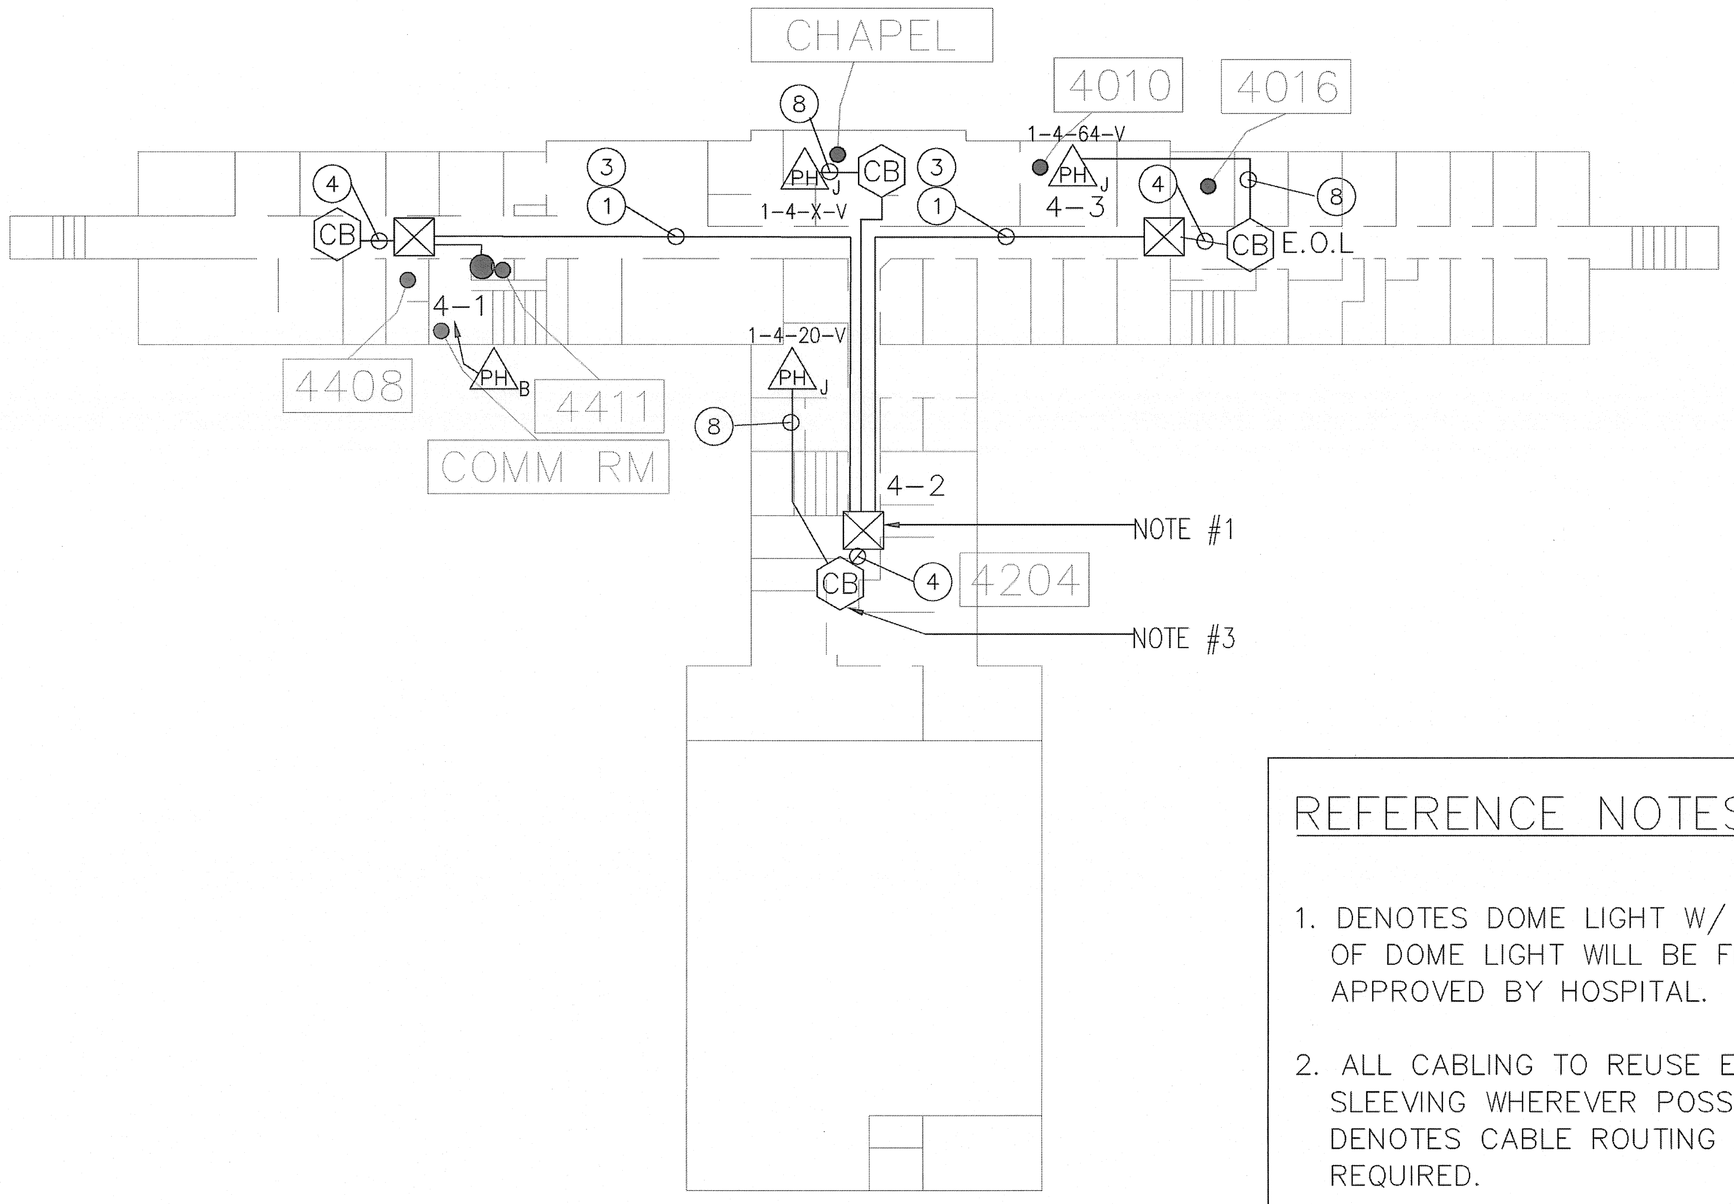

REFERENCE NOTES

1. DENOTES DOME LIGHT W/ RTT. ACTUAL LOCATION OF DOME LIGHT WILL BE FIELD DETERMINED & APPROVED BY HOSPITAL.

2. ALL CABLING TO REUSE EXISTING RACEWAYS & SLEEVING WHEREVER POSSIBLE. THIS PLAN DENOTES CABLE ROUTING AND NOT RACEWAY REQUIRED.

3. DENOTES LOCATION OF REMOTE CODE BLUE STATION. ACTUAL SITE TO BE FIELD DETERMINED & APPROVED BY HOSPITAL.

N FOURTH FLOOR

NO.	DATE	REVISION DESCRIPTION
A	02/21/08	RECORD DRAWINGS (BDC)
B	01/26/09	RECORD DRAWINGS (MDP)
C	04/03/09	RENUMBER DRAWINGS AND ADD NC1.08 (MDP)
D	06/05/09	RECORD DRAWINGS (PH)
E	02/10/10	RECORD DRAWING PER FEBRUARY COMMENTS (GLS)

tyco / Fire & Security / SimplexGrinnell

6240 SMITH ROAD
DENVER, COLORADO 80216
SALES: (303) 355-0500
SERVICE: (303) 355-0500
FAX: (303) 355-0515

©2001 SIMPLEXGRINNELL LP
ALL RIGHTS RESERVED

NURSE CALL SYSTEM FOR:
VAMC – GRAND JUNCTION, COLORADO

NURSE CALL REPLACEMENT AND UPGRADES

2121 NORTH AVE.
GRAND JUNCTION, COLORADO 81501

DRAWN BY: KO	DATE: 04/25/04
DESIGNED BY:	DATE:
APPROVED BY:	DATE:
PROJECT #: 847597001	
SCALE: NTS	
SHEET TITLE: CODE BLUE FLOOR PLAN	
SHEET NUMBER: NC1.03.4	