NURSE CALL SYSTEM FOR:
VAMC – GRAND JUNCTION, COLORADO

NURSE CALL REPLACEMENT AND UPGRADES

212B

NO.	DATE	REVISION DESCRIPTION
A	02/21/08	RECORD DRAWINGS (BDC)
B	01/26/09	RECORD DRAWINGS (MDP)
C	04/03/09	RENUMBER DRAWINGS AND ADD NC1.08 (MDP)
D	06/05/09	RECORD DRAWINGS (PIH)
E	02/10/10	RECORD DRAWING PER FEBRUARY COMMENTS (GLS)

DRAWN BY: KO | DATE: 04/25/04
DESIGNED BY: | DATE:
APPROVED BY: | DATE:
PROJECT #: 847597001
SCALE: N.T.S.
SHEET TITLE: DETAIL SHEET
SHEET NUMBER: NC1.07

tyco / Fire & Security / SimplexGrinnell
6240 SMITH ROAD
DENVER, COLORADO 80216
SALES: (303) 355-0500
SERVICE: (303) 355-0500
FAX: (303) 355-0615
©2001 SIMPLEXGRINNELL LP
ALL RIGHTS RESERVED

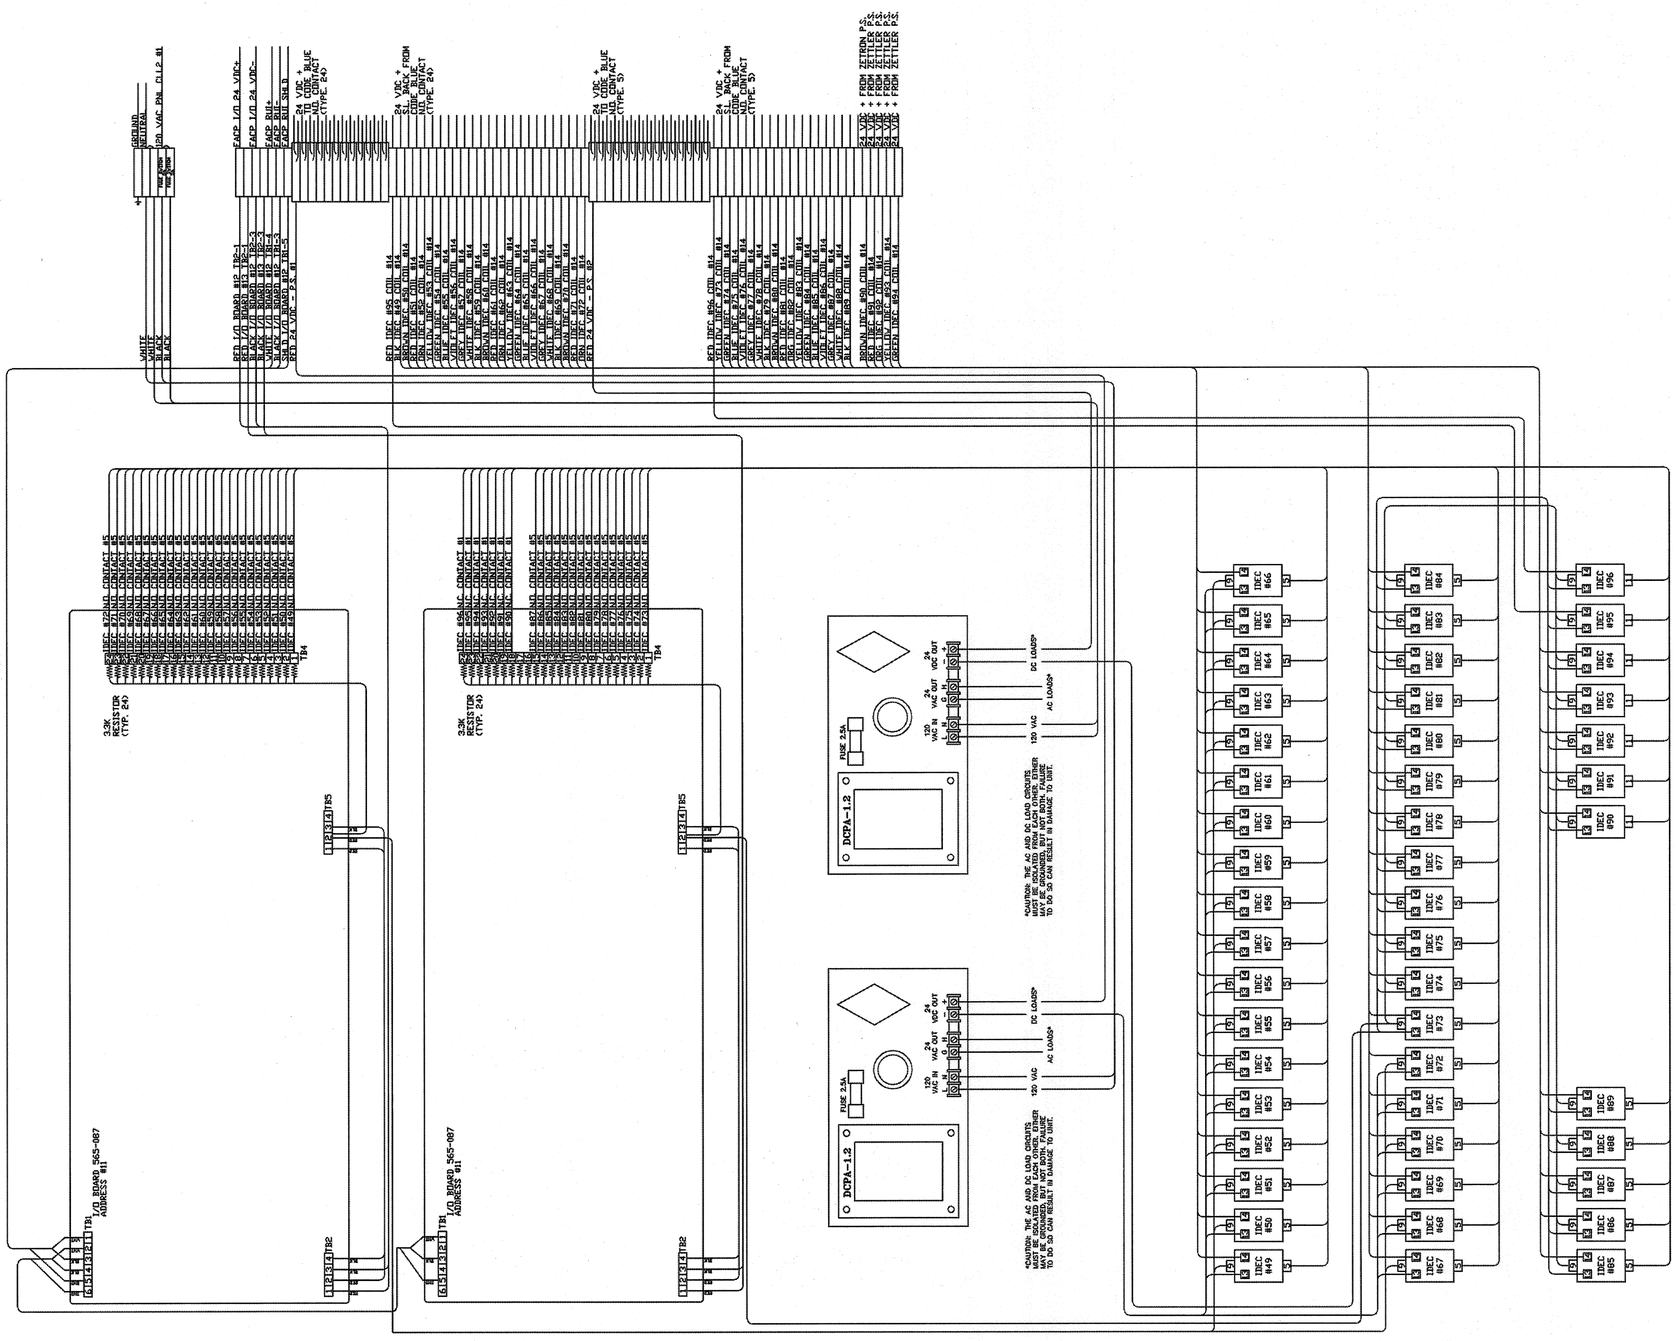

FA I/O	Pair Colors	Location	Room Number	Jack Number
51	Wh/Bl–Bl/Wh	5th Floor	5411	1–5–17V
52	Wh/Or–Or/Wh	5th Floor	5412	Phone Closet OR pair
53	Wh/Gr–Gr/Wh	5th Floor	ICU 1	1–5–14V
54	Wh/Br–Br/Wh	5th Floor	ICU 2	1–5–13V
55	Wh/Sl/Sl/Wh	5th Floor	ICU 3	1–5–35V
56	Rd/Bl–Bl/Rd	5th Floor	ICU 4	1–5–36V
57	Rd/Or–Or/Rd	5th Floor	5419A	Phone Closet OR pair
58	Rd/Gn–Gn/Rd	5th Floor	5419B	1–5–28V
59	Rd/Br–Br/Rd	5th Floor	5420	1–5–26V
60	Rd/Sl–Sl/Rd	5th Floor	5001	1–5–43V
61	Bk/Bl–Bl/Bk	5th Floor	5002	1–5–38V
62	Bk/Or–Or/Bk	Spare		
63	Bk/Gn–Gn/Bk	Spare		
64	Bk/Br–Br/Bk	Spare		
65	Bk/Sl–Sl/Bk	Spare		
66	Yl/Bl–Bl/Yl	Spare		
67	Yl/Or–Or/Yl	Spare		
68	Yl/Gn–Gn/Yl	Spare		
69	Yl/Br–Br/Yl	Spare		
70	Yl/Sl–Sl/Yl	Spare		
71	V/Bl–Bl/V	Spare		
72	V/Or–Or/V	Spare		
73	V/Gn–Gn/V	Spare		
74	V/Br–Br/V	5th Floor	PACU 1	1–5–24V
75	V/Sl–Sl/V	5th Floor	PACU 2	1–5–23V
76	Wh/Bl–Bl/Wh	5th Floor	PACU 3	1–5–22V
77	Wh/Or–Or/Wh	5th Floor	PACU 4	1–5–21V
78	Wh/Gn–Gn/Wh	5th Floor	PACU 5	1–5–20V
79	Wh/Br–Br/Wh	Rm. 103–34	ZERON	Phone Closet OR pair
80	Wh/Sl/Sl/Wh	6th Floor	Zettler Pn. #1	Phone Closet OR pair
81	Rd/Bl–Bl/Rd	6th Floor	Zettler Pn. #2	Phone Closet OR pair
82	Rd/Or–Or/Rd	TCU	Zettler Pn. #3	Phone Closet OR pair
83	Rd/Gn–Gn/Rd	2nd Floor	Zettler Pn. #4	Phone Closet OR pair
84	Rd/Br–Br/Rd	5th Floor	PACU 6	1–5–19V
85	Rd/Sl–Sl/Rd	AOD	1695	OPC–1B–78V
86	Bk/Bl–Bl/Bk	ER 1614	Hall (Outside 1619)	OPC–1B–24V
87	Bk/Or–Or/Bk	ER 1639	(Outside Wall)	OPC–1B–86V
88	Bk/Gn–Gn/Bk	ER 1614	Headwall 1616	OPC–1B–21V
89	Bk/Br–Br/Bk	4th Floor	Chaplain	1–4–59V
90	Bk/Sl–Sl/Bk	1st Floor	1696	OPC–1A–23V
91	Yl/Bl–Bl/Yl	1st Floor	1678	OPC–1A–52V
92	Yl/Or–Or/Yl	1st Floor	1679	OPC–1A–47V
93	Yl/Gn–Gn/Yl	1st Floor	Hall (Outside 1694)	OPC–1A–42V
94	Yl/Br–Br/Yl	1st Floor	Hall (Outside 1700)	OPC–1A–25V
95	Yl/Sl–Sl/Yl	2nd Floor	CAT Scan Room	OPC–1A–31V
96	V/Bl–Bl/V	Spare		
97	V/Or–Or/V	Spare		
98	V/Gn–Gn/V	Spare		
99	V/Br–Br/V	Spare		
100	V/Sl–Sl/V	Spare		

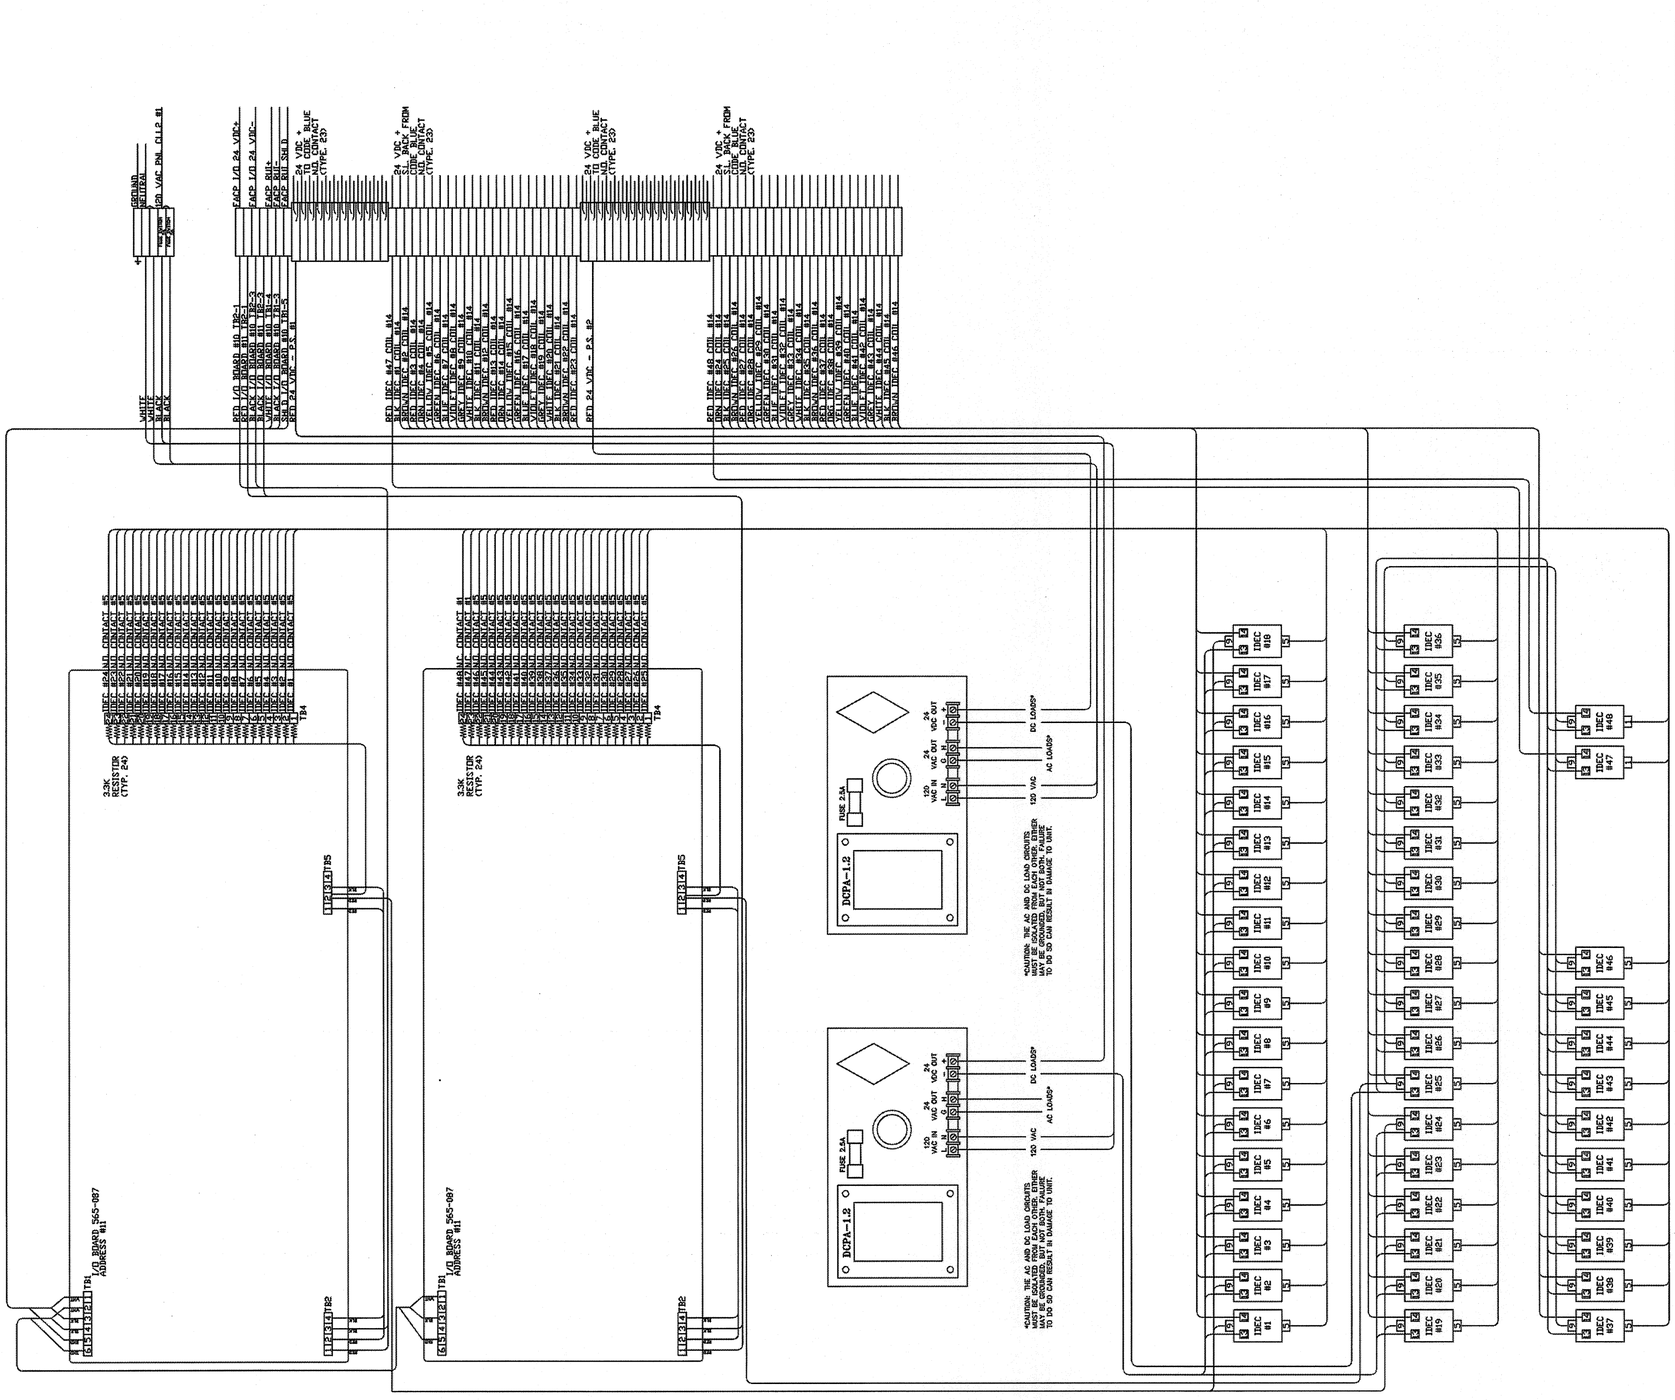

FA I/O	Pair Colors	Location	Room	Number	Jack Number
1	Wh/Bl–Bl/Wh	TCU	Dining Room		20–1–7V
2	Wh/Or–Or/Wh	TCU		106A	20–1–16V
3	Wh/Gr–Gr/Wh	TCU		106B	20–1–15V
4	Wh/Br–Br/Wh	TCU		109A	20–1–17V
5	Wh/Sl/Sl/Wh	TCU		109B	20–1–18V
6	Rd/Bl–Bl/Rd	TCU		110	20–1–21V
7	Rd/Or–Or/Rd	TCU		112	20–1–19V
8	Rd/Gn–Gn/Rd	TCU		113	20–1–20V
9	Rd/Br–Br/Rd	TCU		115	20–1–22V
10	Rd/Sl–Sl/Rd	TCU		116	20–1–23V
11	Bk/Bl–Bl/Bk	TCU		118	20–1–24V
12	Bk/Or–Or/Bk	TCU		119	20–1–25V
13	Bk/Gn–Gn/Bk	TCU		121	20–1–26V
14	Bk/Br–Br/Bk	TCU		122	20–1–27V
15	Bk/Sl–Sl/Bk	TCU		125	20–1–28V
16	Yl/Bl–Bl/Yl	TCU		126	20–1–29V
17	Yl/Or–Or/Yl	TCU		129	20–1–30V
18	Yl/Gn–Gn/Yl	TCU	Congregate Bath		Phone Closet OR pair
19	Yl/Br–Br/Yl	TCU		137	20–1–31V
20	Yl/Sl–Sl/Yl	TCU		138	20–1–32V
21	V/Bl–Bl/V	TCU		140	20–1–33V
22	V/Or–Or/V	TCU		173	20–1–14V
23	V/Gn–Gn/V	TCU		144	20–1–3V
24	V/Br–Br/V	TCU		146A	20–1–1V
25	V/Sl–Sl/V	TCU		146B	20–1–2V
26	Wh/Bl–Bl/Wh	1st Floor	Amb. Surg		OPC–1A–21V
27	Wh/Or–Or/Wh	1st Floor	Station A		OPC–1B–69V
28	Wh/Gr–Gr/Wh	1st Floor	Out Patient ER		OPC–1B–27V
29	Wh/Br–Br/Wh	1st Floor	Recd		Phone Closet OR pair
30	Wh/Sl/Sl/Wh	1st Floor	Pharmacy		1–1–12V
31	Rd/Bl–Bl/Rd	2nd Floor	Canteen		1–1–15V
32	Rd/Or–Or/Rd	2nd Floor	Dental		OPC–2A–63V
33	Rd/Gn–Gn/Rd	2nd Floor	MHC		OPC–2A–78V
34	Rd/Br–Br/Rd	2nd Floor	Library		OPC–2B–42V
35	Rd/Sl–Sl/Rd	2nd Floor	Audiology		OPC–2B–56V
36	Bk/Bl–Bl/Bk	2nd Floor	Radiology		1–Ca–1V
37	Bk/Or–Or/Bk	2nd Floor	OT/PT		Phone Closet OR pair
38	Bk/Gn–Gn/Bk	2nd Floor	Laboratory		1–2B–27V
39	Bk/Br–Br/Bk	2nd Floor	Pharmacy		1–2B–36V
40	Bk/Sl–Sl/Bk	3rd Floor	Nurses Station		1–3–35V
41	Yl/Bl–Bl/Yl	3rd Floor	Dressings		1–3–18V
42	Yl/Or–Or/Yl	4th Floor	Kitchen		Phone Closet OR pair
43	Yl/Gn–Gn/Yl	4th Floor	Directors Suite		OPC–1A–25V
44	Yl/Br–Br/Yl	4th Floor	Physicians Offices		OPC–1A–31V
45	Yl/Sl–Sl/Yl	4th Floor	SP3		1–4–20V
46	V/Bl–Bl/V	6th Floor	SR		1–4–6V
47	V/Or–Or/V	Elev. Mach.	6613	GB	I/O#1 P. Supply
48	V/Gn–Gn/V	Elev. Mach.	6613		I/O#2 P. Supply