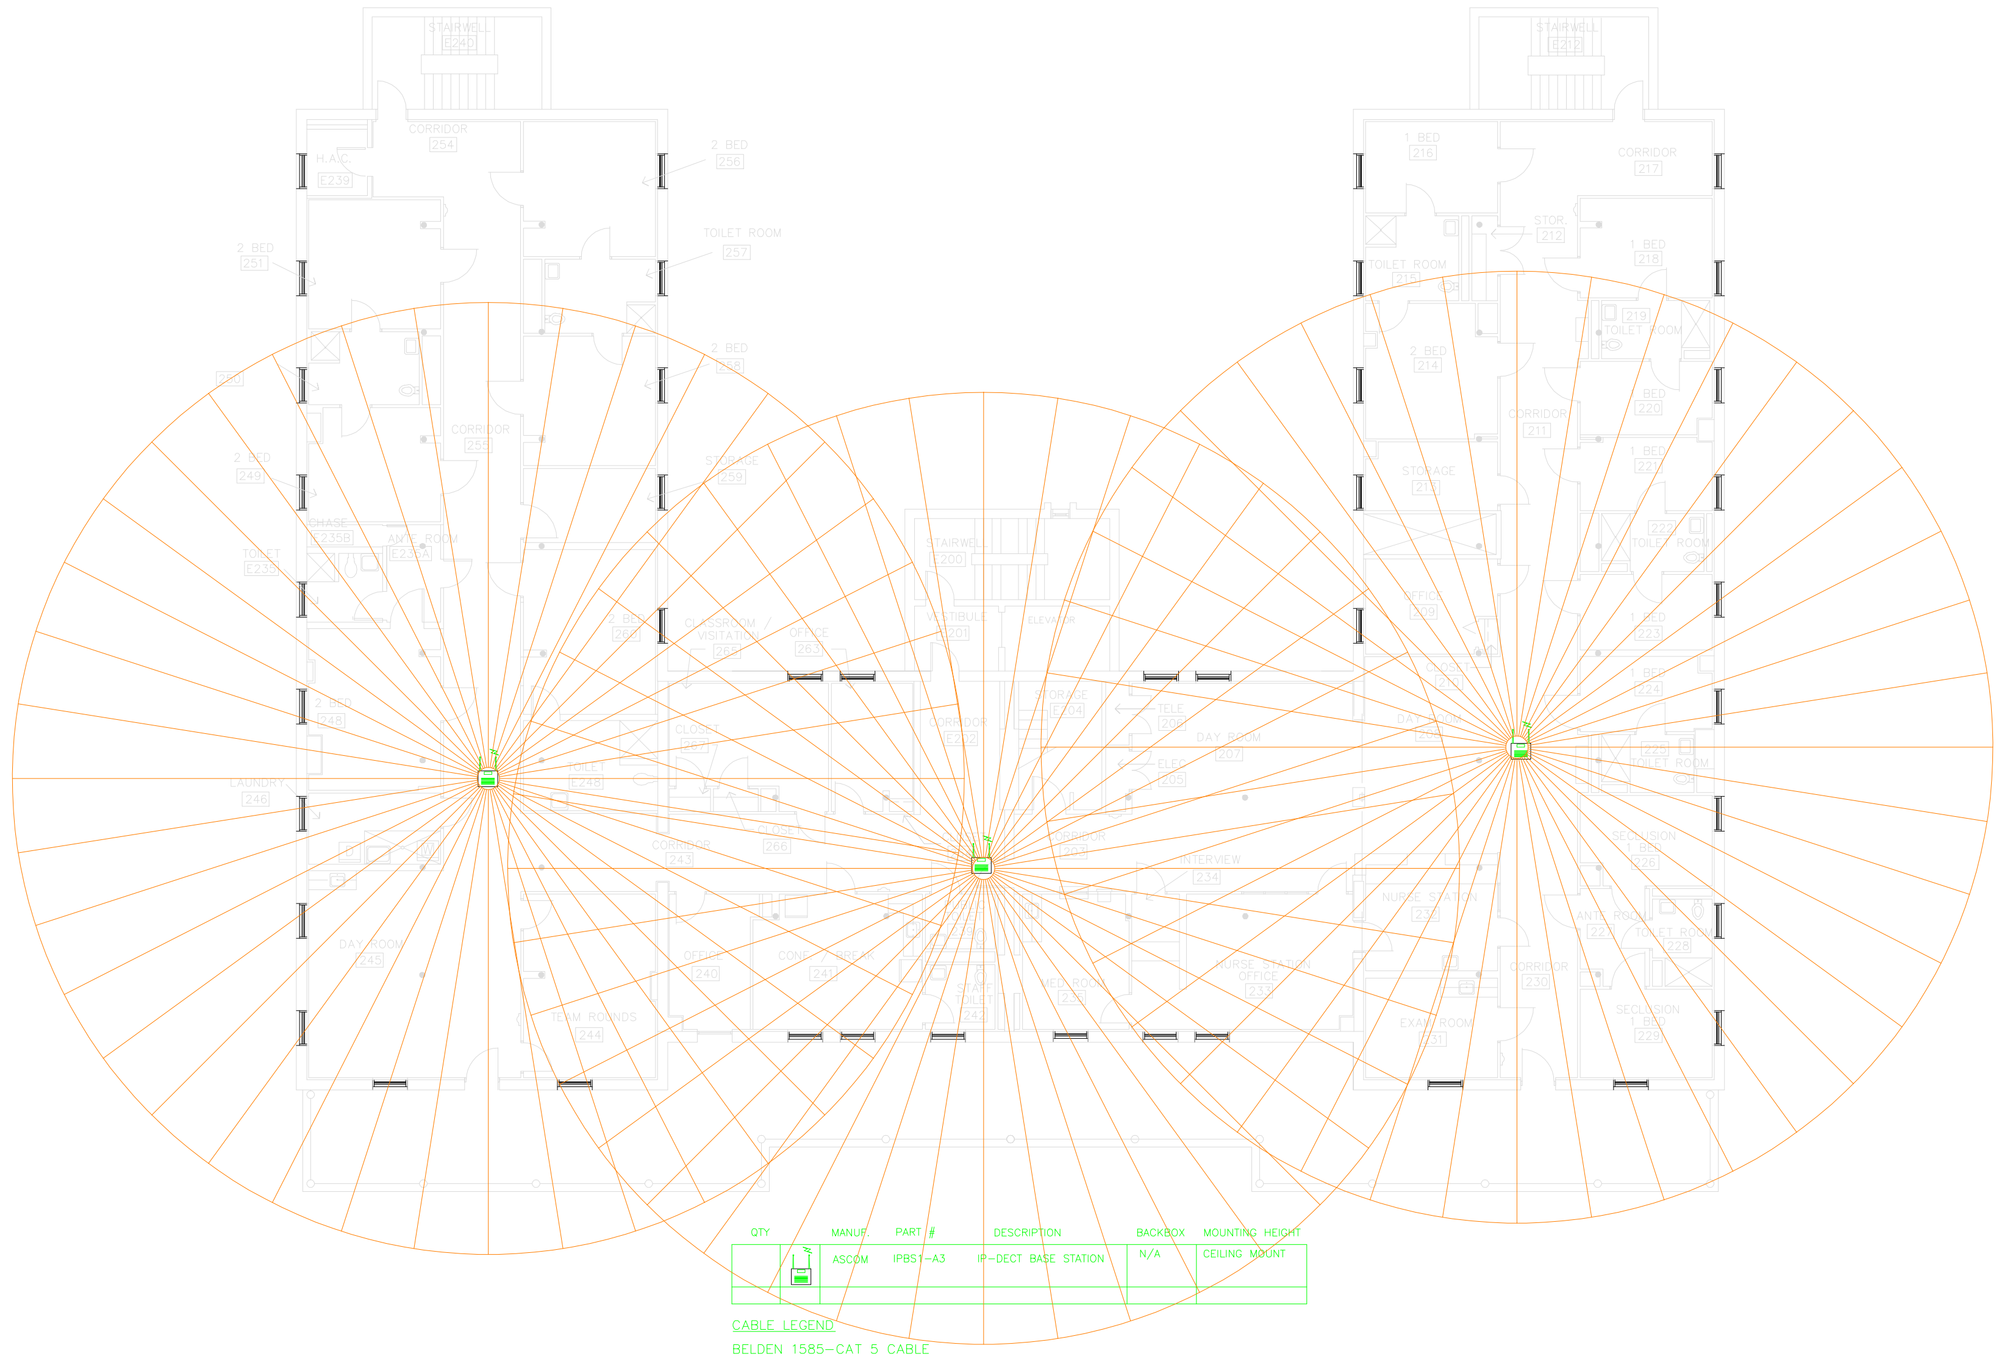

QTY	MANUF.	PART #	DESCRIPTION	BACKBOX	MOUNTING HEIGHT
	ASCOM	IPBS1-A3	IP-DECT BASE STATION	N/A	CEILING MOUNT

CABLE LEGEND:
BELDEN 1585-CAT 5 CABLE

NOTES:
ALL LOW VOLTAGE WIRING TO ROOM 233.

1 SECOND FLOOR TRACER FLOOR PLAN
1/8"=1'

Beacon
Value. Integrity. Service.
4242 Delaware Street
Denver, CO 80216
303-750-6500
www.beaconcom.com

Key Plan:

VA MEDICAL CENTER
BUILDING 8 MENTAL HEALTH
SHERIDAN, WYOMING
RESPONDER IV NURSE CALL SYSTEM

Job No.

Approved:

Date:

Drawn: Mike Clute

Issue Record:

Submittal Date: 9/17/2009

Revision: A Date: 6/21/10
ASBUILT

Revision: Date:

Revision: Date:

Contents:

SECOND FLOOR
ASCOM
BLDG 8
AS 1.21

S:_2008 Proposed Jobs\Healthcare\VA Medical Center-Sheridan WY\Drawings\Beacon\8 2nd Floor Block Plan2000.dwg, 6/22/2010 7:32:09 AM, DWG To PDF.pc3