NURSE CALL

RESPONDER IV SYMBOL LIST

Symbol	Manuf.	Part #	Description
NCT	RAULAND	NC2828	NURSE CALL TERMINAL WITH GROUP CONTROL MODULE & POWER SUPPLIES
NM T	RAULAND	NTCSM	TOUCH SCREEN NURSE'S MASTER CONTROL
NM L	RAULAND	NCLCD	LCD NURSE'S MASTER CONTROL
S	RAULAND	NCSTAFF	STAFF STATION
D	RAULAND	NCDUTY	DUTY STATION
SP	RAULAND	NCBSS1	SINGLE PATIENT STATION
RK	RAULAND	NCBED	HILL ROM INTERFACE KIT
FAM	RAULAND	NCFAM	FIRE / AUX MODULE
EP	RAULAND	NCPCSI	TOILET & SHOWER EMERGENCY STATION
CB	RAULAND	NCDPB2	DUAL PUSH BUTTON STATION STAFF ASSIST / CODE
CP	RAULAND	NCSPB1	CODE PINK STATION
PB	RAULAND	NCDPB2	DUAL PUSH BUTTON STATION BED READY/HOUSE KEEPING
QJ	RAULAND	NC4JACK	QUAD JACK
DJ	RAULAND	NC2JACK	DUAL JACK
D	RAULAND	NCLED6	CORRIDOR DOME
Z	RAULAND	NCLED6	ZONE LIGHT
US	RAULAND	NCUS1	NON-AUDIO UNIVERSAL INTERFACE MODULE
S1	RAULAND	NCJSOLO	SOLO DROP MODULE
B2	RAULAND	NCBSPLIT2	CONTROL STATION SPLITTER
S3	RAULAND	NCBSPLIT3	CONTROL STATION SPLITTER
S4	RAULAND	NCSSPLIT4	SUB-STATION SPLITTER
JD	RAULAND	NCJDROP	J-BUS INTERFACE
			TRACER SENSOR
DC	RAULAND	352020	DOMELESS CONTROLLER
CLS	BEACON	CUSTOM	CUSTOM LOCKING STATION
HS	RAULAND	HSS113	HIGH SECURITY PUSH BUTTON STATION STAFF ASSIST / CODE high
PH	RAULAND	NCPBPH	PUSH FOR HELP STATION

CABLE LEGEND

A = PAIGE 800040 12 AWG POWER CABLE
B = PAIGE 800038 14 AWG POWER CABLE
C = PAIGE 800002 J-BUS OR X-BUS CABLE
D = PAIGE 800008 J-DROP AND CONSOLE CABLE
E = PAIGE 800014 S-BUS CABLE
F = PAIGE 800012 CL-DROP CABLE
H = PAIGE 454691AHW TV AND LIGHTING CONTROL CABLE

ALL CABLE PULL TO LOW VOLTAGE ROOM 233.
SCALE: 1/8" = 1'

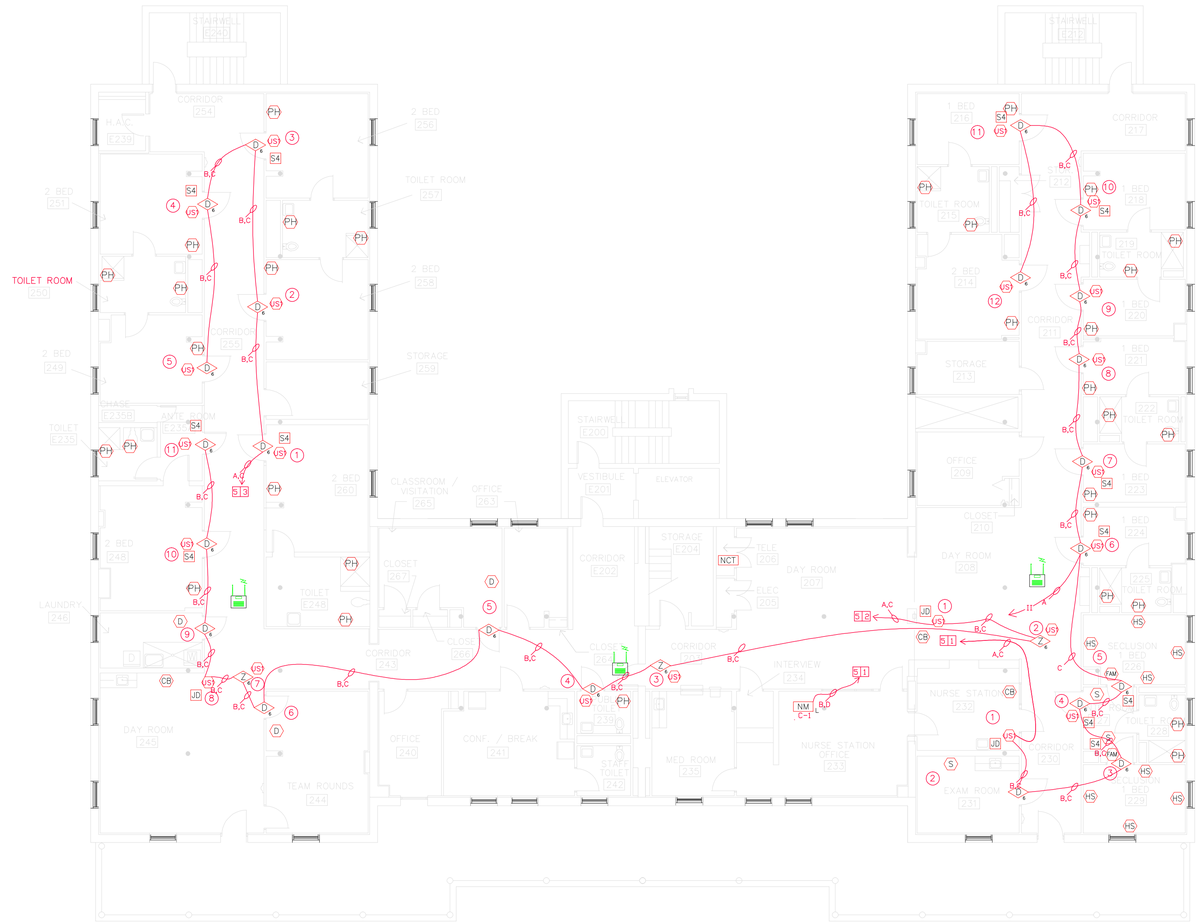

QTY		MANUF.	PART #	DESCRIPTION	BACKBOX	MOUNTING HEIGHT
		ASCOM	IPBS1-A3	IP-DECT BASE STATION	N/A	CEILING MOUNT

CABLE LEGEND

BELDEN 1585-CAT 5 CABLE

NOTES:

ALL LOW VOLTAGE WIRING TO ROOM 233.

1 SECOND FLOOR NURSE CALL FLOOR PLAN

1/8"=1'

Beacon
Value. Integrity. Service.
4242 Delaware Street
Denver, CO 80216
303-750-6500
www.beaconcom.com

Key Plan:

VA MEDICAL CENTER
BUILDING 8 MENTAL HEALTH
SHERIDAN, WYOMING

RESPONDER IV NURSE CALL SYSTEM

Job No.

Approved:

Date:

Drawn: Mike Clute

Issue Record:

Submittal Date: 9/17/2009

Revision: A ASBUILT Date: 6/21/10

Revision: Date:

Revision: Date:

Contents:

SECOND FLOOR NURSE CALL BLDG 8

NC-1.07