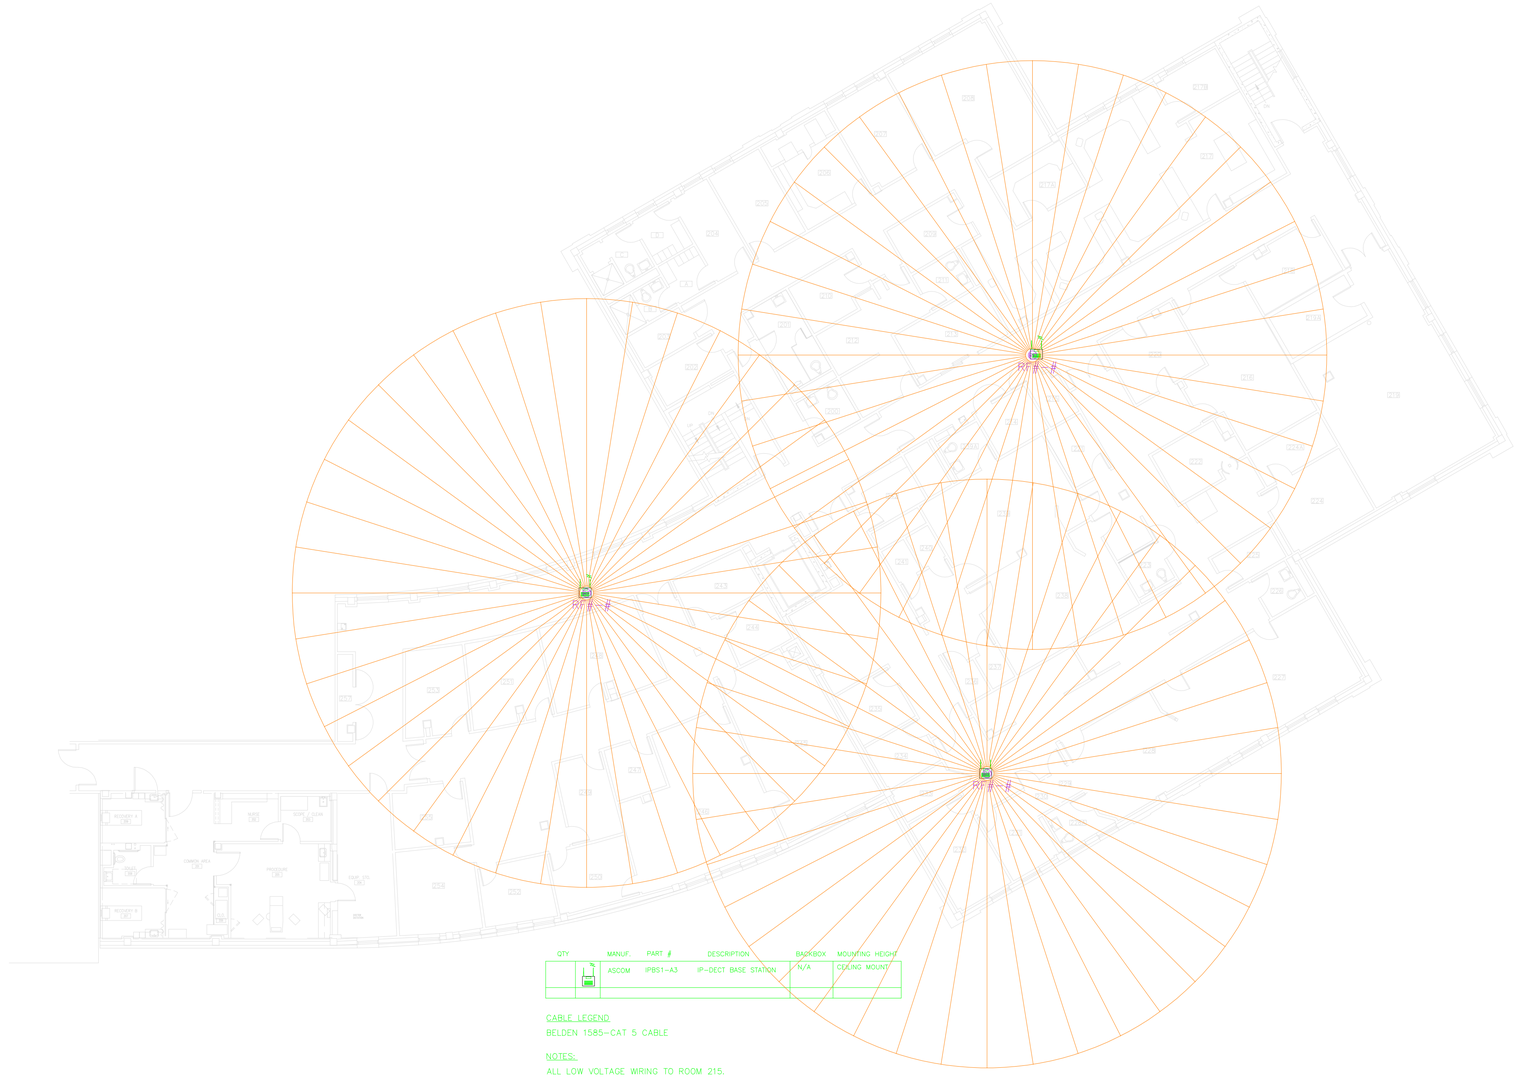

QTY		MANUF.	PART #	DESCRIPTION	BACKBOX	MOUNTING HEIGHT
1		ASCOM	IPBS1-A3	IP-DECT BASE STATION	N/A	CEILING MOUNT

CABLE LEGEND

BELDEN 1585-CAT 5 CABLE

NOTES:

ALL LOW VOLTAGE WIRING TO ROOM 215.

1 BUILDING 71N ASCOM FLOOR PLAN

1/8"=1'

Beacon
Value. Integrity. Service.

4242 Delaware Street
Denver, CO 80216
303-750-6500

www.beaconcom.com

Key Plan:

VA MEDICAL CENTER

BUILDING 71N RAD & ENDO

SHERIDAN, WYOMING

RESPONDER IV NURSE CALL SYSTEM

Job No.

Approved:

Date:

Drawn: Mike Clute

Issue Record:

Submittal Date: 9/17/2009

Revision: A Date: 6/21/10
ASBUILT

Revision: Date:

Revision: Date:

Contents:

SECOND FLOOR
ASCOM
BLDG 71N
AS 1.23