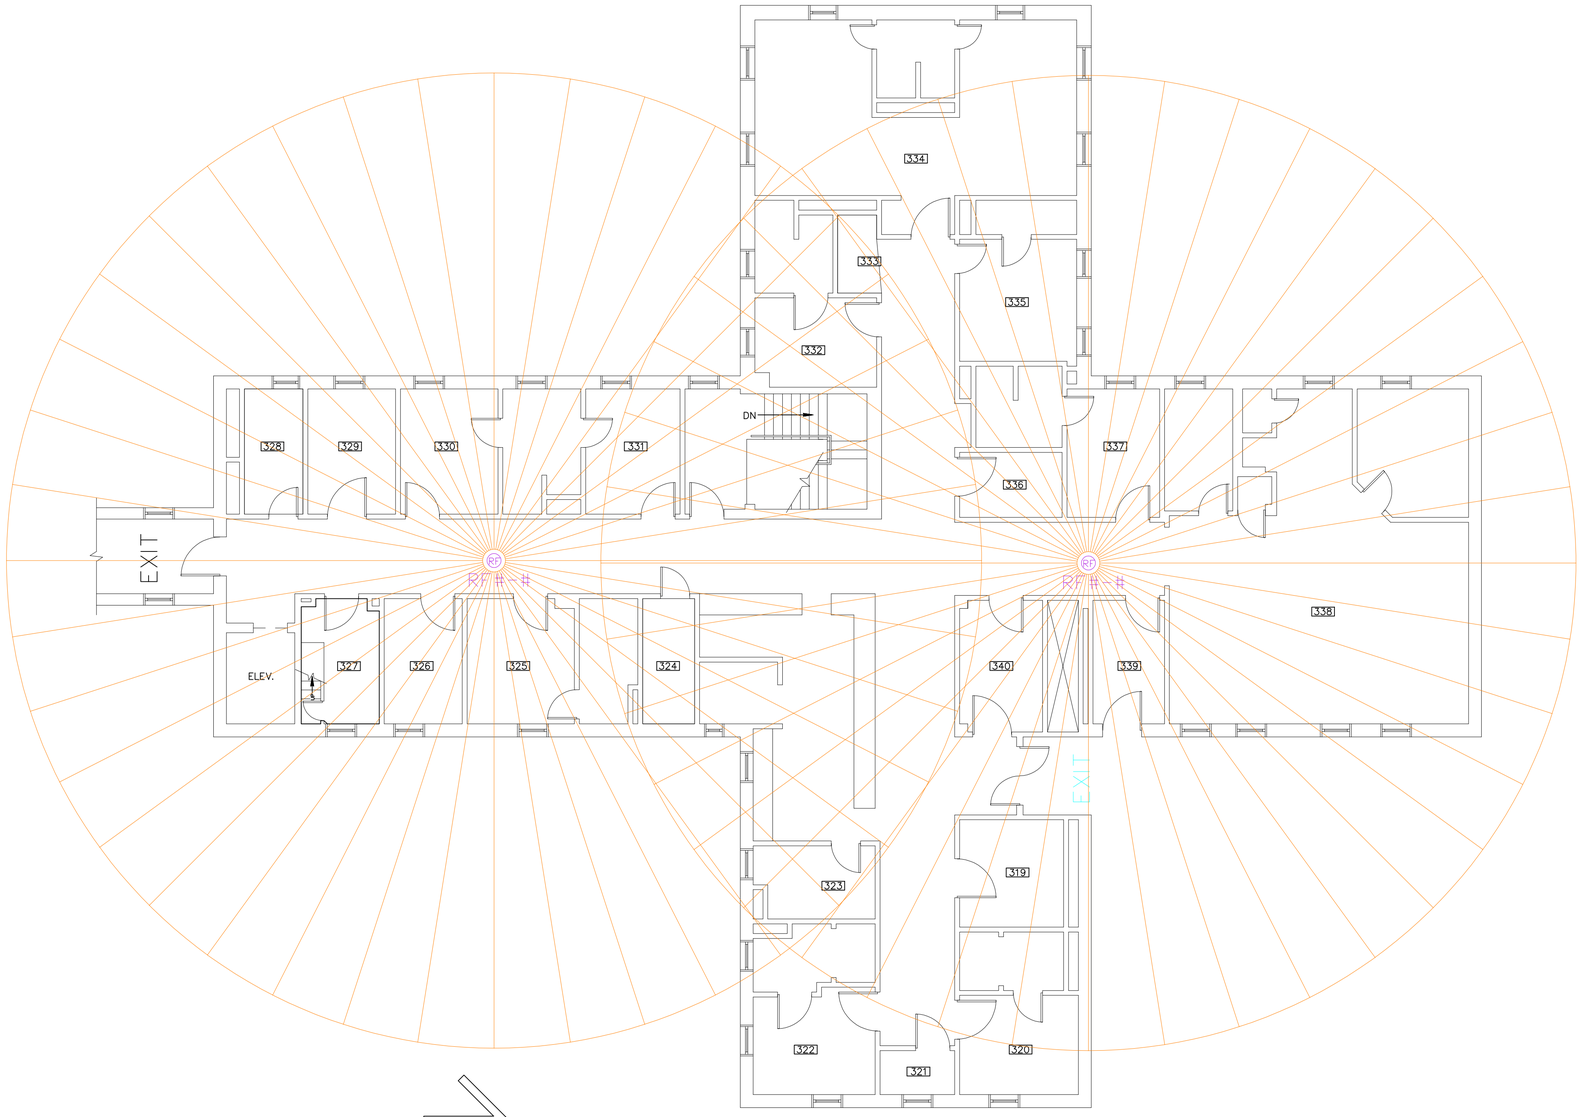

NORTH

SECOND FLOOR PLAN – BLDG.#71S

1 ASCOM BUILDING 71S SECOND FLOOR PLAN

1/8"=1'

Beacon
Value. Integrity. Service.
4242 Delaware Street
Denver, CO 80216
303-750-6500
www.beaconcom.com

Key Plan:

VA MEDICAL CENTER
BUILDING 71S MED/SURG
SHERIDAN, WYOMING

RESPONDER IV NURSE CALL SYSTEM

Job No.

Approved:

Date:

Drawn: Mike Clute

Issue Record:

Submittal Date: 9/17/2009

Revision: A Date: 8/21/10
ASBUILT

Revision: Date:

Revision: Date:

Contents:

SECOND FLOOR
TRACER
BLDG 71S
TR 1.26

S:_2008 Proposed Jobs\Healthcare\VA Medical Center-Sheridan WY\Drawings\Beacon\71S 2nd Floor Block Plan2000.dwg, 6/22/2010 7:59:00 AM, DWG to PDF.pc3