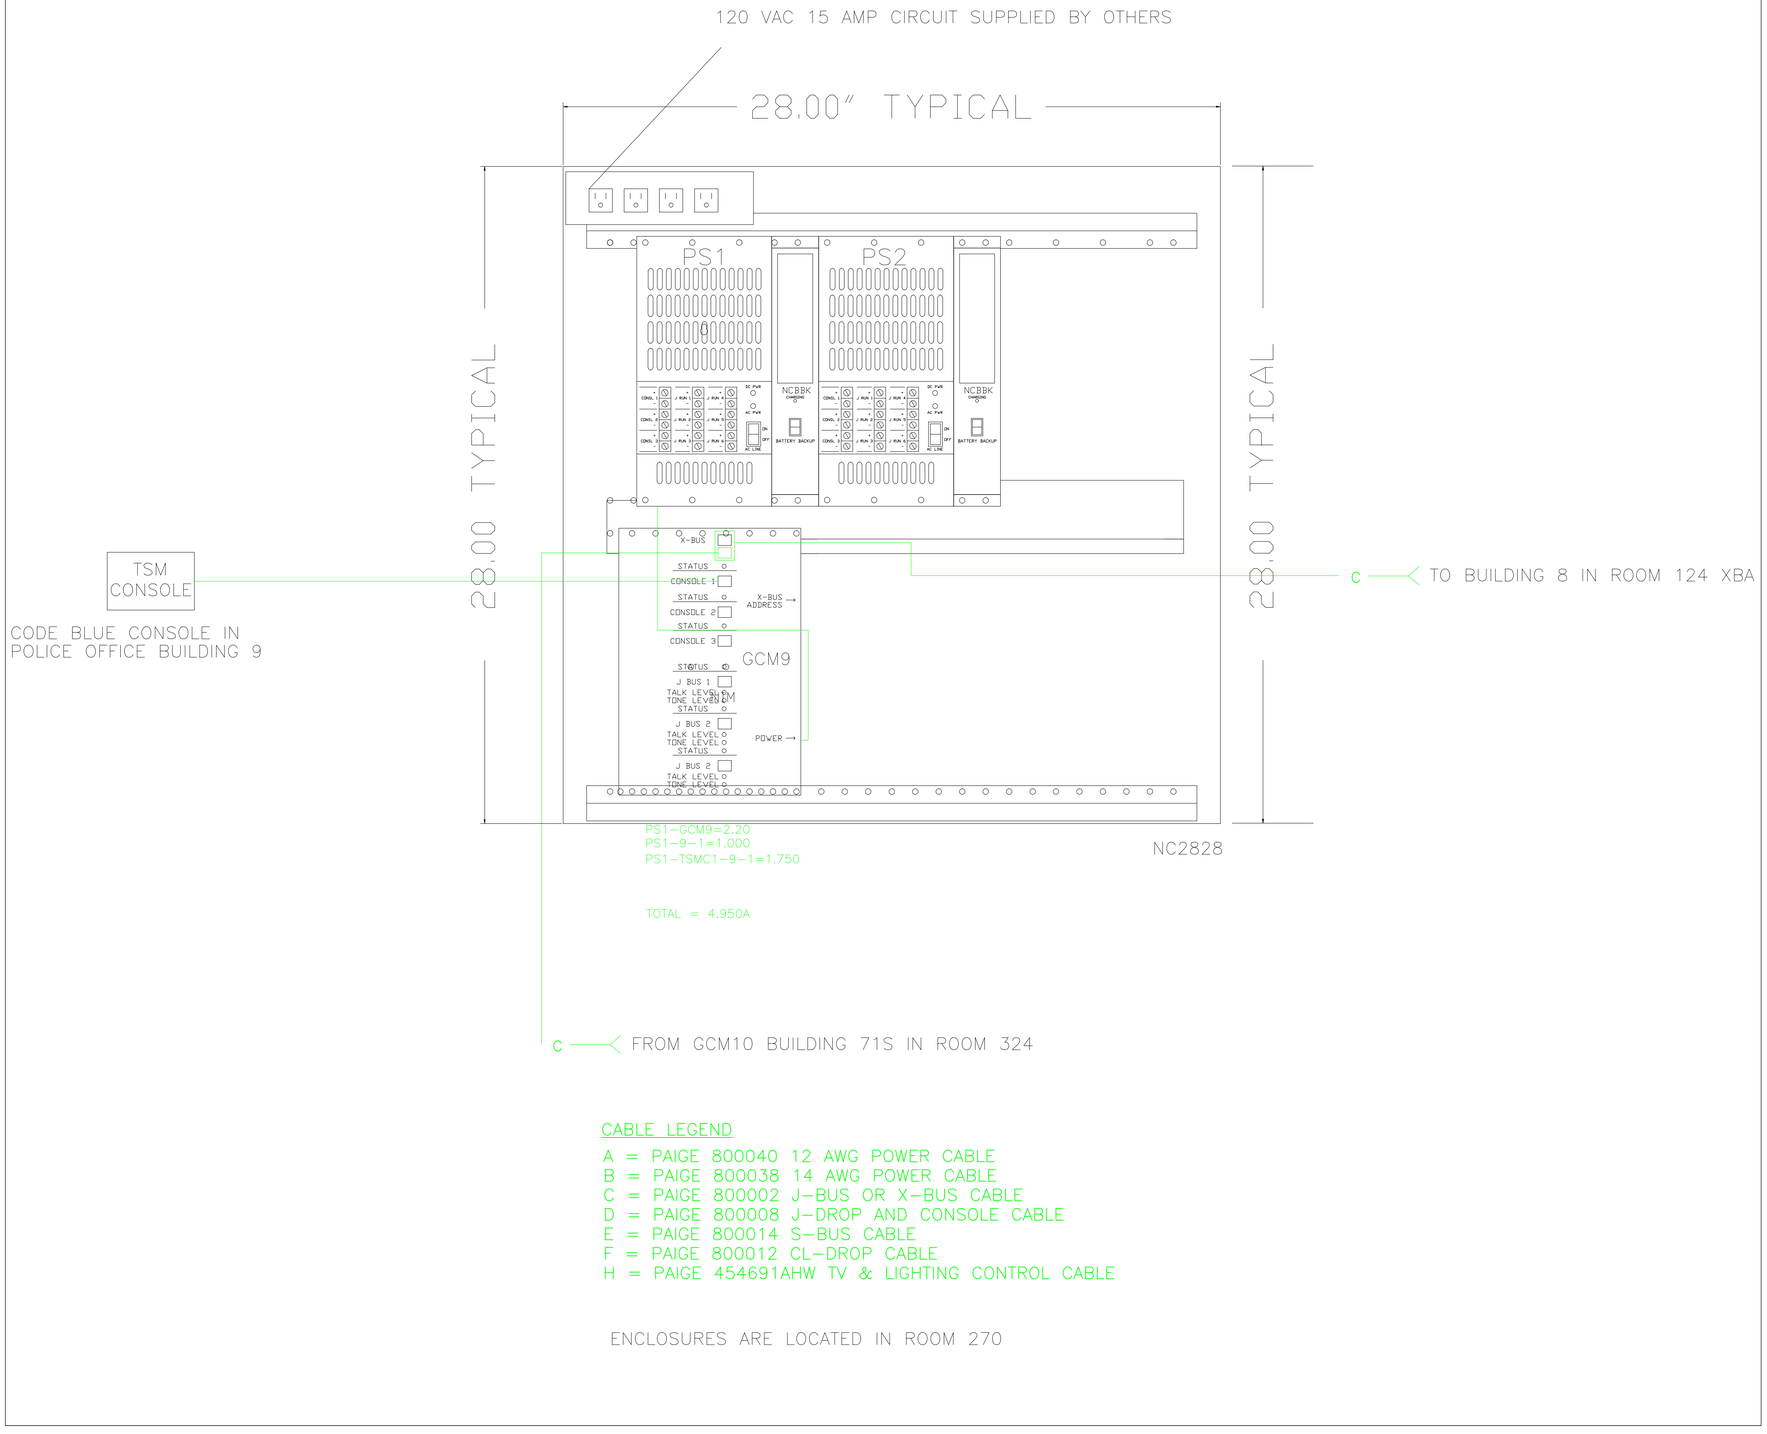

CABLE LEGEND

A = PAIGE 800040 12 AWG POWER CABLE
B = PAIGE 800038 14 AWG POWER CABLE
C = PAIGE 800002 J-BUS OR X-BUS CABLE
D = PAIGE 800008 J-DROP AND CONSOLE CABLE
E = PAIGE 800014 S-BUS CABLE
F = PAIGE 800012 CL-DROP CABLE
H = PAIGE 454691AHW TV & LIGHTING CONTROL CABLE

ENCLOSURES ARE LOCATED IN ROOM 270

Beacon
Value. Integrity. Service.
4242 Delaware Street
Denver, CO 80216
303-750-6500
www.beaconcom.com

Key Plan:

VA MEDICAL CENTER
BUILDING 71S WOMENS
SHERIDAN, WYOMING

RESPONDER IV NURSE CALL SYSTEM

Job No.

Approved:

Date:

Drawn: Mike Clute

Issue Record:

Submittal Date: 9/17/2009

Revision: A Date: 8/21/10
ASBUILT

Revision: Date:

Revision: Date:

Contents:

SECOND FLOOR
NURSE CALL
ENCLOSURE

NC-1.16