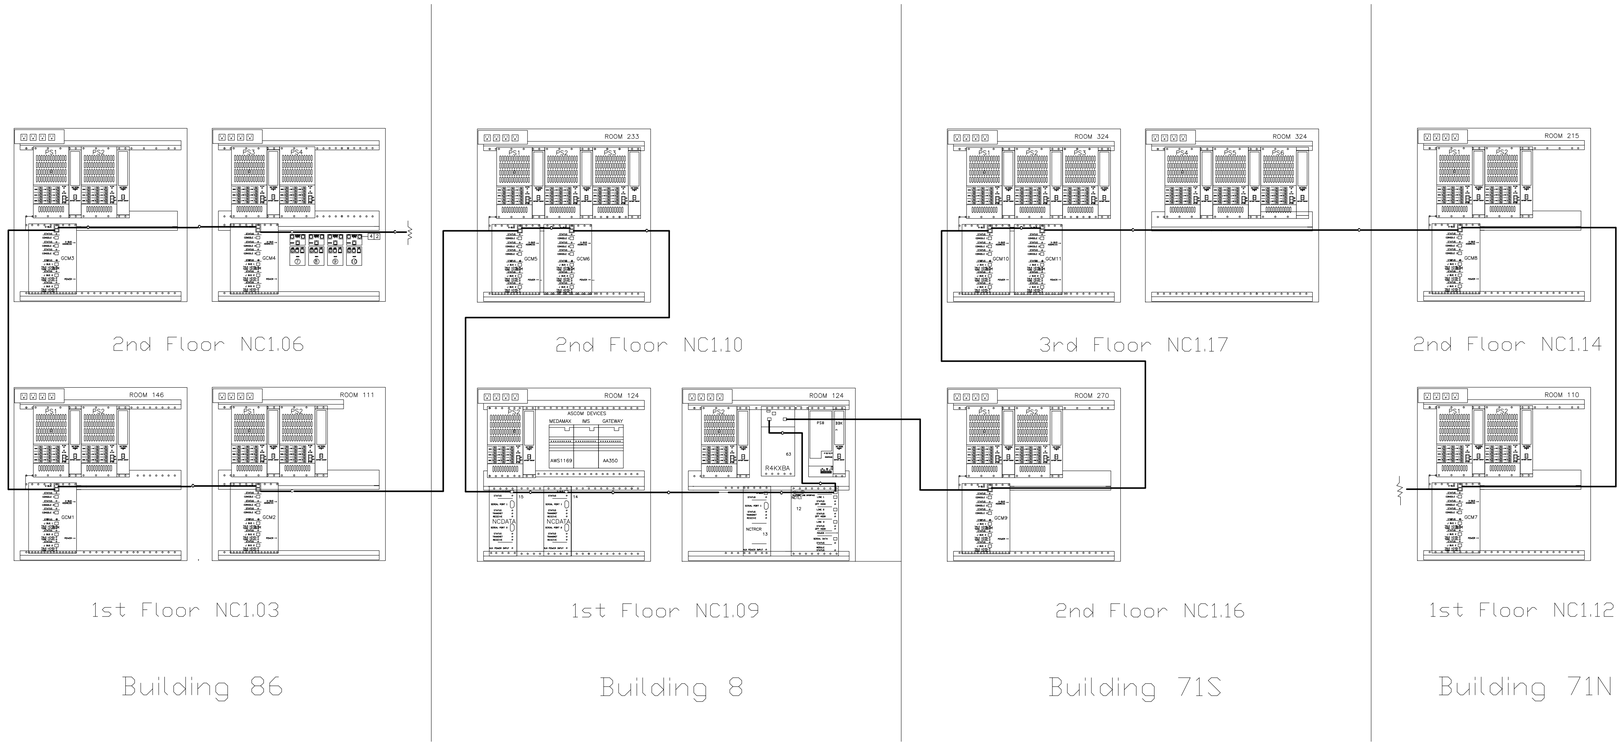

Beacon
Value. Integrity. Service.
4242 Delaware Street
Denver, CO 80216
303-750-6500
www.beaconcom.com

Key Plan:

VA MEDICAL CENTER
X-BUSS RISER
SHERIDAN, WYOMING

RESPONDER IV NURSE CALL SYSTEM

Job No.

Approved:

Date:

Drawn: Mike Clute

Issue Record:

Submittal Date: 9/17/2009

Revision: A Date: 8/21/10
ASBUILT

Revision: Date:

Revision: Date:

Contents:

X-BUSS
RISER
NC-1.18