


WORK
62

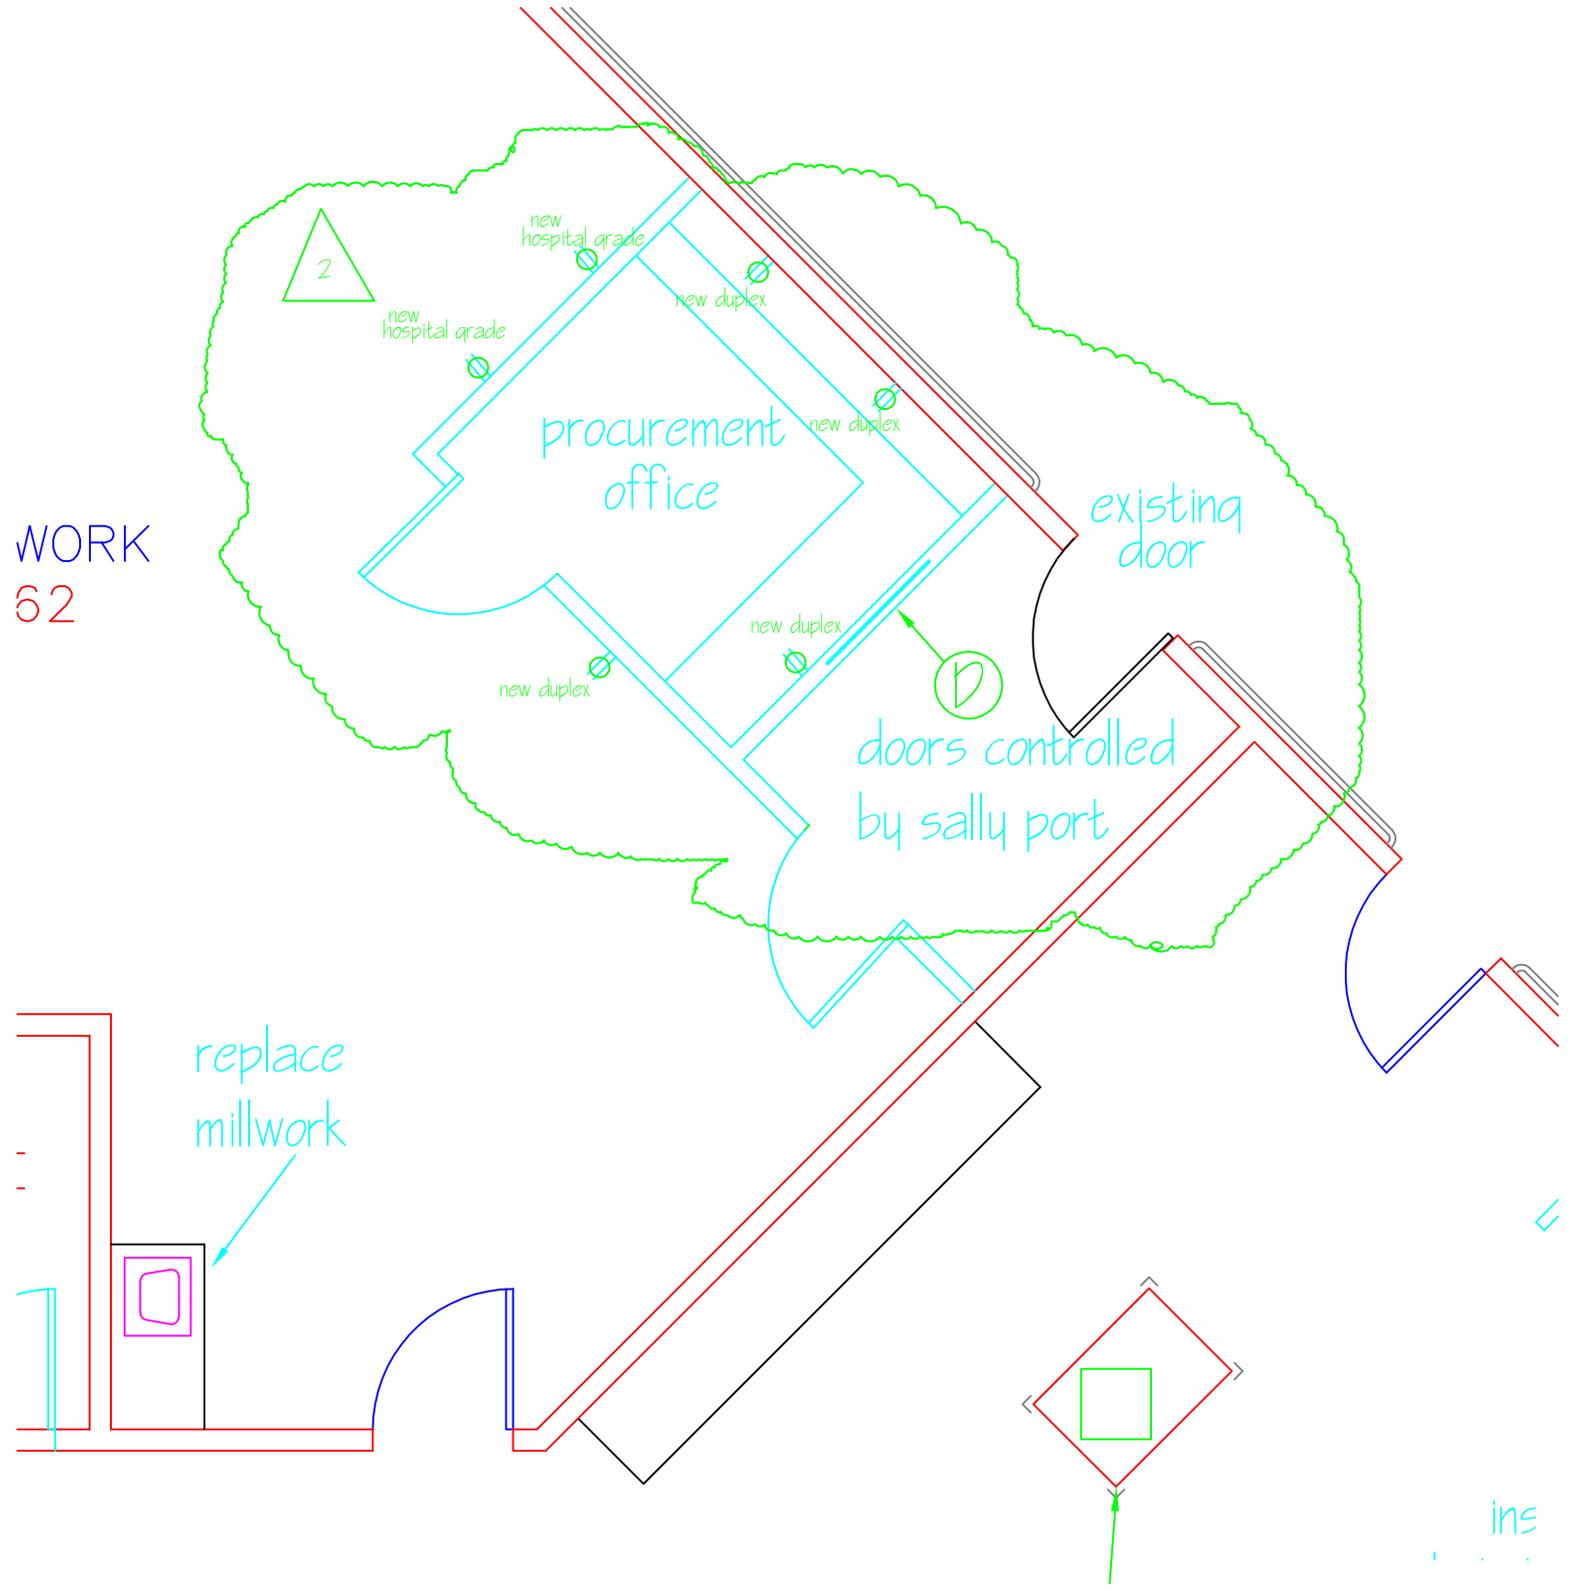

replace
millwork

existing
door

doors controlled
by sally port

ins