


VA248-13-R-0010

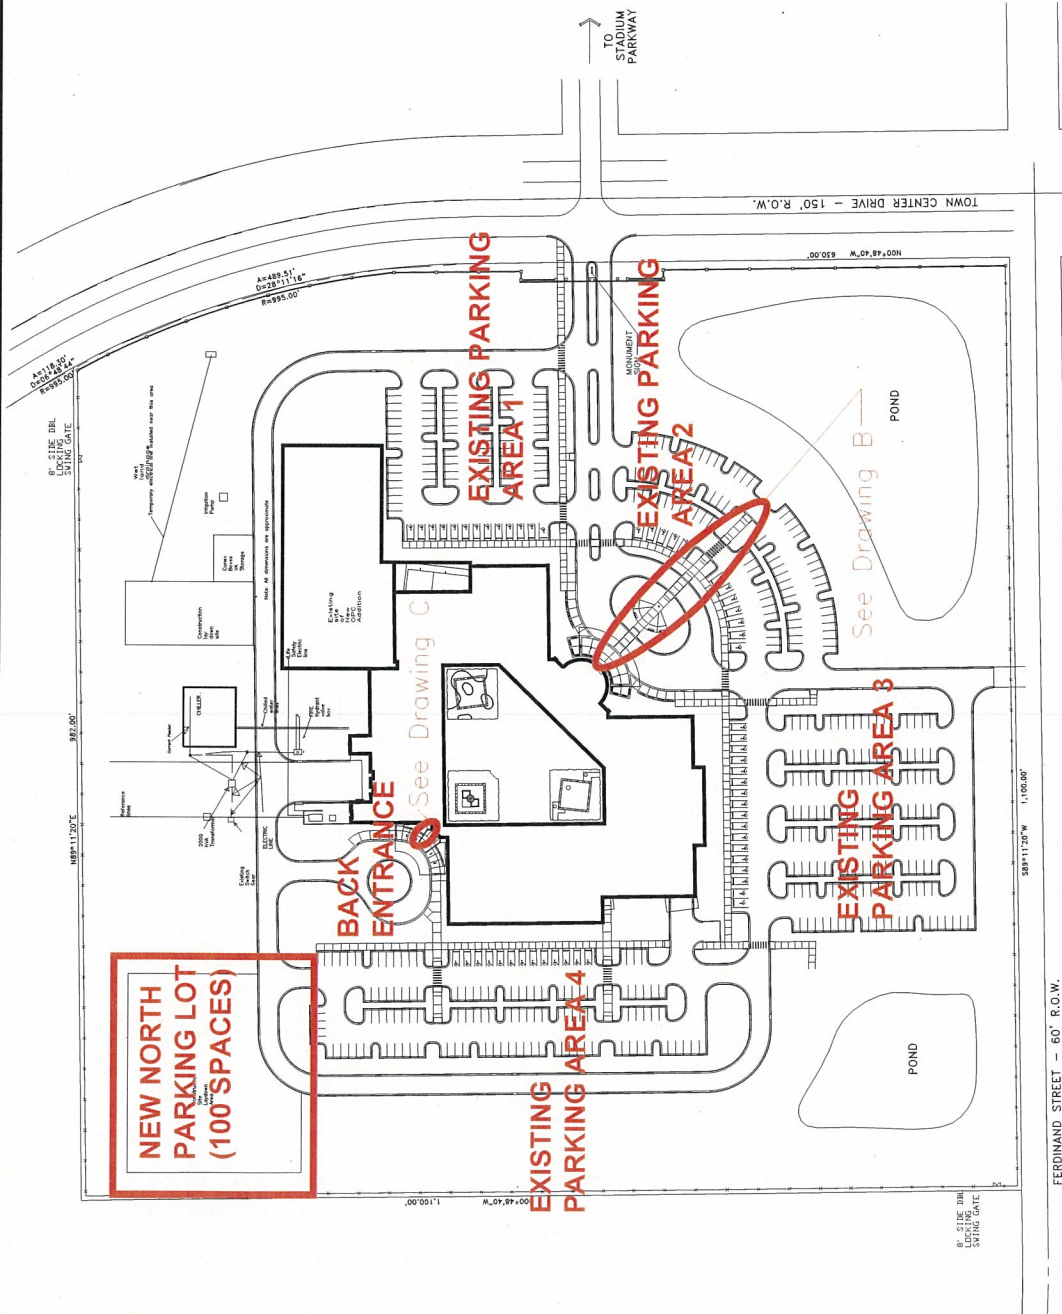

VA MEDICAL CENTER ORLANDO, FLORIDA


Pave North Parking Lot and Miscellaneous Sidwalks at Viera OPC

VHA NRM 675GA-13-150

Site Plan A



**Office of Construction &
Facilities Management**



Department of
Veterans Affairs