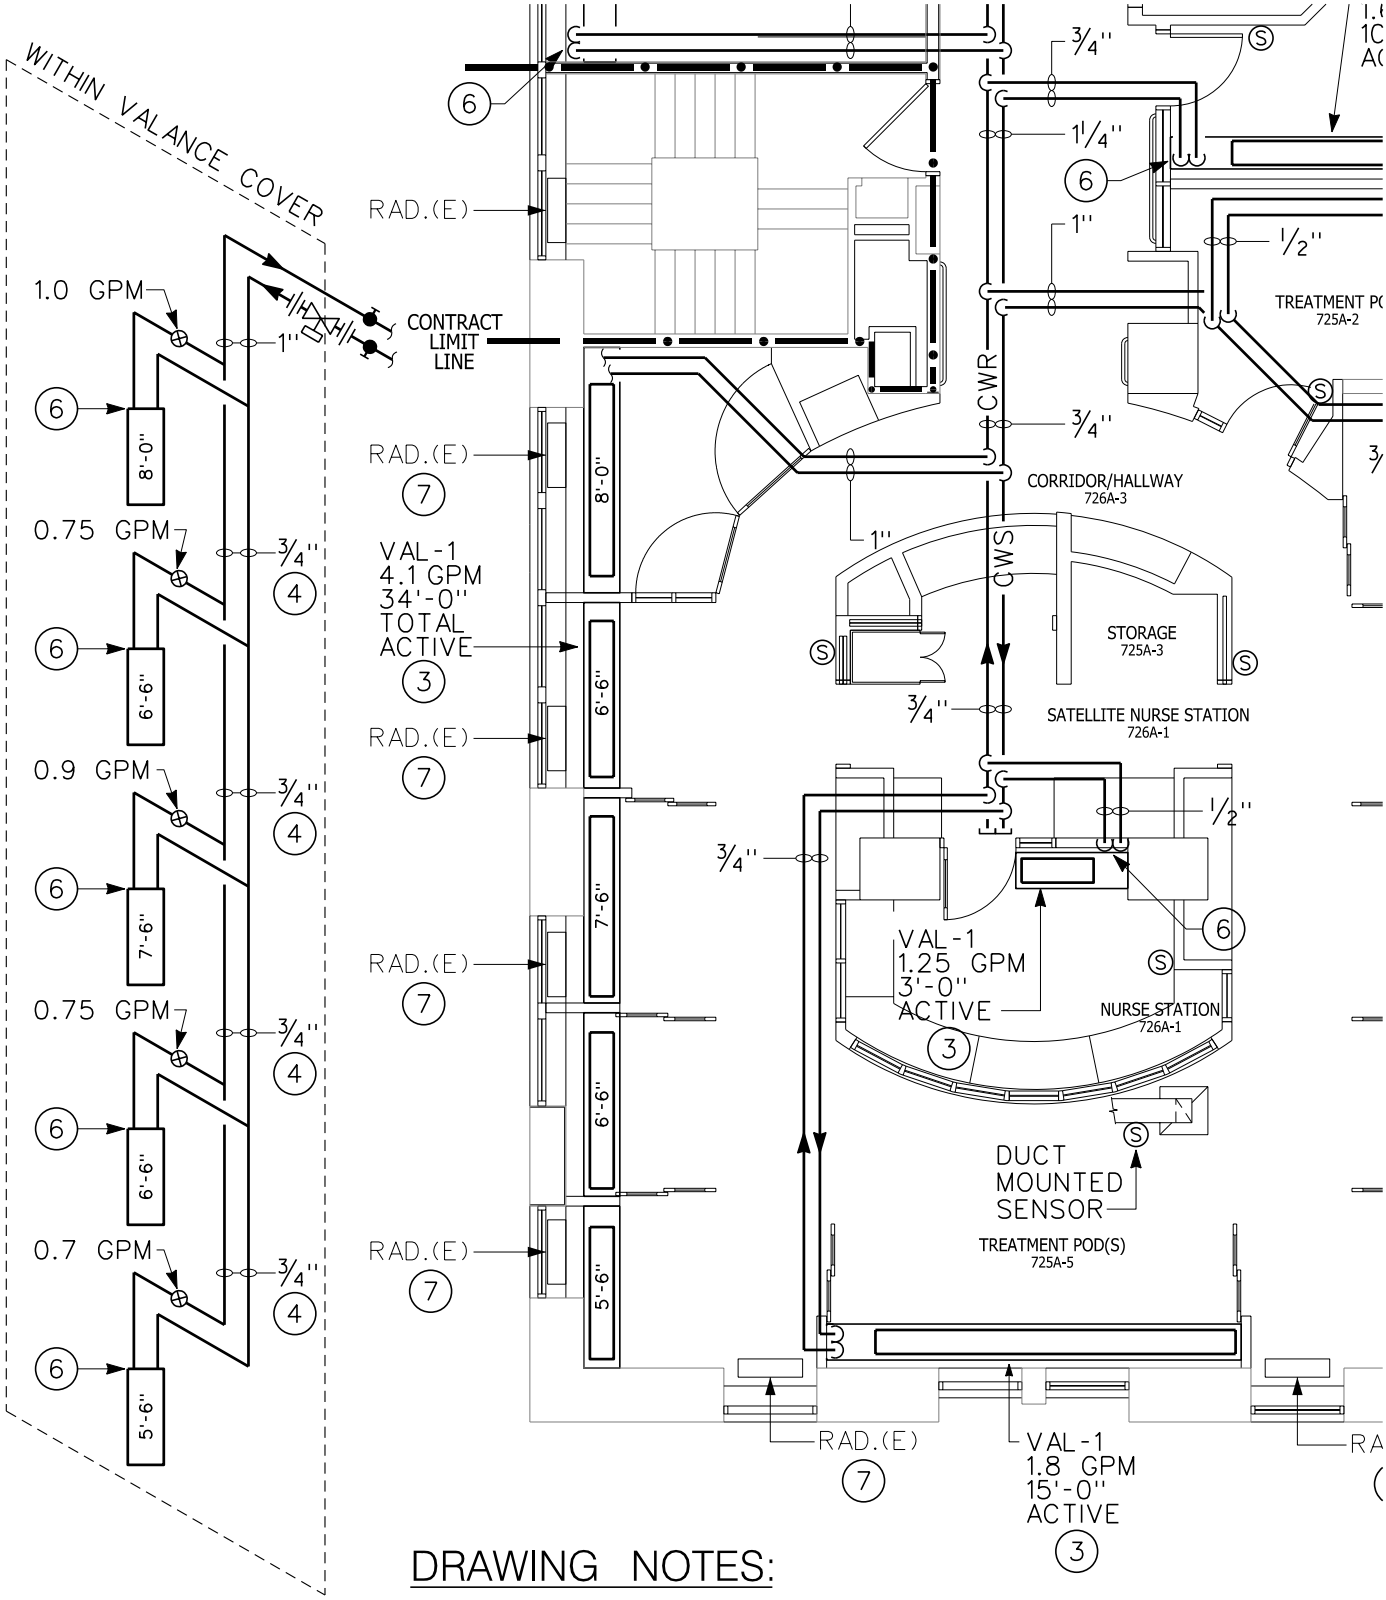

DRAWING NOTES:

FOR NOTES NOT LISTED REFER TO THE BID DOCUMENTS

(4) CONTRACTOR SHALL INSULATE PIPING THROUGH WALL PENETRATION.

IBC Engineering, P.C.
Mechanical • Electrical • Communications
Tri-Main Center
2495 Main St, Suite 318
Buffalo, NY 14214
P: 716.836.2315
F: 716.836.2319
www.ibceng.com
Industrial • Commercial
Institutional

DRAWING TITLE:	PARTIAL 7TH FLOOR PLAN		DRAWING No.: SKH-1
PROJECT NAME:	REMODEL WARD 7A - INFUSION CENTER		
PROJECT No.:	11550	DATE:	01/03/13
DRAWN BY:	JWM	CHECKED BY:	JWM