

three inches = one foot

one and one half inches = one foot

one inch = one foot


three quarters inch = one foot

one half inch = one foot

three eighths inch = one foot

one quarter inch = one foot

one eighth inch = one foot

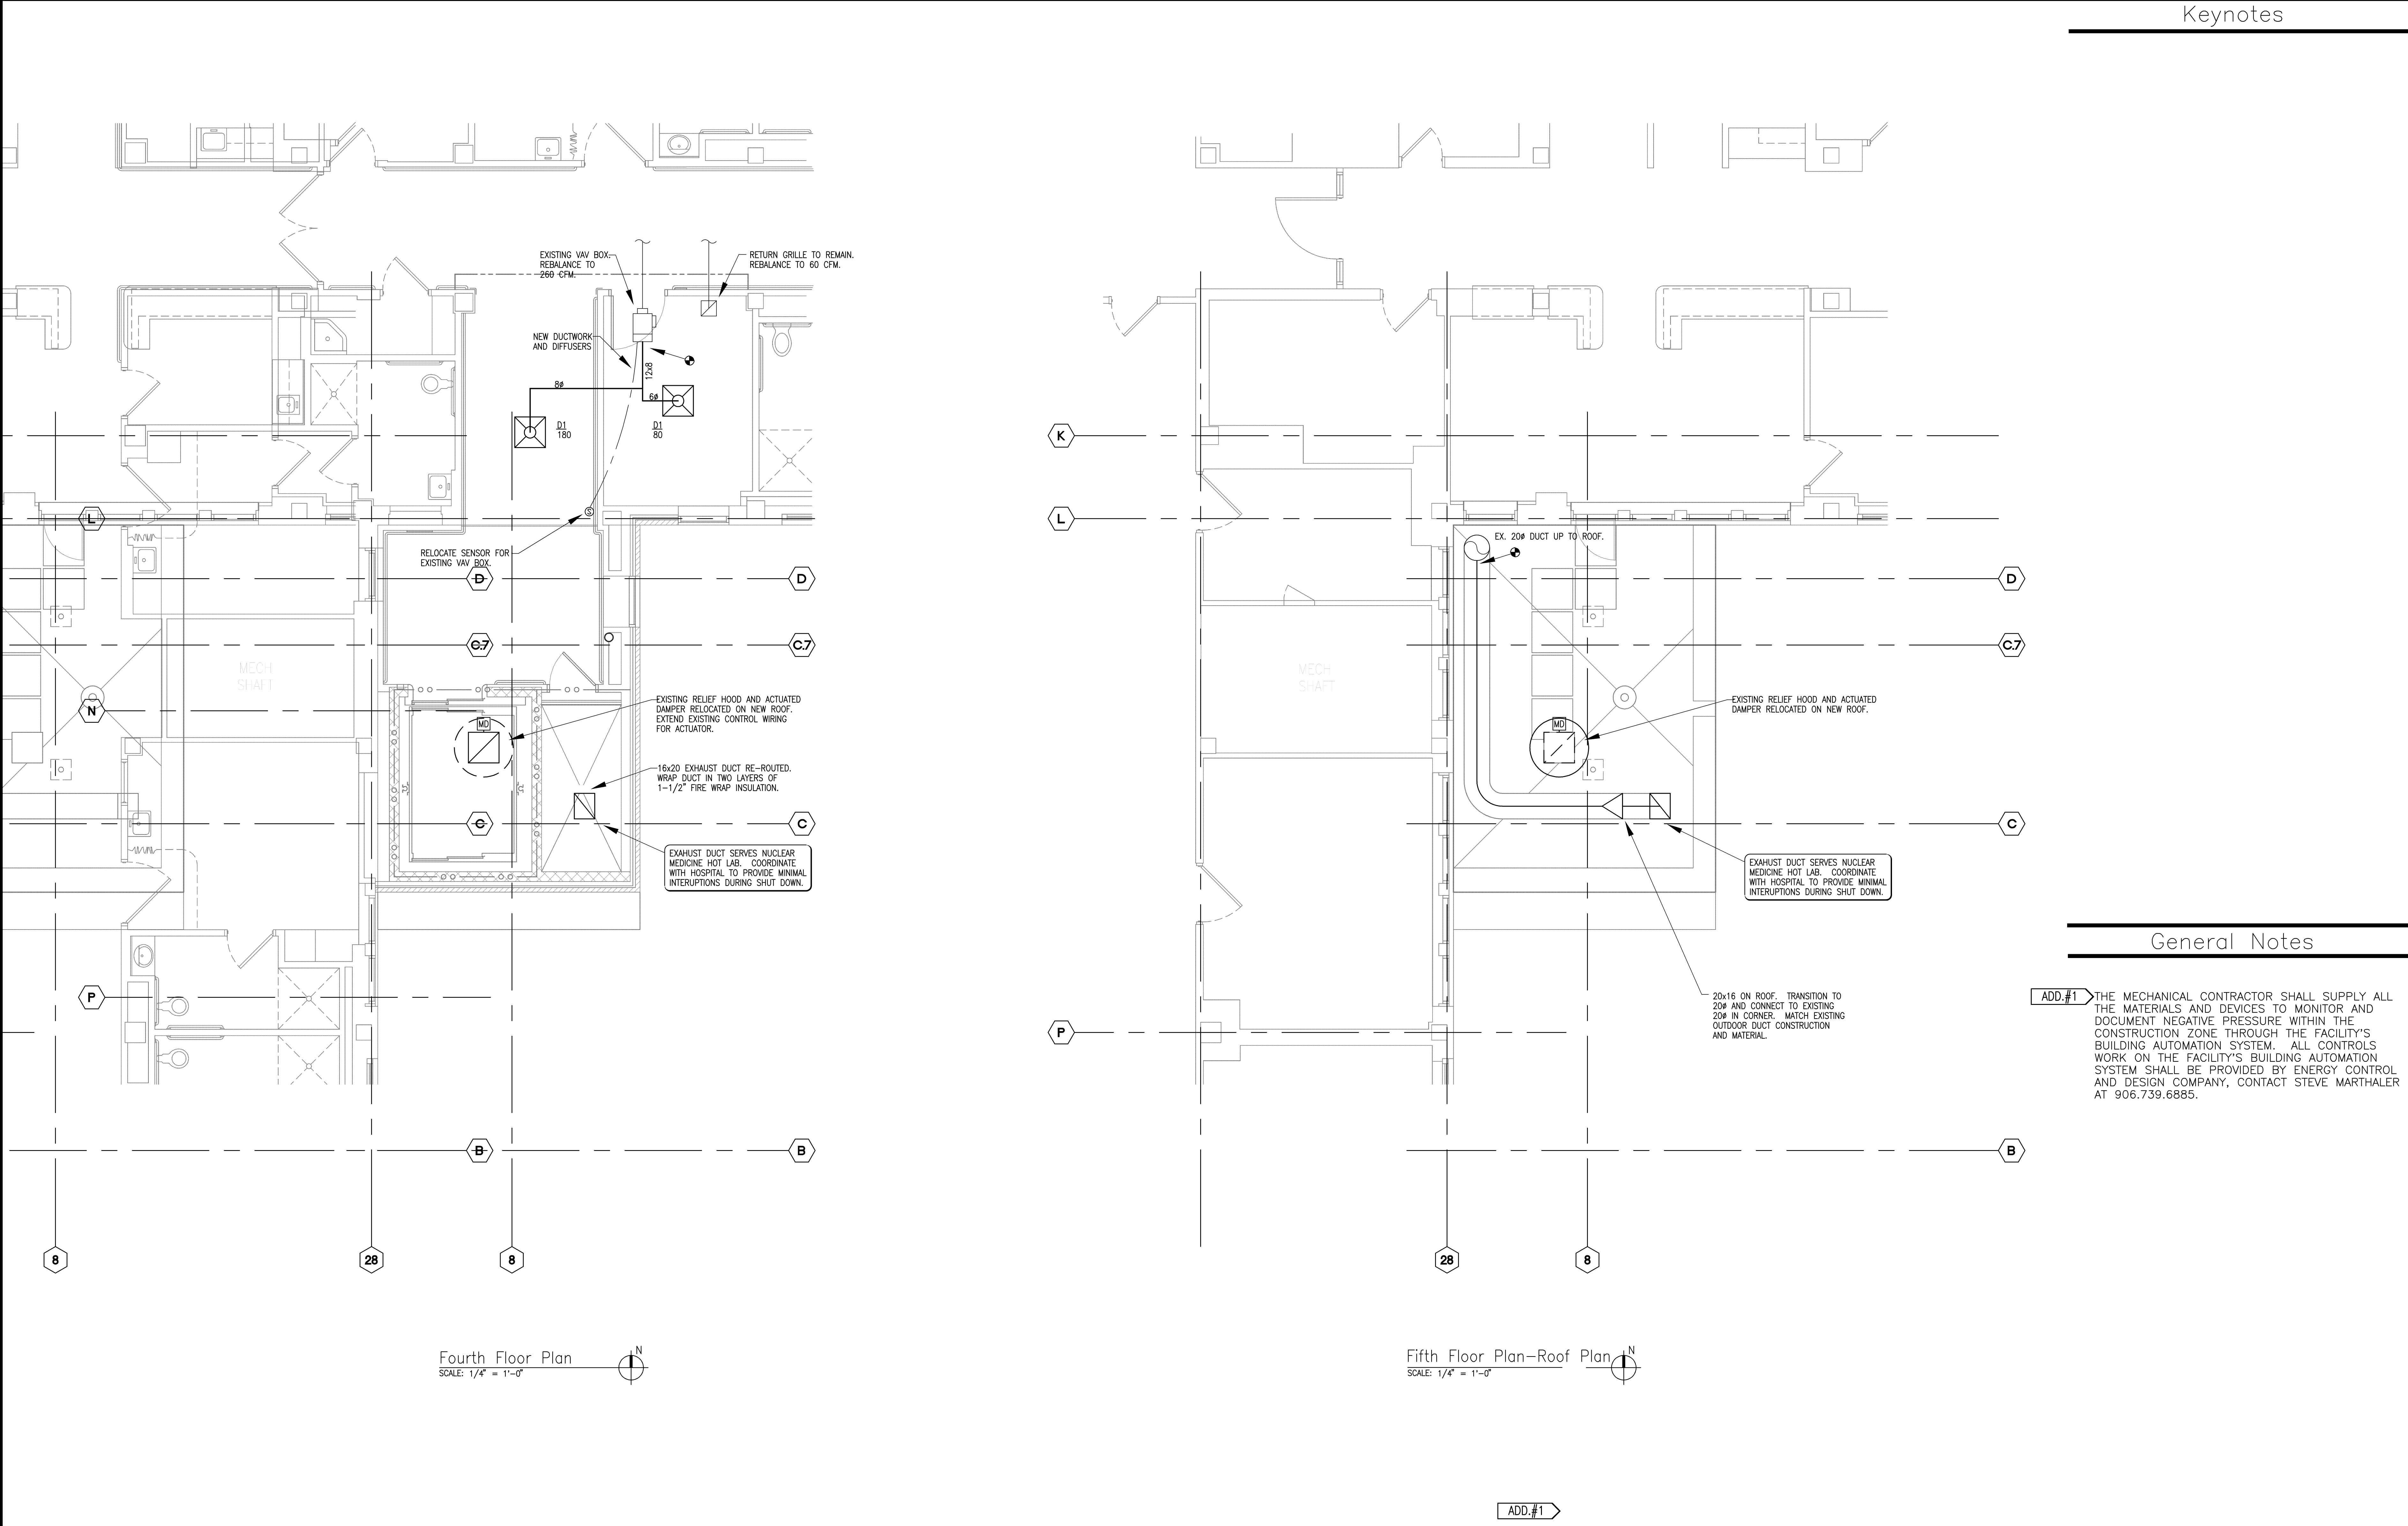

Keynotes

General Notes

ADD.#1 THE MECHANICAL CONTRACTOR SHALL SUPPLY ALL THE MATERIALS AND DEVICES TO MONITOR AND DOCUMENT NEGATIVE PRESSURE WITHIN THE CONSTRUCTION ZONE THROUGH THE FACILITY'S BUILDING AUTOMATION SYSTEM. ALL CONTROLS WORK ON THE FACILITY'S BUILDING AUTOMATION SYSTEM SHALL BE PROVIDED BY ENERGY CONTROL AND DESIGN COMPANY, CONTACT STEVE MARTHALER AT 906.739.6885.

	CONSULTANTS:		ARCHITECT/ENGINEERS:		Drawing Title Elevator Plans Fourth and Fifth Floor	Project Number 585-12-102	Project Title Renovate and Extend Elevator	Building Number 1	Office of Construction and Facilities Management							
										Approved: Project Director	Location IRON MOUNTAIN, MICHIGAN	Drawing Number M102				
													Date -	Checked -	Drawn TVW	
																Dwg. 29 of 42