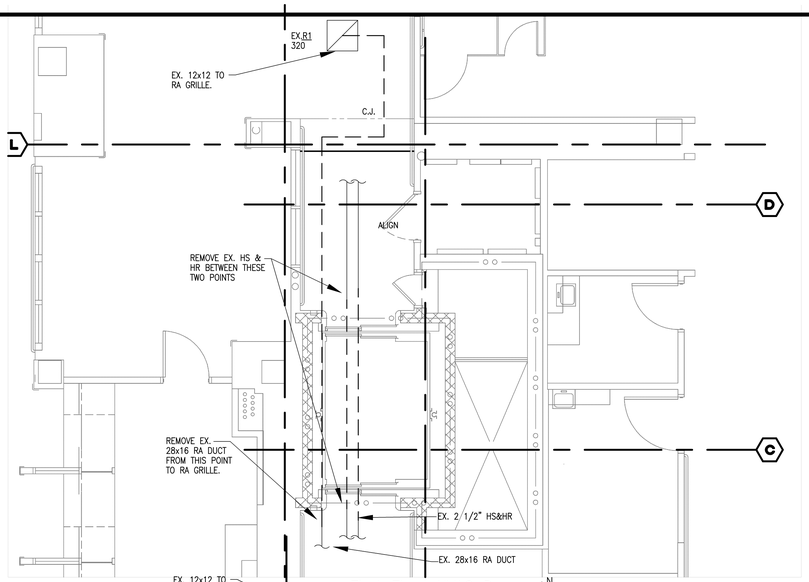

First Floor HVAC Demo
SCALE: 1/4" = 1'-0"

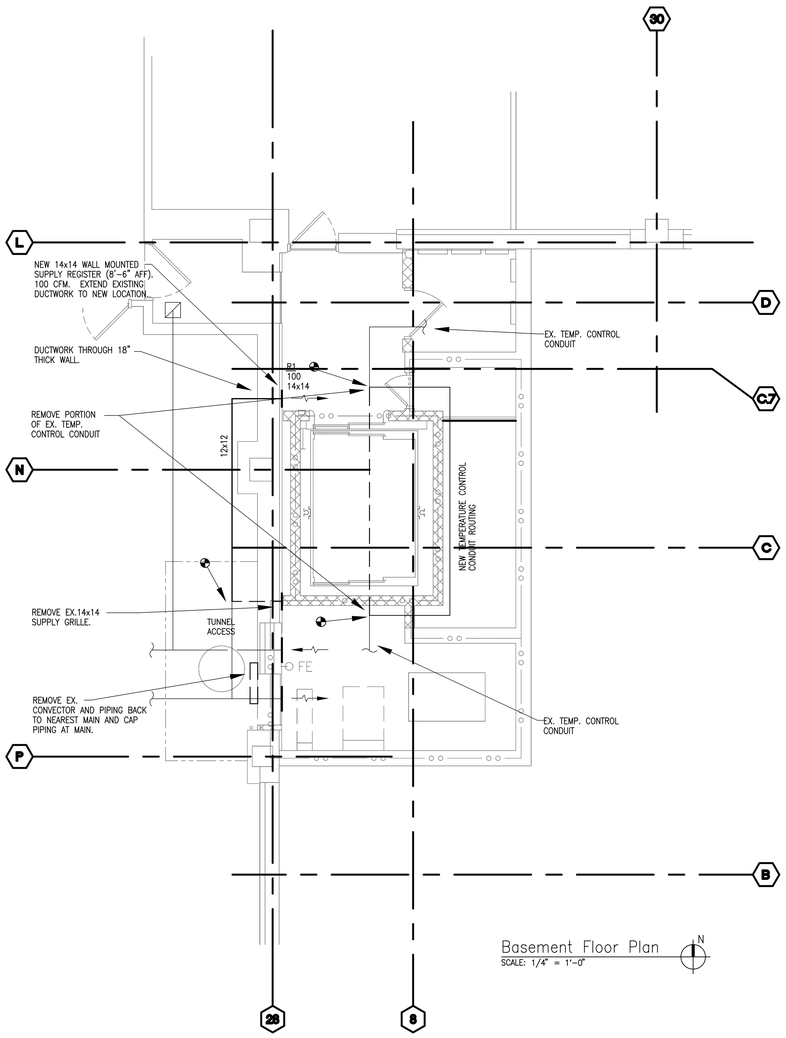

Basement Floor Plan
SCALE: 1/4" = 1'-0"

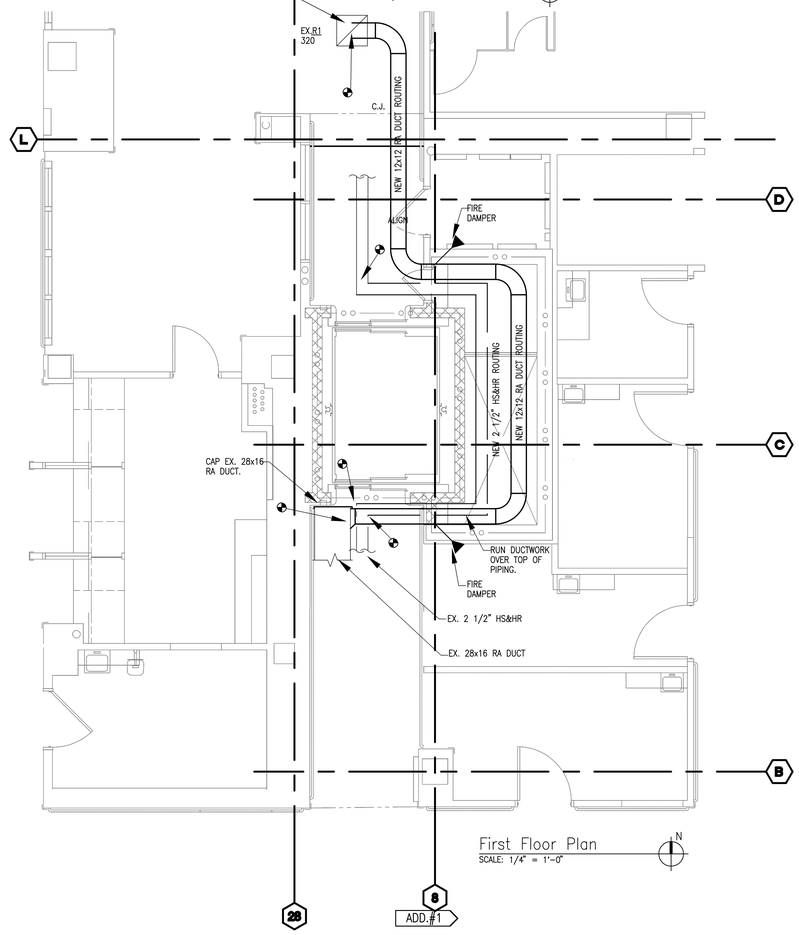

First Floor Plan
SCALE: 1/4" = 1'-0"

Keynotes

General Notes

ADD.#1 THE MECHANICAL CONTRACTOR SHALL SUPPLY ALL THE MATERIALS AND DEVICES TO MONITOR AND DOCUMENT NEGATIVE PRESSURE WITHIN THE CONSTRUCTION ZONE THROUGH THE FACILITY'S BUILDING AUTOMATION SYSTEM. ALL CONTROLS WORK ON THE FACILITY'S BUILDING AUTOMATION SYSTEM SHALL BE PROVIDED BY ENERGY CONTROL AND DESIGN COMPANY, CONTACT STEVE MARTHALER AT 906.739.6885.

Revisions	Date
---	---
---	---
---	---
---	---
---	---
ADDENDUM 1	1-4-2013
100% CONSTRUCTION DOCUMENTS	11-15-2012
95% CONSTRUCTION DOCUMENTS	8-15-2012
50% CONSTRUCTION DOCUMENTS	7-25-2012

CONSULTANTS:

URS
3950 SPARKS DRIVE SE
GRAND RAPIDS, MI 49546
PHONE: 616-574-8500
FAX: 616-574-8542

ARCHITECT/ENGINEERS:

NORTHERN DESIGN WORKS
420 RAIL STREET
NEGAUNEE, MI 49866
PHONE: 906-475-6616
FAX: 906-475-6954
NDW PROJECT NUMBER: 102

Drawing Title: Elevator Plans Basement and First Floor

Approved Project Director:

Project Title: Renovate and Extend Elevator

Location: IRON MOUNTAIN, MICHIGAN

Date: -

Checked: -

Drawn: TVW

Project Number: 585-12-102

Building Number: 1

Drawing Number: M100

Dwg. 27 of 42

Office of Construction and Facilities Management

Department of Veterans Affairs