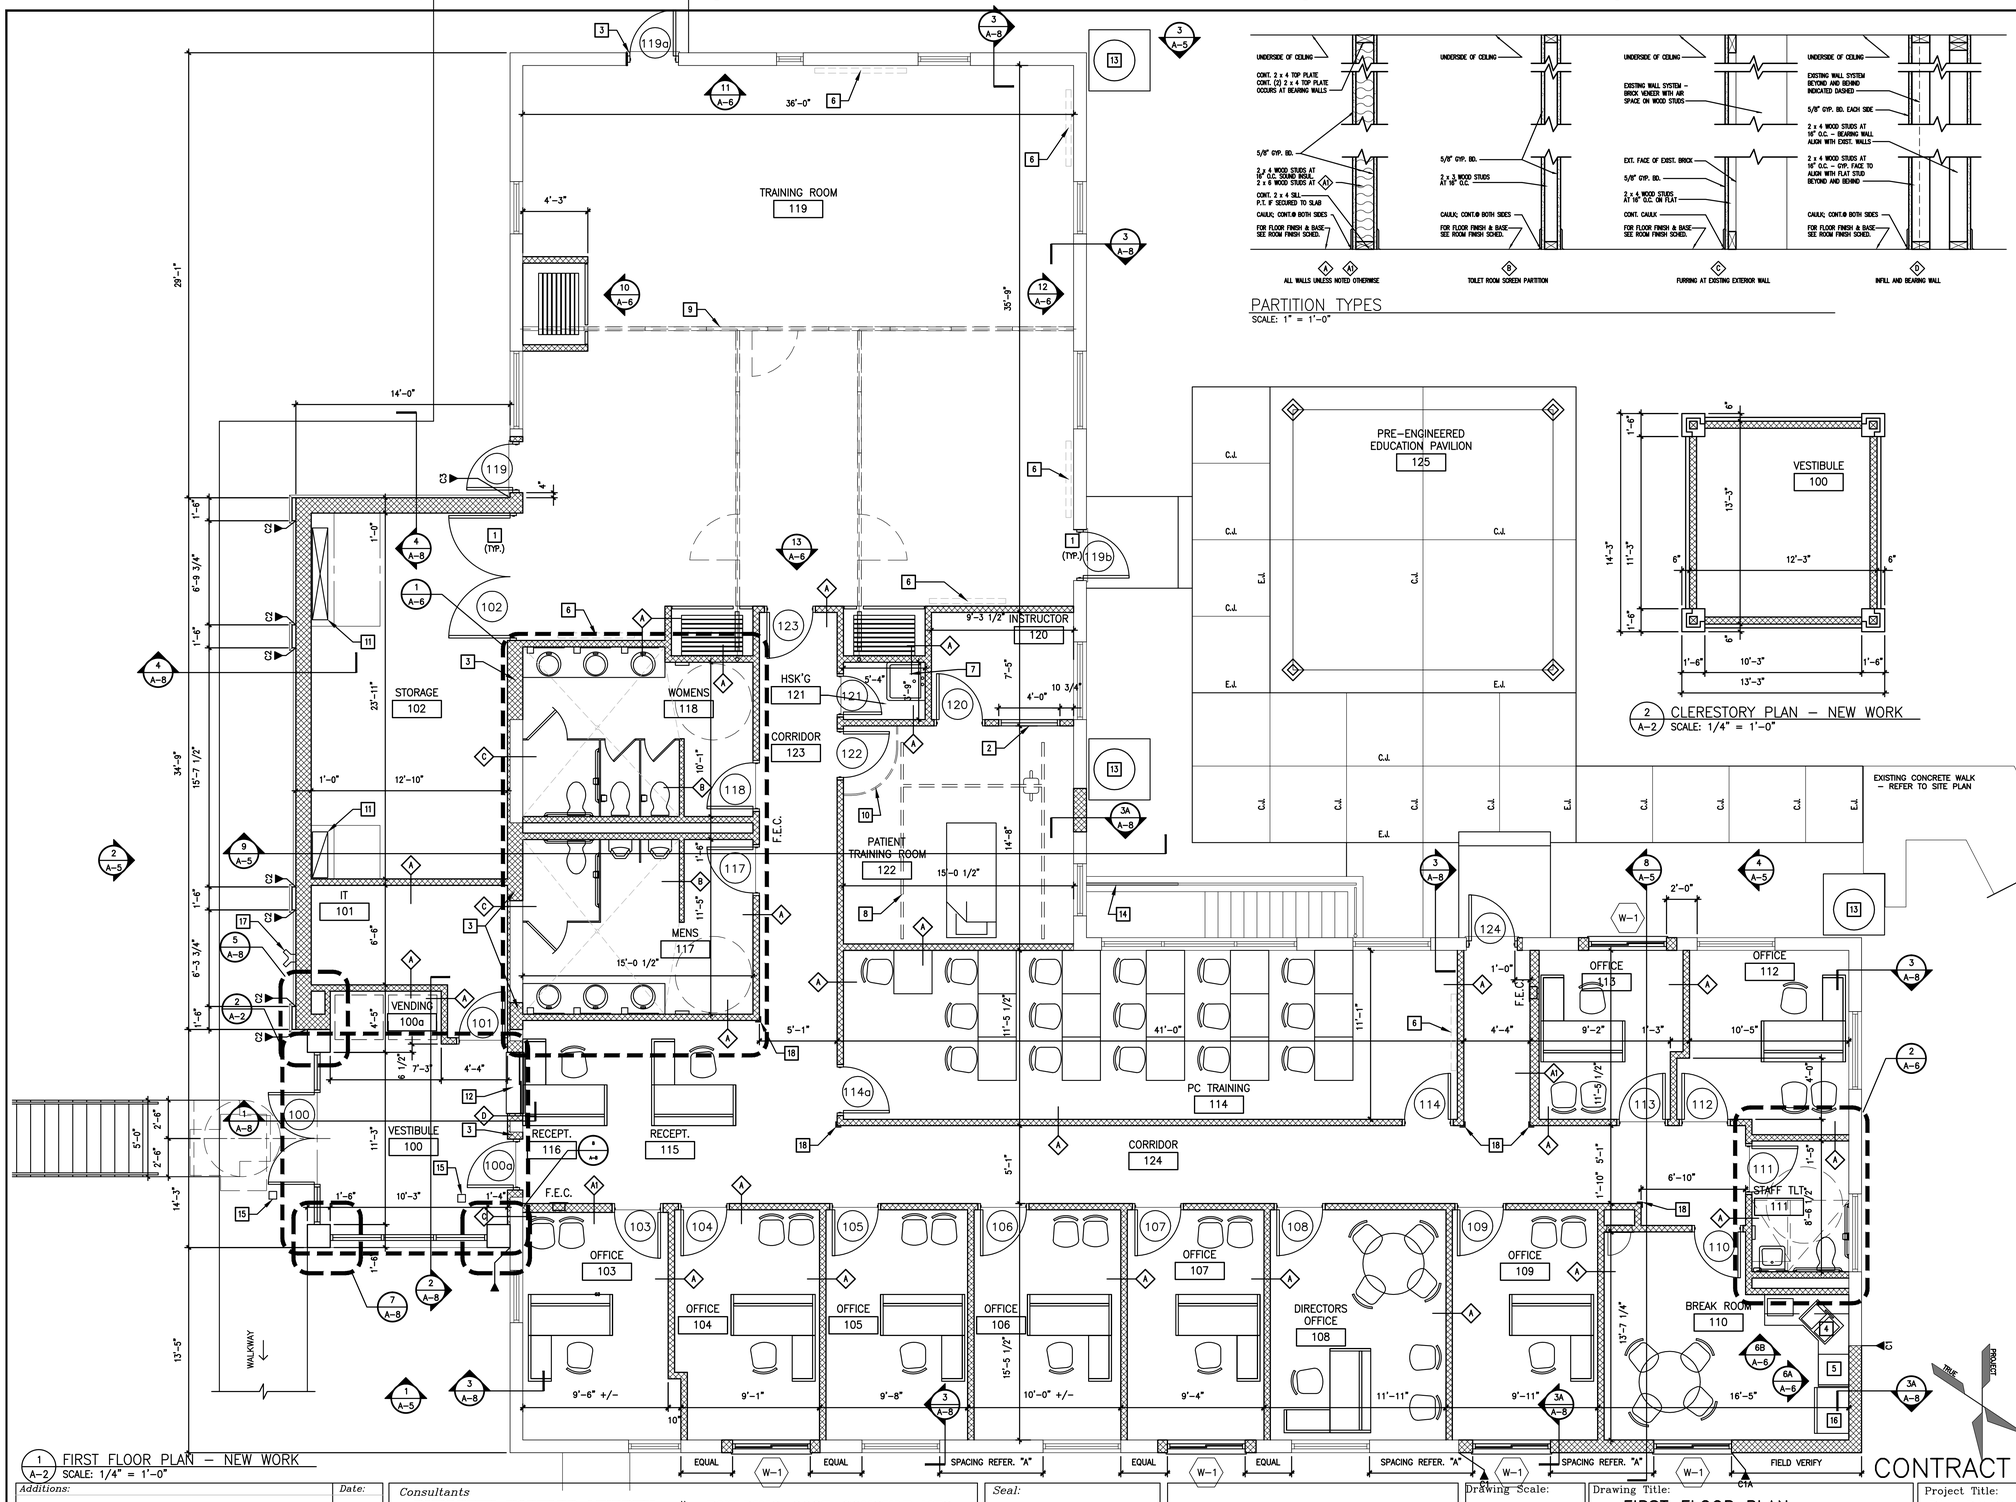

1 / A-2 FIRST FLOOR PLAN – NEW WORK
SCALE: 1/4" = 1'-0"

PARTITION TYPES
SCALE: 1" = 1'-0"

2 / A-2 CLERESTORY PLAN – NEW WORK
SCALE: 1/4" = 1'-0"

NEW WORK NOTES

1. NEW DOOR, FRAME AND HARDWARE
2. WINDOW WITH ONE WAY GLASS
3. INFILL NEW WALL (TO MATCH EXISTING WALL THICKNESS) – REFER TO PART. TYPE "D"
4. NEW SINK
5. NEW CASEWORK – REFER TO SHEET A-6 FOR ADDITIONAL INFORMATION
6. SMART BOARD SUPPLIED AND INSTALLED BY VA
7. FLOOR MOP SINK
8. PATIENT SAFE HANDLING LIFT
9. OPERABLE ELECTRIC FOLDING PARTITION
10. CUBICLE CURTAIN TRACK
11. DUCTWORK ABOVE – SEE TO MECHANICAL DRAWINGS FOR ADDITIONAL INFORMATION. FUR OUT AS TIGHT TO DUCTWORK AS POSSIBLE WITH 5/8" GYP. BD. ON 2 x 4 WOOD STUDS AT 16" O.C. – FIELD VERIFY EXACT EXTENT. PROVIDE CORNER GUARD PROTECTION ALL ALL EXPOSED EDGES.
12. SLIDING PASS-THRU SECURITY WINDOW (LOCKABLE)
13. RAIN BARREL ON CONCRETE PAD
14. MODIFIED RAILING SYSTEM – FIELD VERIFY EXACT EXTENT AND ALIGN WITH EXISTING
15. PEDESTAL MOUNT ADA DOOR ASSIST ACTIVATION DEVICE
16. REFRIGERATOR
17. RELOCATED FDC – REFER TO L-3 AND M5.01 FOR ADDITIONAL INFORMATION.
18. CORNER GUARD

GENERAL NOTES:

1. ALL WINDOWS SHALL BE REPLACED UNDER SEPARATE PROJECT PRIOR TO THE BEGINNING OF THIS PROJECT.
2. PROVIDE NEW R-19 BATT INSULATION AND VAPOR BARRIER AT NEW EXTERIOR WALLS. PROVIDE NEW R-15 BATT INSULATION AND VAPOR BARRIER AT NEW EXTERIOR INFILL WALLS AND EXISTING EXTERIOR WALLS.
3. PROVIDE NEW R-30 BATT INSULATION AT ROOF. PROVIDE VENT CHUTES AND INSTALL INSULATION AT UNDERSIDE VENT CHUTE.
4. WHERE FACE BRICK IS REMOVED DURING DEMOLITION, SALVAGE AS MUCH AS POSSIBLE TO BE RE-USED ON EXTERIOR NEW CONSTRUCTION AREA NEAR BREAK ROOM 110.
5. EXISTING FLOOR SYSTEM SHALL REMAIN. WHERE REMOVAL OF EXISTING FLOOR FINISHES INDICATED ON "DEMOLITION PLAN" PROVIDES AN INCONSISTENT AND NON-LEVEL FLOOR SYSTEM, CONTRACTOR SHALL PROVIDE MEANS AND METHODS WHERE TOP OF NEW SLAB, EXISTING SLAB AND EXISTING WOOD FLOOR ARE FLUSH AND LEVEL THROUGHOUT.
6. CONTROL JOINT SYMBOL INDICATED THUS: ▲ REFER TO SHEET A-5 FOR DETAILS.
7. CONCRETE WALK EXPANSION JOINT INDICATED THUS: E.J.
8. CONCRETE WALK CONTROL JOINT INDICATED THUS: C.J.

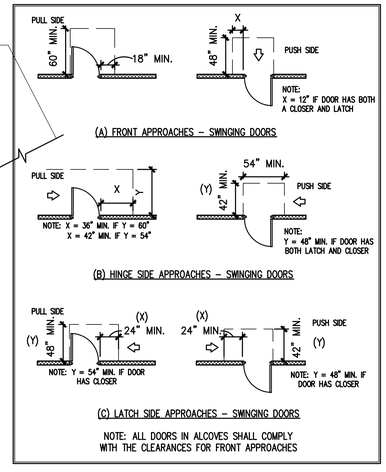

ADA DOOR CLEARANCES
SCALE: N.T.S.

LEGEND

- EXISTING WALLS TO REMAIN
- EXISTING WALLS TO BE REMOVED
- NEW WALLS
- EXISTING DOORS TO REMAIN
- EXISTING DOORS, FRAMES & ETC. TO BE REMOVED
- NEW DOOR

FULLY SPRINKLERED
CONTRACT DOCUMENTS SUBMISSION

Additions:

Revisions:

Date:

Consultants

BURDETTE KOEHLER MURPHY & ASSOCIATES, INC.
MECHANICAL / ELECTRICAL CONSULTING ENGINEERING
1423 CLARKVIEW ROAD, SUITE 500
BALTIMORE, MARYLAND 21209
410.323.0600 – FAX 410.377.2543

RICKERT ENGINEERING, INC.
STRUCTURAL ENGINEER
8813 WALTHAM WOODS RD. SUITE 310
BALTIMORE, MARYLAND 21234
410.663.5110 – FAX 410.663.5114

BUILDING COST CONSULTANTS
COST ESTIMATING
12917 – 30TH AVENUE
PLATTSMOUTH, NEBRASKA 68048
402.298.8260 – FAX 402.298.8290

CENTURY ENGINEERING, INC.
CIVIL ENGINEER
10710 GILROY ROAD
HUNT VALLEY, MARYLAND 21031
443.589.2400 – FAX 443.589.2401

Seal:

ARCHITECTURE
PLANNING
ENGINEERING

POLT DESIGN GROUP
1301 Enterprise Court, Suite 103-C 410.803.2141
Bel Air, Maryland 21014-1847 fax 410.838.1603
www.polt-design.com

Drawing Scale:
Drawing Start Date:
Drawing Finish Date:
Drawing Approved:

Drawing Title: FIRST FLOOR PLAN NEW WORK
Approved: Associate Director for Operations:
Approved: Chief, Facilites Engineer:
Approved: Director, Medical Center:

Project Title: BUILDING 5 RENOVATION
Building No: 5
Checked: CAJ
Drawn: BMH/BDA
Location: VAMHCS MEDICAL CENTER WILMINGTON, DELAWARE

Date: 6-15-2012
Project No: 460-13-111
DRAWING NO: A-2
Dwg. 13 Of 67

DEPARTMENT OF VETERANS AFFAIRS

PDG 110105.01