


TELEPHONE
CABINET
LOCATION

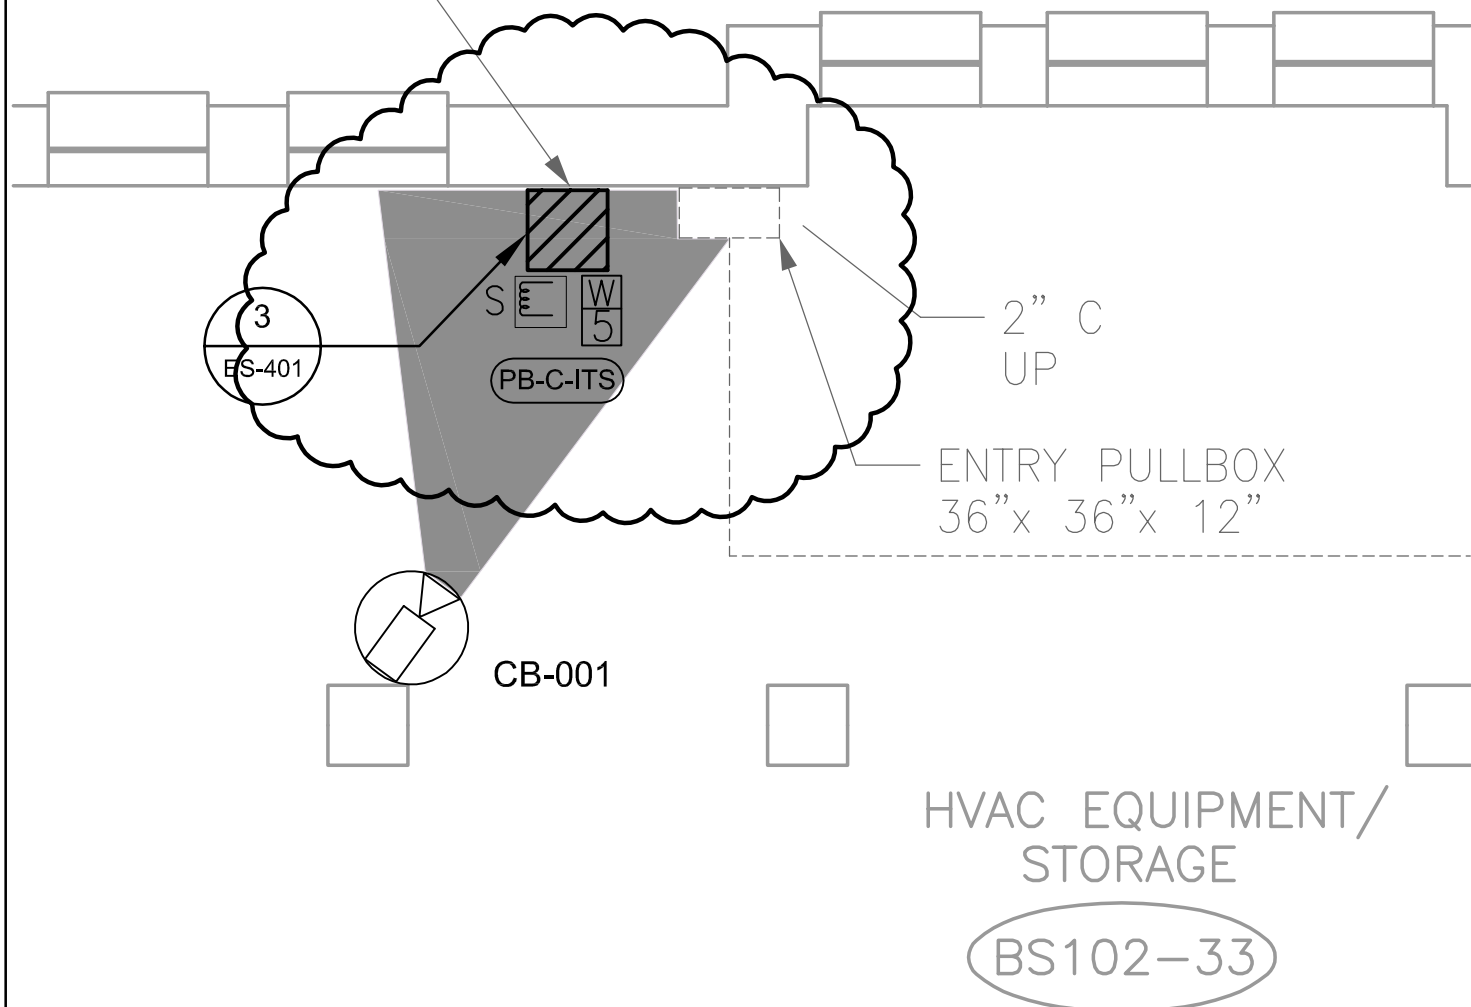

REFERENCE DRAWING 33-ES-B-02-101



**Department of
Veterans Affairs**

TOLMAN ENGINEERING
3610 LAWSON ROAD
JAMESTOWN, NY 14701
PH: 716.484.1366
www.tolmaneng.com

AJE WORKS
6587 HAMILTON AVENUE
PITTSBURGH, PA 15206
PH: 412.287.7333
www.aje-works.com

PROJECT: VA Bath Campus Security
Upgrade - Phase 2

OWNER: VETERANS AFFAIRS
MEDICAL CENTER
BATH, NY

PROJECT NO.
528A6-11-623

DRAWN BY:
AJF

CHECKED BY:
SK

SCALE:
SK

ISSUE DATE:
01/17/2013

SKETCH NO:

SK-003